


MAP #14510

13275-2097 + Deed Map
6 W.T. Mahaffey Lands
5-POINTS

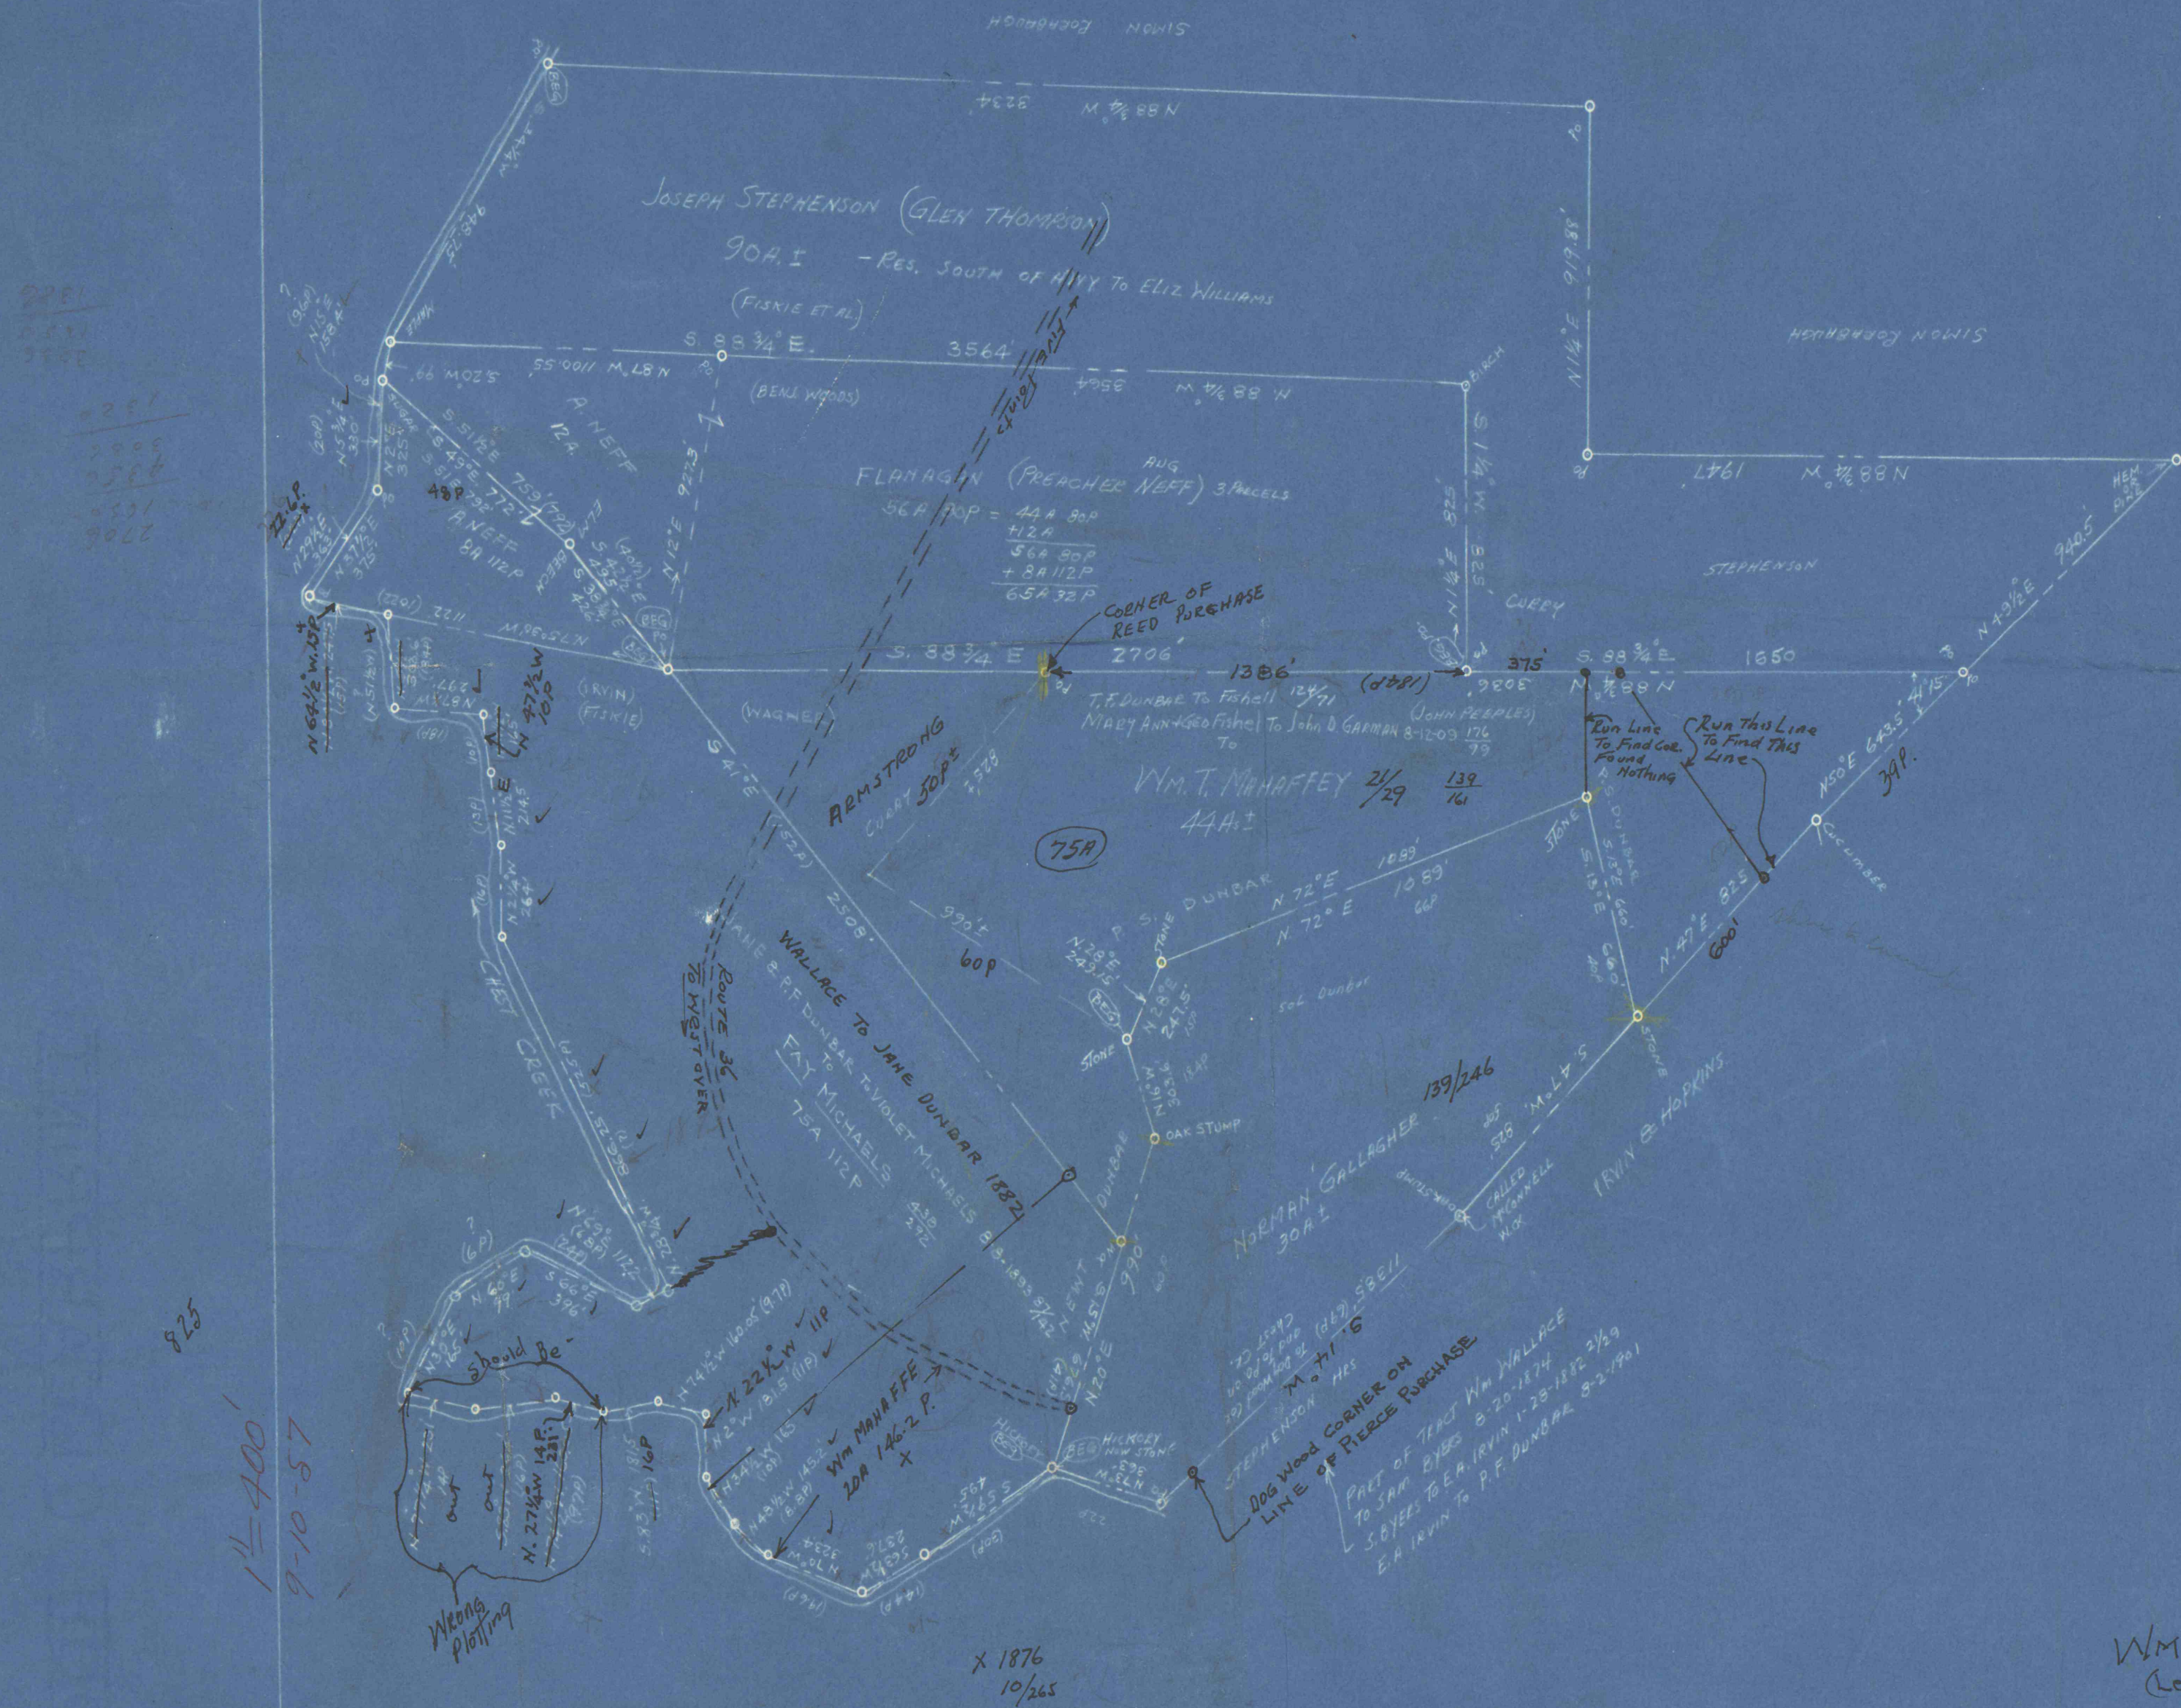

WM. MAHAFFEY LANDS
(Leased To Benjamin Coal Co)
FIVE POINTS-WESTOVER AREA
9-10-57
1" = 400'

Line run by G. Heil + stripped
by Benjamin

13275-2097