

39-13

39-11

35-11


35-20

REVISIONS		
DATE	BY	DESCRIPTION
8-59	gum	120 & 121 Added

DATA TAKEN FROM
AERIAL PHOTOGRAPHS, FLIGHT DATE 1957.
AND OFFICE OF REGISTRAR AND RECORDER
INDIANA COUNTY COURT HOUSE, INDIANA, PA.

NOTE:
THESE MAPS HAVE BEEN PREPARED FOR THE PURPOSE OF ASSISTING THE COUNTY COMMISSIONERS AND OTHER OFFICIALS IN MAKING TAX ASSESSMENTS AND SHOULD NOT BE USED AS INDIVIDUAL PROPERTY SURVEYS FOR LEGAL TRANSACTIONS. BOUNDARY LINES AND LOT DIMENSIONS WERE INTERPRETED FROM AERIAL PHOTOGRAPHS AND EXISTING COUNTY RECORDS. BOUNDARIES WERE VERIFIED WHEREVER POSSIBLE BY INTERVIEW WITH PROPERTY OWNER.
AT NO TIME WERE MEASUREMENTS VERIFIED BY FIELD SURVEYS.

TAX ASSESSMENT MAP
COUNTY OF INDIANA
PENNSYLVANIA

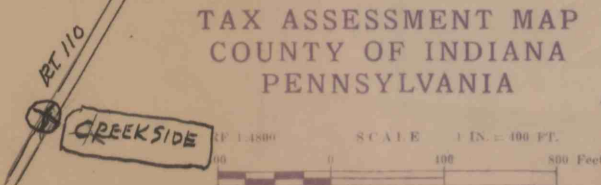

- LEGEND
- IMPROVED PARCEL
 - PRINCIPAL POINT OF PHOTOGRAPH
 - COORDINATE INTERSECTIONS

GWIN, LARSON & KIMBALL
ENGINEERS & CARTOGRAPHERS
ALTOONA & EBENSBURG, PENNA.

WASHINGTON
TOWNSHIP

TAX MAP No. 39-12

IMAPS 14514

