


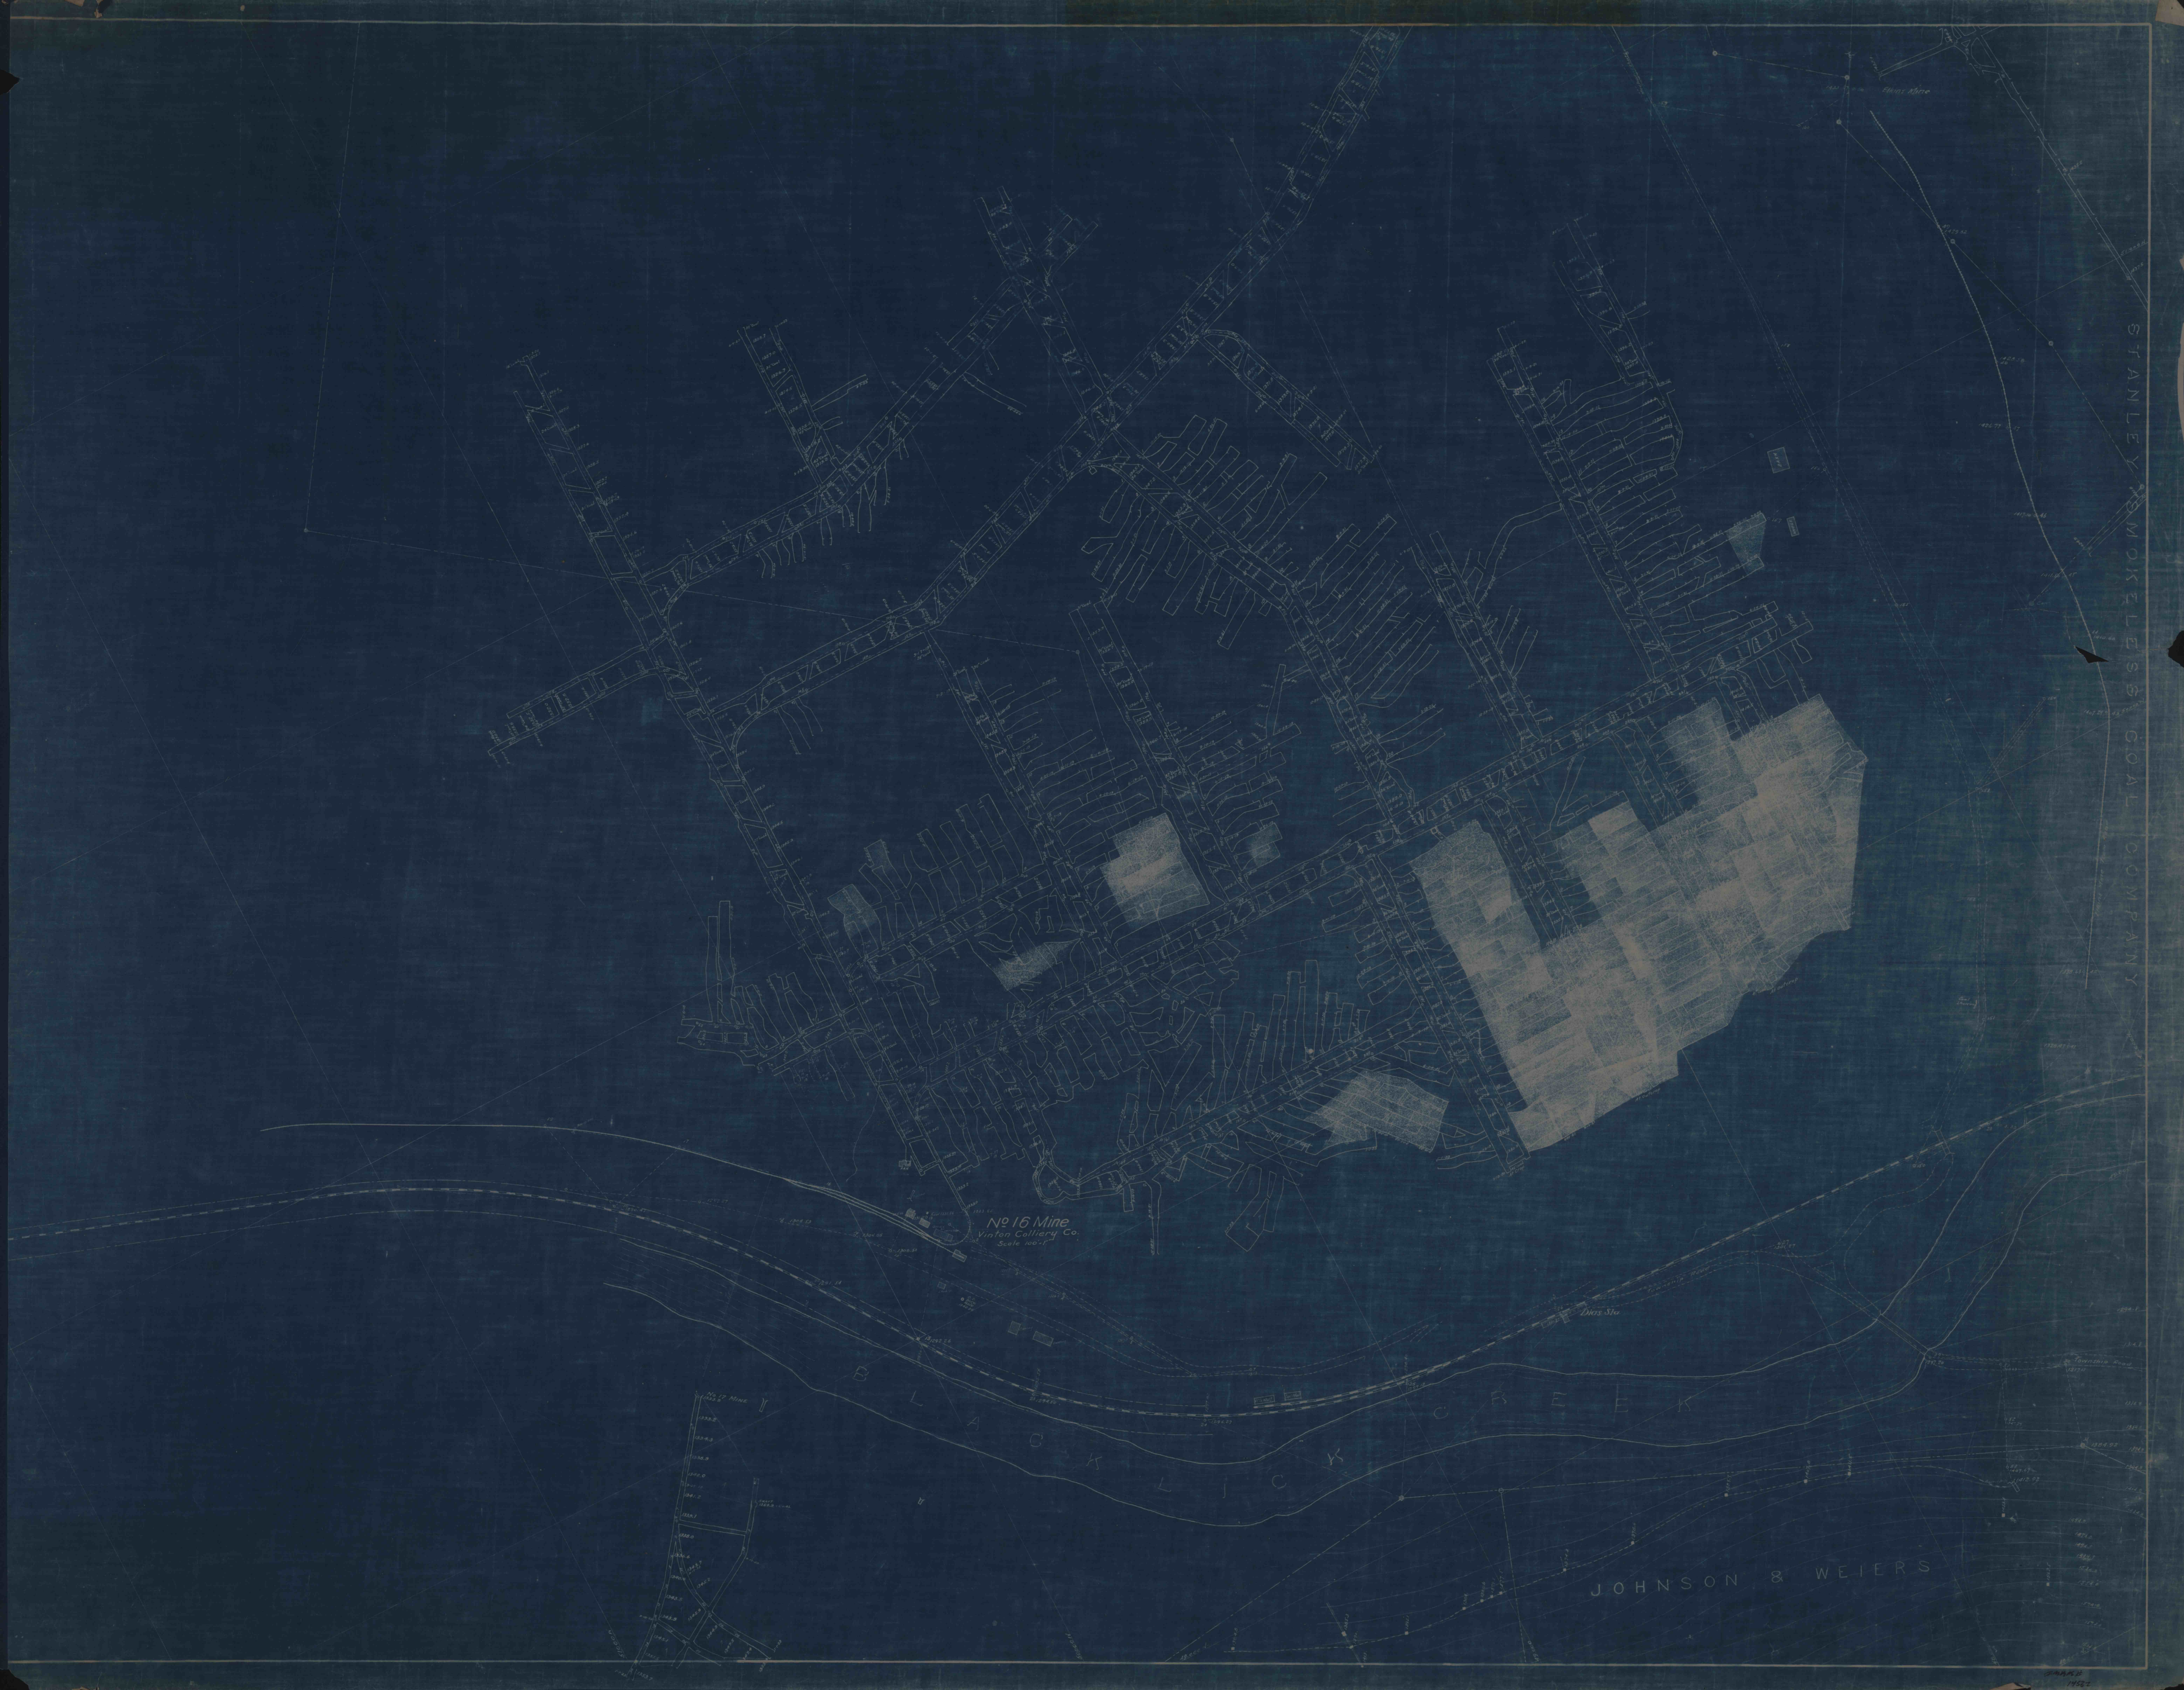

No 16 Mine
Vinton Colliery Co.
Scale 100'

BLACKLICK CREEK

JOHNSON & WEIERS

