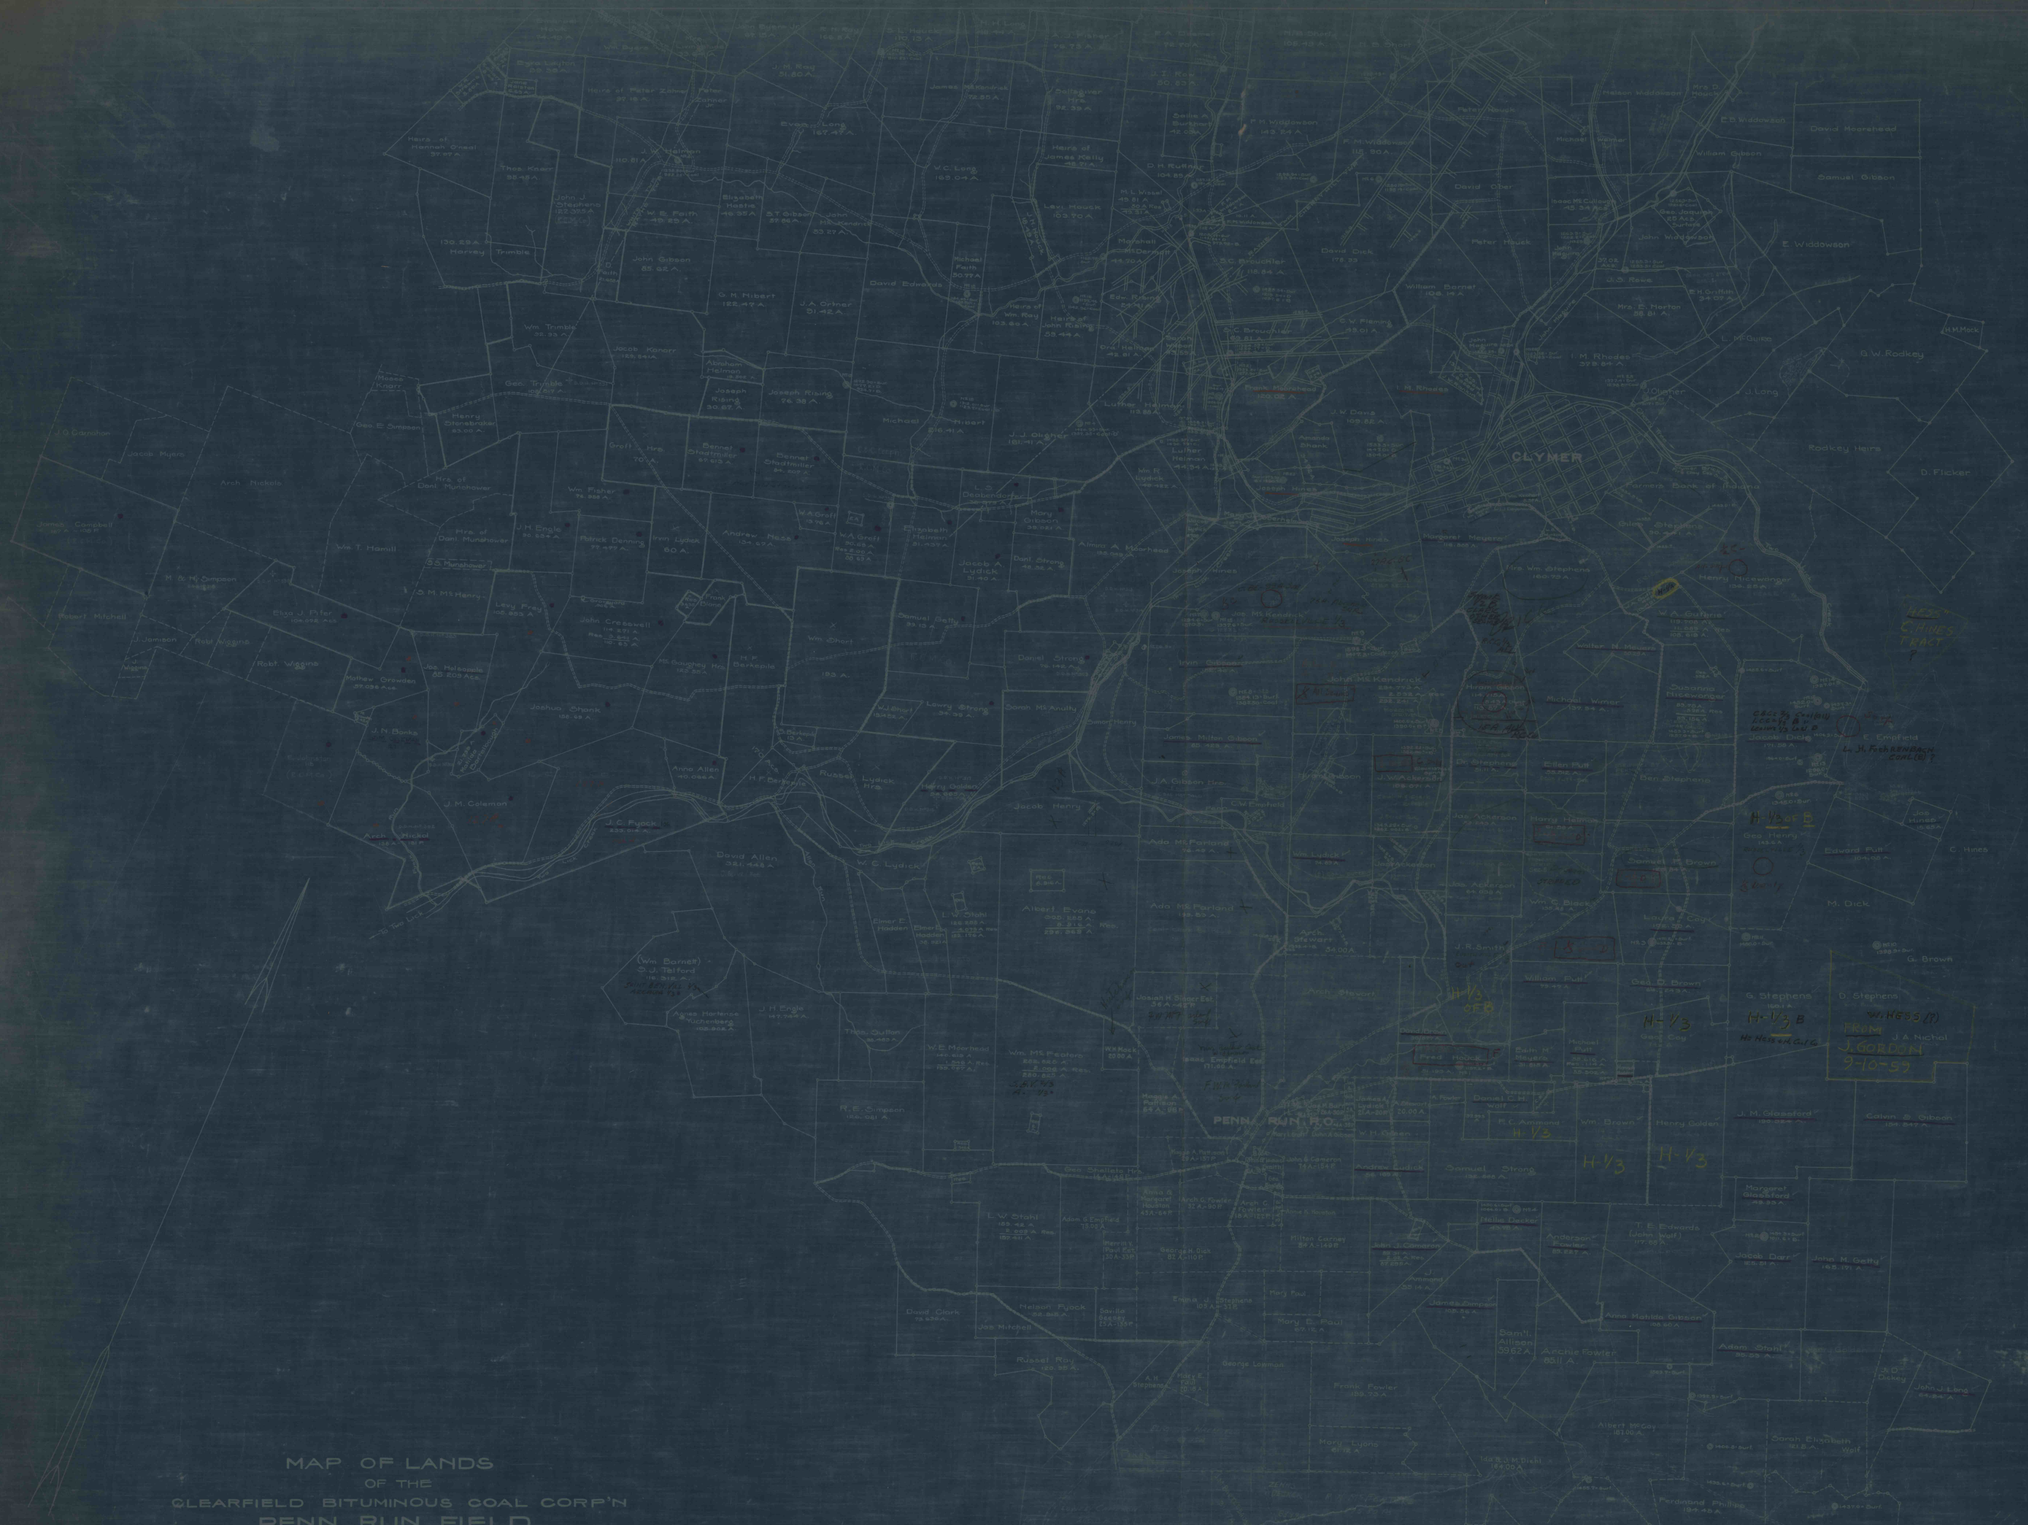
CLYMER
PENN RUN P.O.
MAP OF LANDS
OF THE
CLEARFIELD BITUMINOUS COAL CORP'N
PENN RUN FIELD
CHERRY HILL TOWNSHIP, INDIANA CO, PENNA.
SCALE: 1" = 1000'
APRIL 1917
NEW YORK CENTRAL RAILROAD CO. - COAL MINING DEP'T.
