


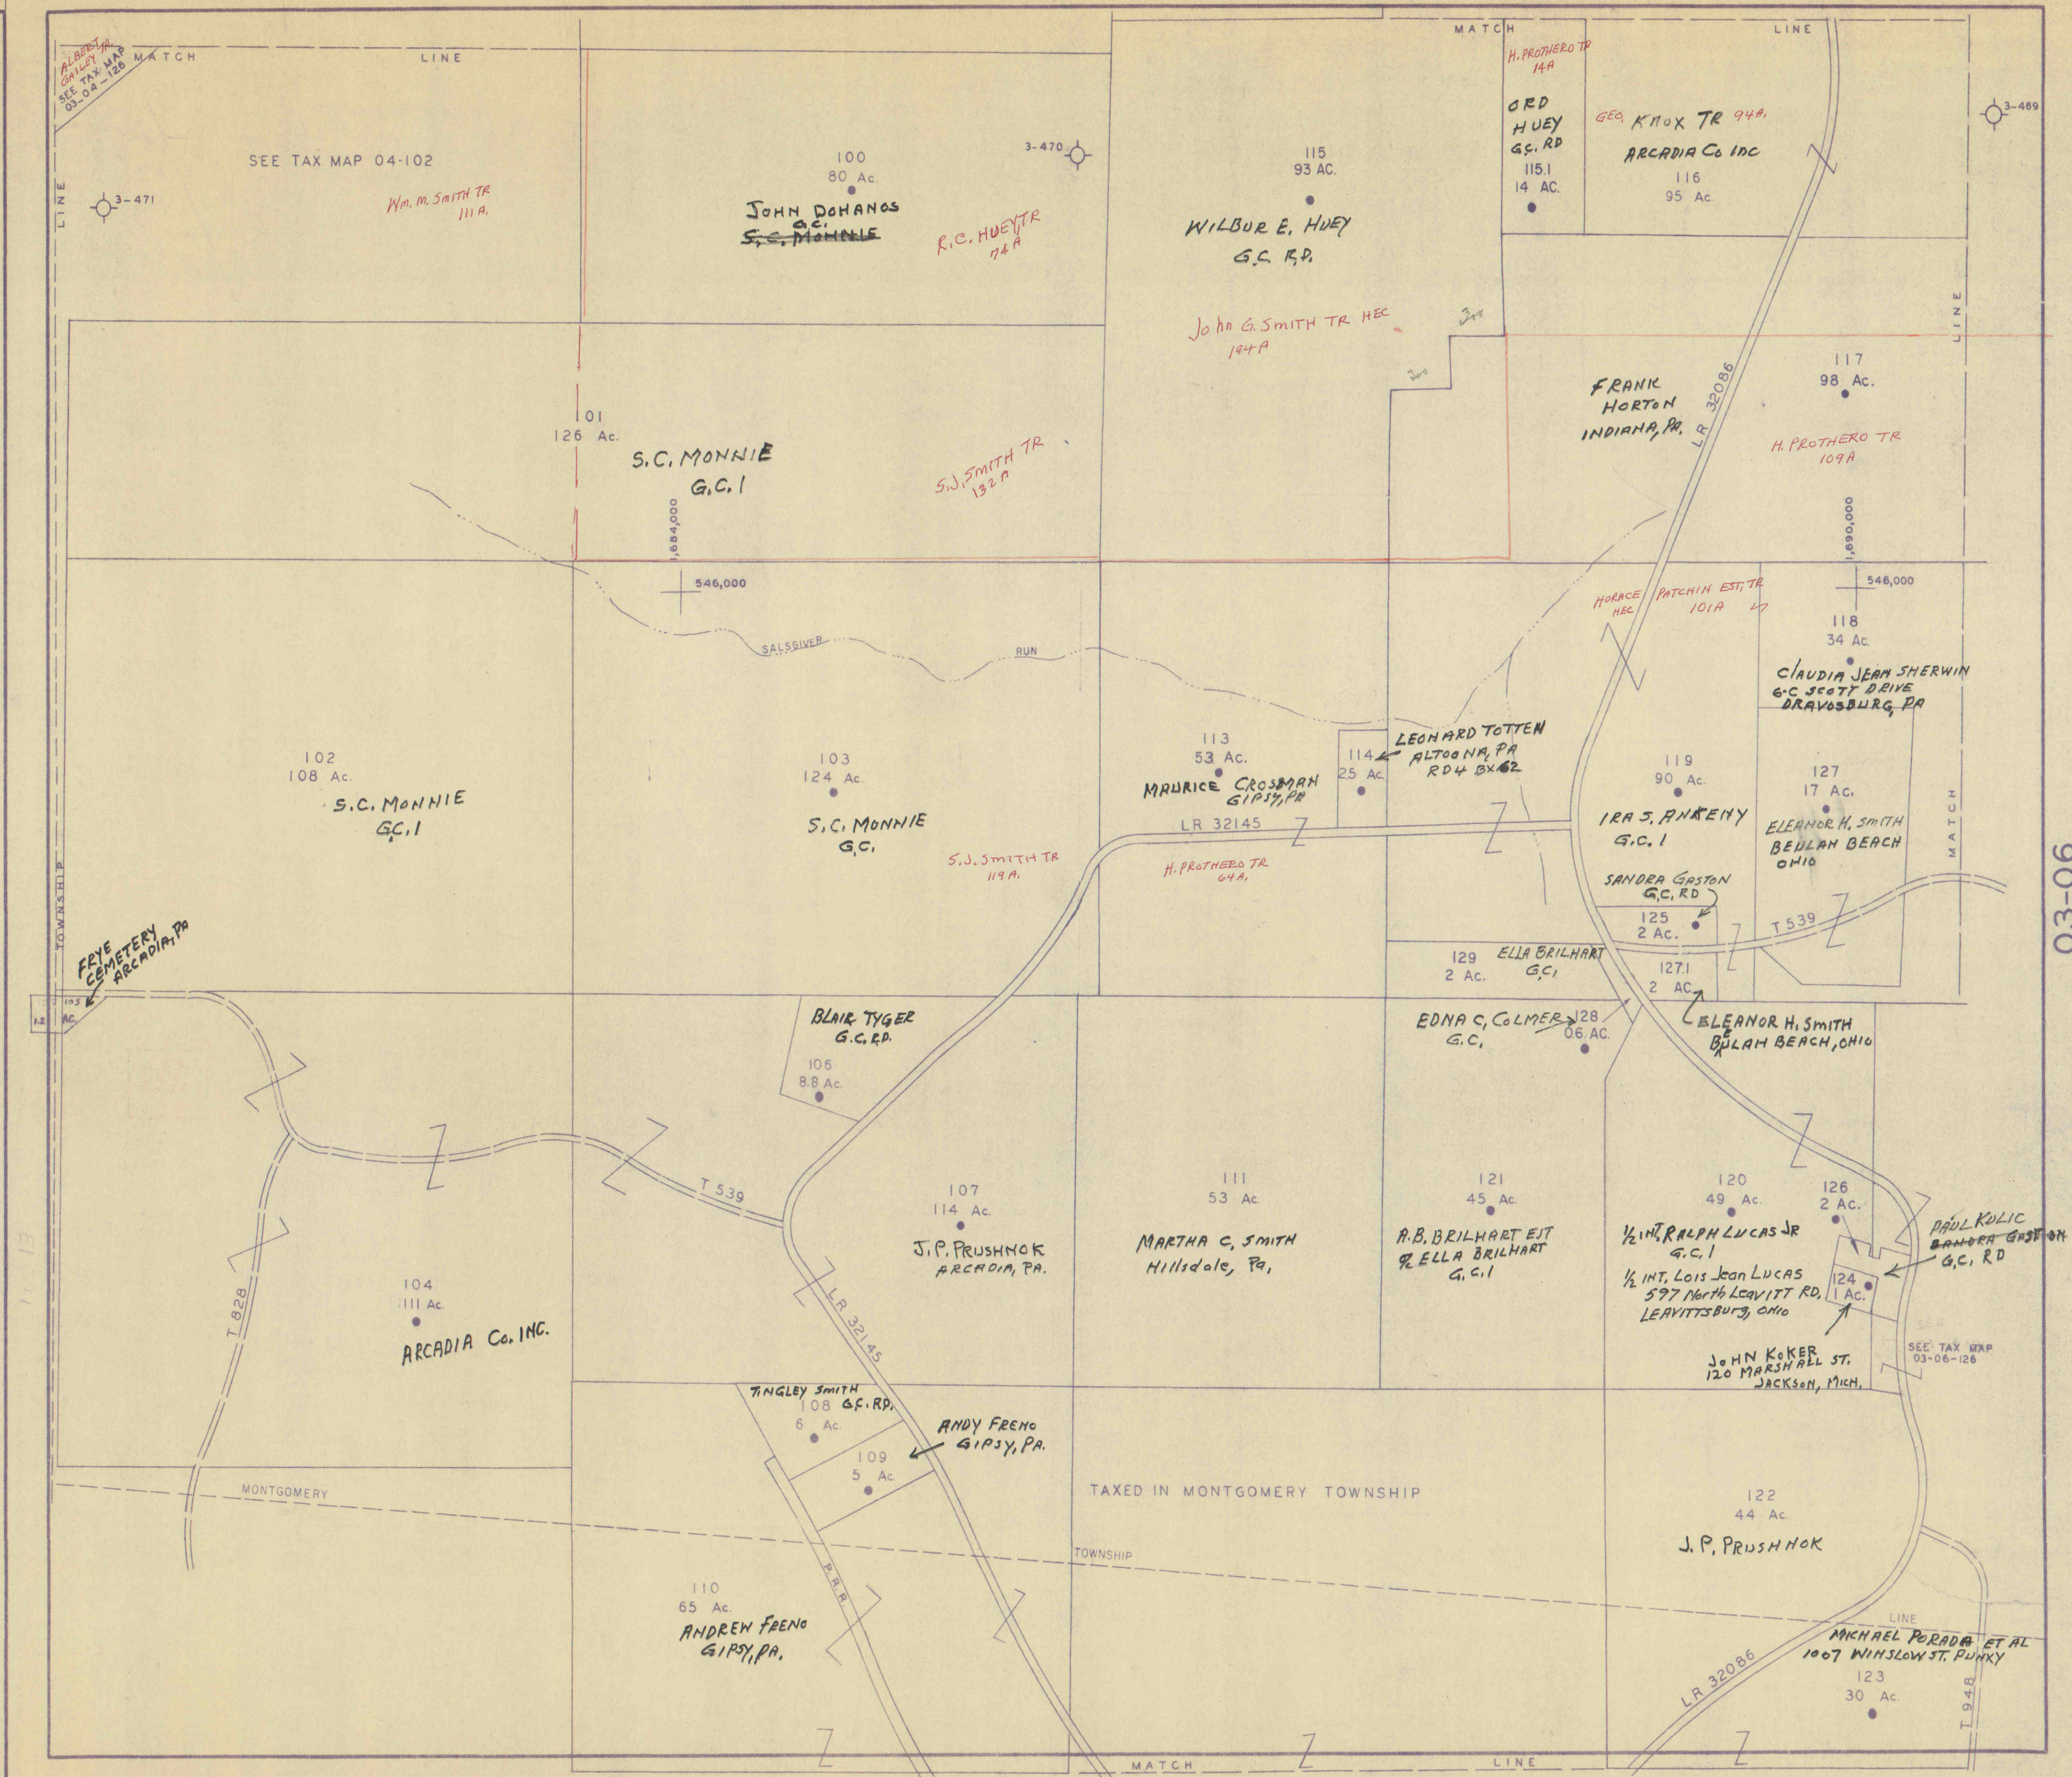

REVISIONS		
DATE	BY	DESCRIPTION
6-59	J.W.M.	Lots 125-127 Added
6-60	J.W.M.	" 115.1-127.1 " Lots 115-124 No. change

DATA TAKEN FROM:
AERIAL PHOTOGRAPHS, FLIGHT DATE 1957,
AND OFFICE OF REGISTRAR AND RECORDER
INDIANA COUNTY COURT HOUSE, INDIANA, PA.

NOTE:
THESE MAPS HAVE BEEN PREPARED FOR THE PURPOSE OF ASSISTING THE COUNTY COMMISSIONERS AND OTHER OFFICIALS IN MAKING TAX ASSESSMENTS AND SHOULD NOT BE USED AS INDIVIDUAL PROPERTY SURVEYS FOR LEGAL TRANSACTIONS. BOUNDARY LINES AND LOT DIMENSIONS WERE INTERPRETED FROM AERIAL PHOTOGRAPHS AND EXISTING COUNTY RECORDS. BOUNDARIES WERE VERIFIED WHEREVER POSSIBLE BY INTERVIEW WITH PROPERTY OWNER. AT NO TIME WERE MEASUREMENTS VERIFIED BY FIELD SURVEYS.

TAX ASSESSMENT MAP COUNTY OF INDIANA PENNSYLVANIA

SCALE 1 IN. = 400 FT.
0 400 800 Feet

LEGEND
● IMPROVED PARCEL
○ PRINCIPAL POINT OF PHOTOGRAPH
+ COORDINATE INTERSECTIONS

GWIN, LARSON & KIMBALL
ENGINEERS & CARTOGRAPHERS
ALTOONA & EBERSBURG, PENNA.

BANKS
TOWNSHIP

TAX MAP No. 03-05

IMAPS# 14571

3-05 Banks