


27-14

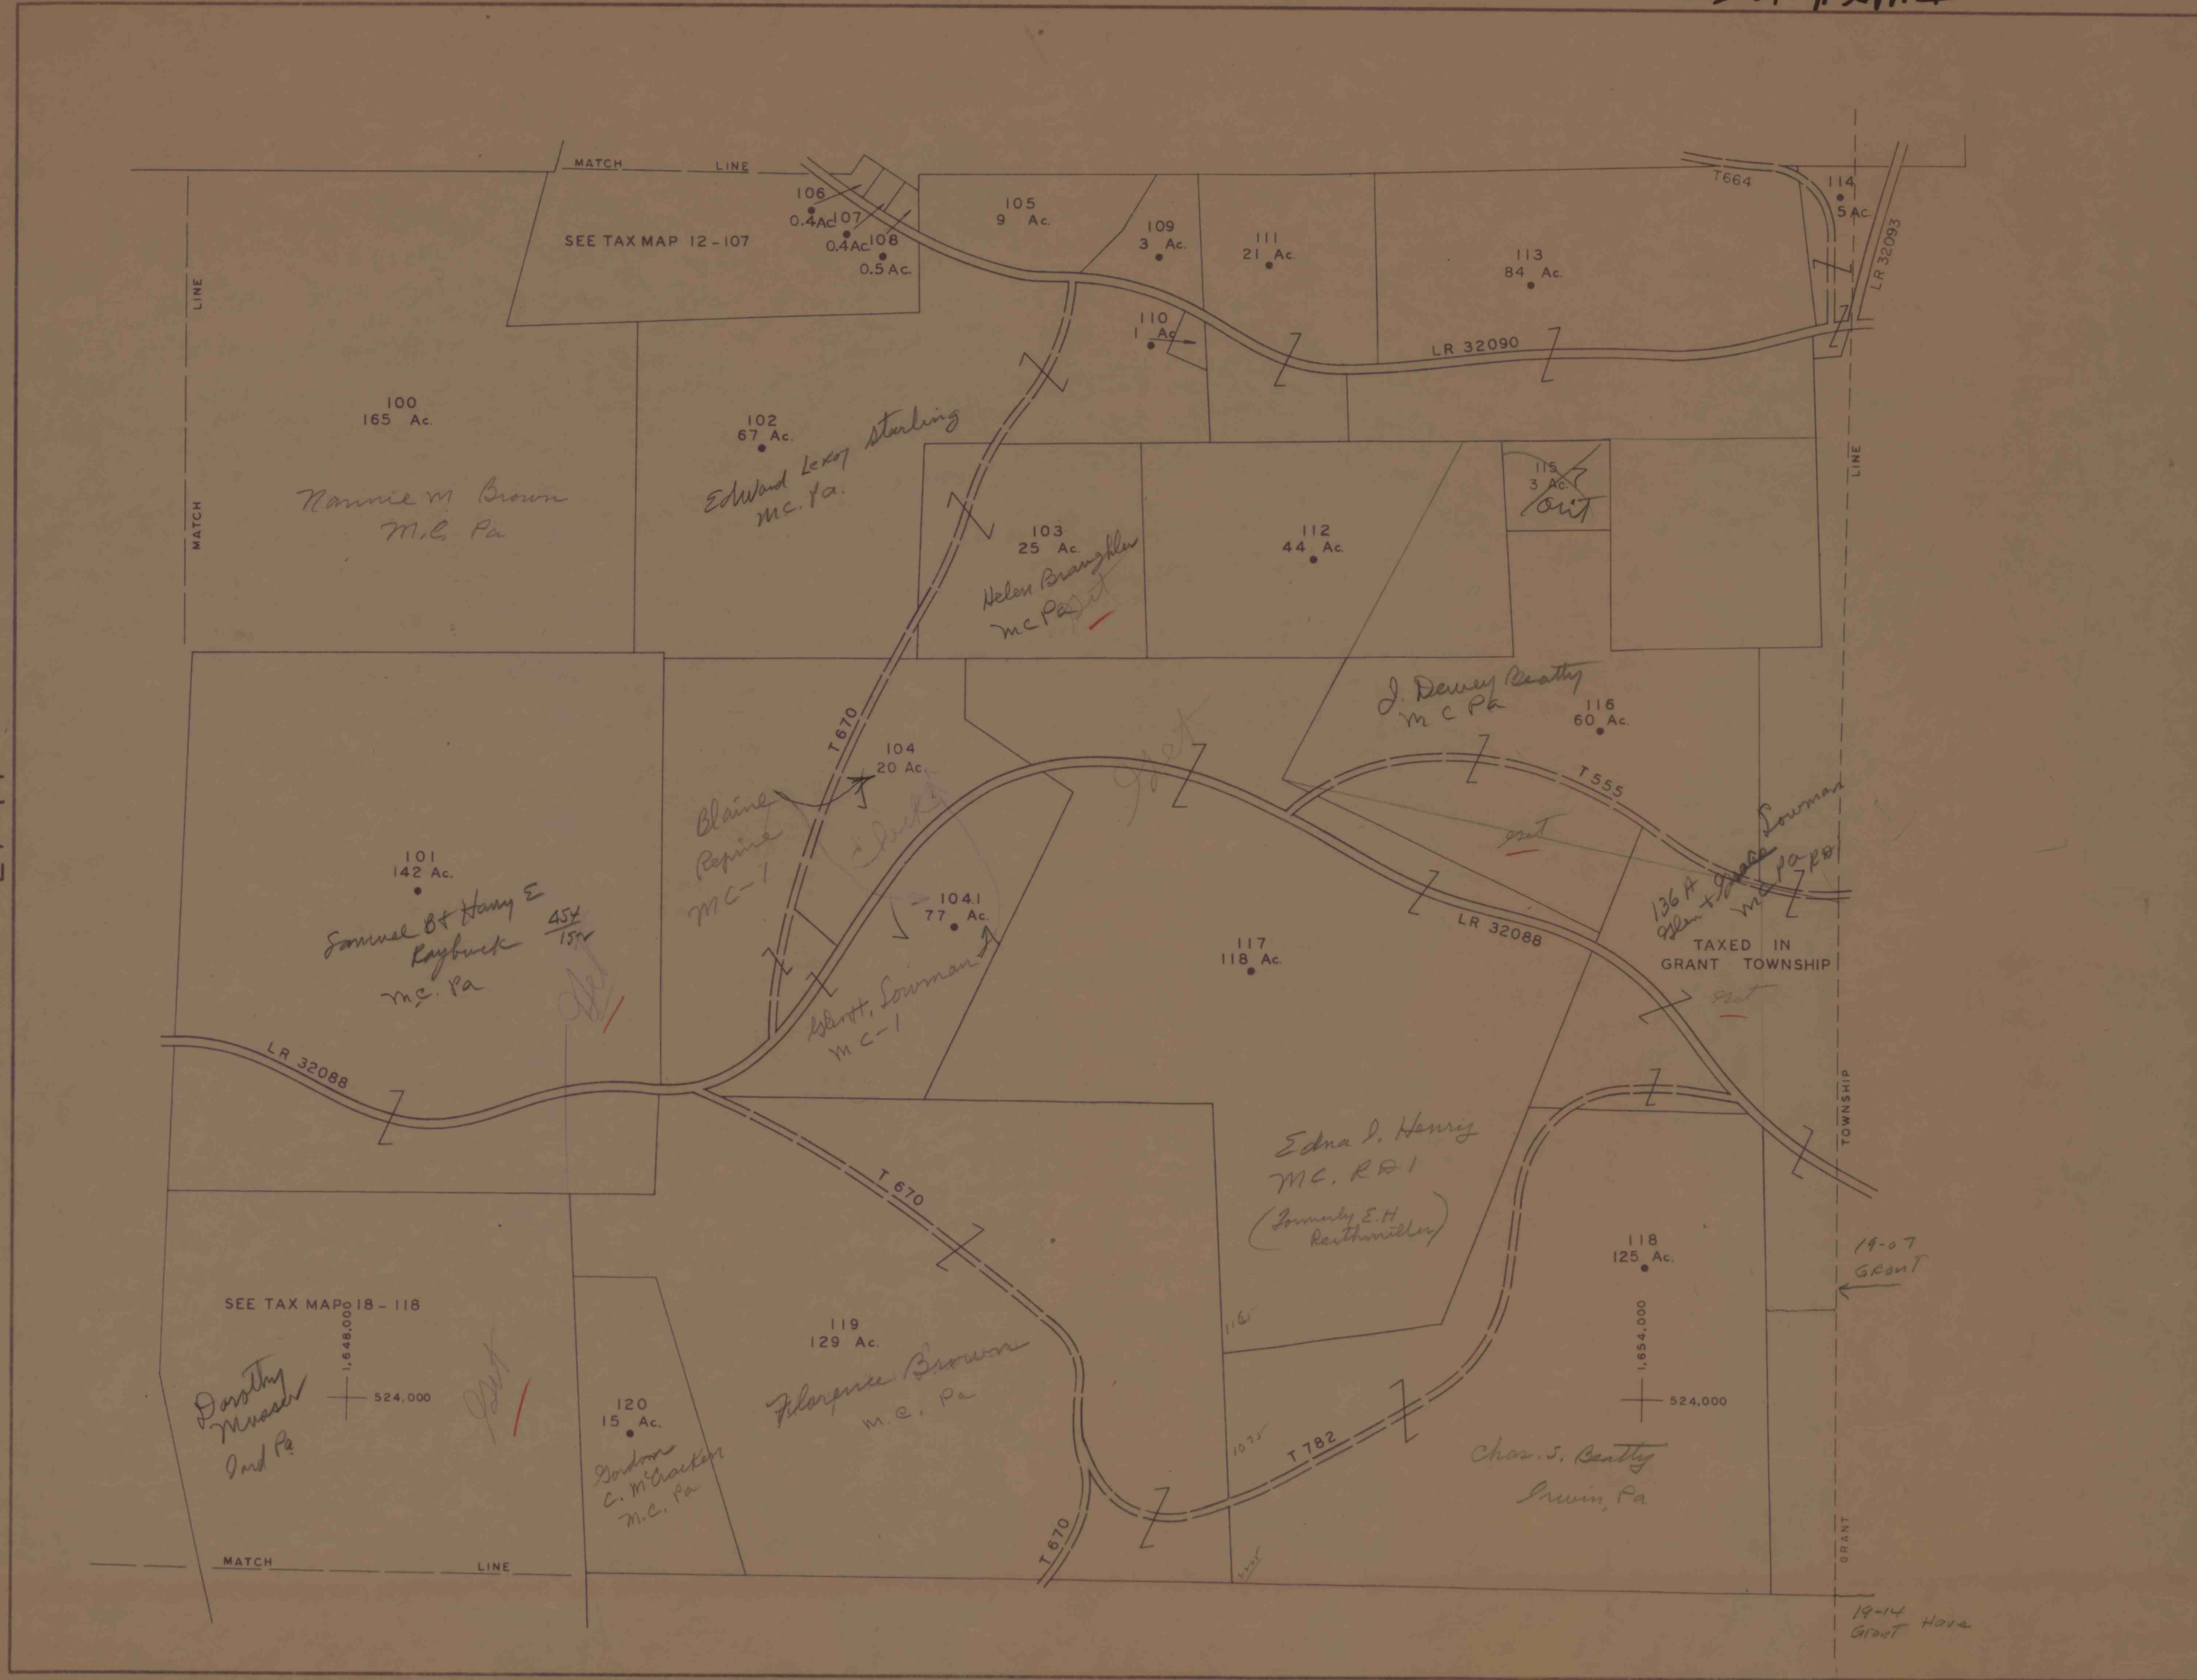

Have → 27-19

REVISIONS		DESCRIPTION
DATE	BY	
8-59	JWM	Lot 101 and Added
7-60	M.C.	changed acreage 101/8

DATA TAKEN FROM
AERIAL PHOTOGRAPHS, FLIGHT DATE 1957,
AND OFFICE OF REGISTRAR AND RECORDER
INDIANA COUNTY COURT HOUSE INDIANA PA

NOTE
THESE MAPS HAVE BEEN PREPARED FOR THE PURPOSE OF ASSISTING THE COUNTY
COMMISSIONER AND OTHER OFFICIALS IN MAKING TAX ASSESSMENTS AND SHOULD
NOT BE USED AS INDIVIDUAL PROPERTY SURVEYS FOR LEGAL TRANSACTIONS.
BOUNDARY LINES AND LOT DIMENSIONS WERE INTERPRETED FROM AERIAL PHOTO-
GRAPHS AND EXISTING COUNTY RECORDS. BOUNDARIES WERE VERIFIED WHEREVER
POSSIBLE BY INTERVIEW WITH PROPERTY OWNERS.
AT NO TIME WERE MEASUREMENTS VERIFIED BY FIELD SURVEYS

TAX ASSESSMENT MAP
COUNTY OF INDIANA
PENNSYLVANIA



- LEGEND
- IMPROVED PARCEL
 - PRINCIPAL POINT OF PHOTOGRAPH
 - ✚ COORDINATE INTERSECTIONS

GWIN, LARSON & KIMBALL
ENGINEERS & CARTOGRAPHERS
ALTOONA & EBENSBURG, PENNA.

EAST MAHONING
TOWNSHIP

TAX MAP No. 27-13