


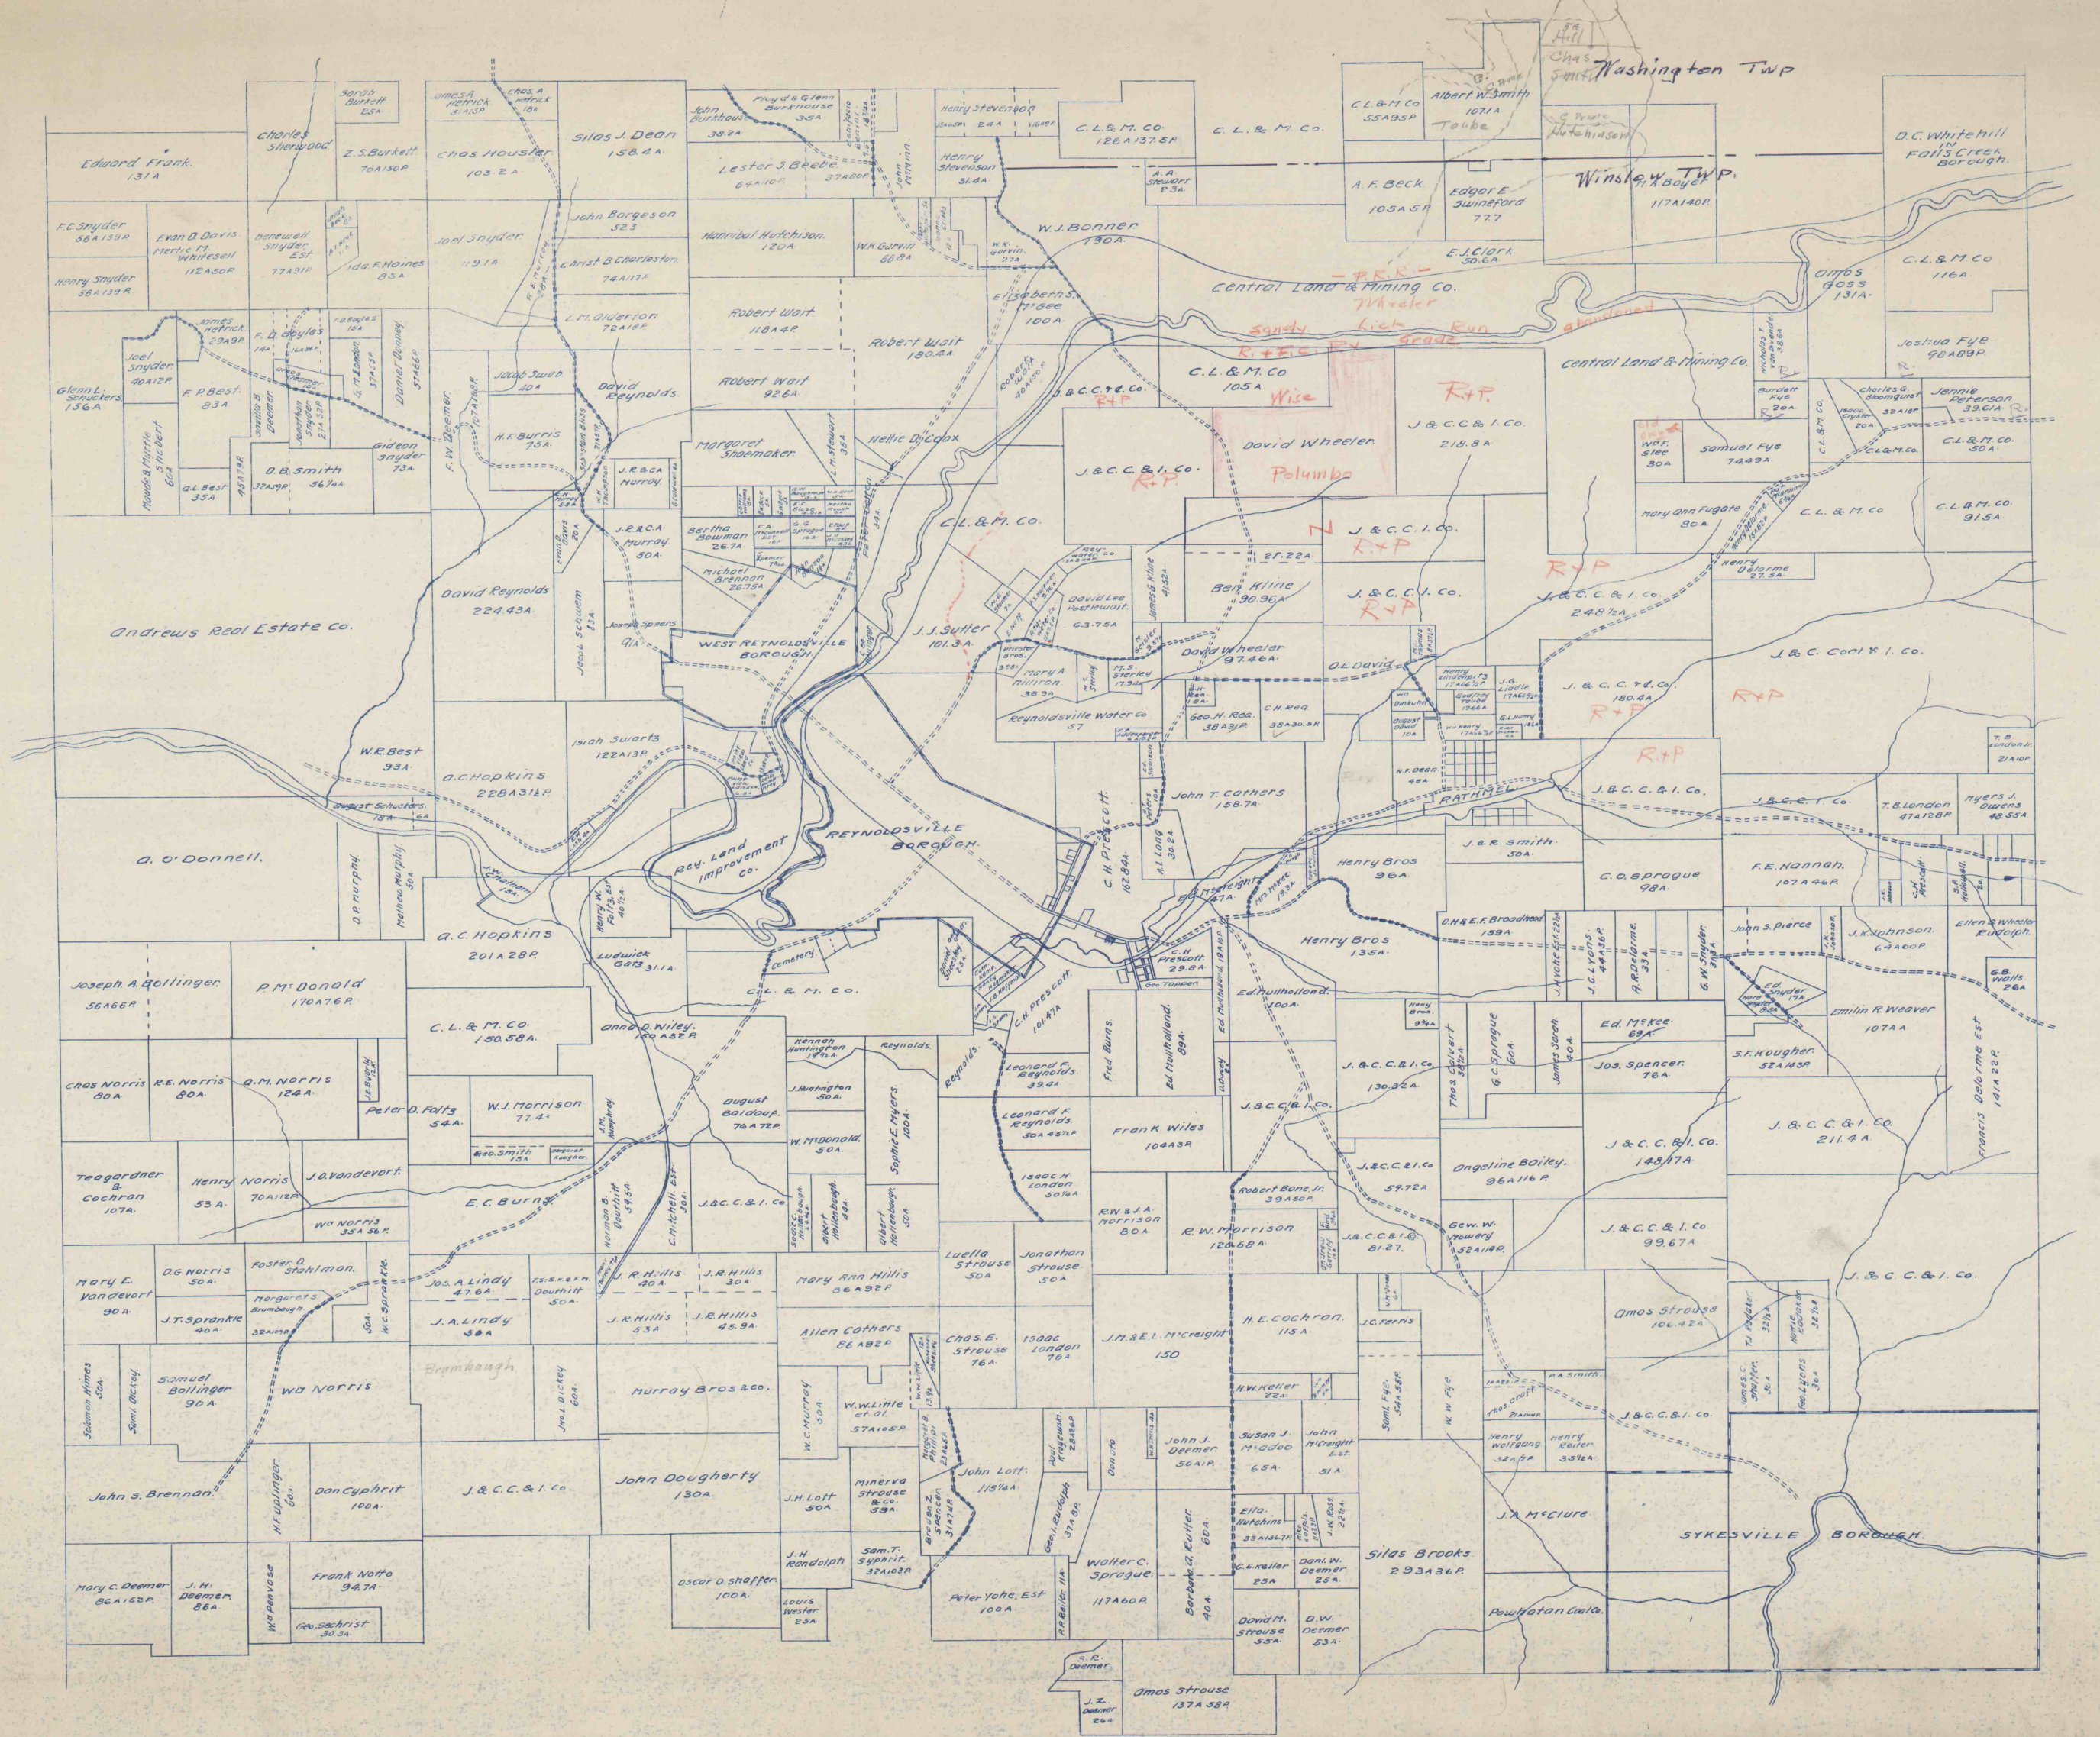

MAP OF
WINSLOW TWP
JEFF. CO PA
1908