


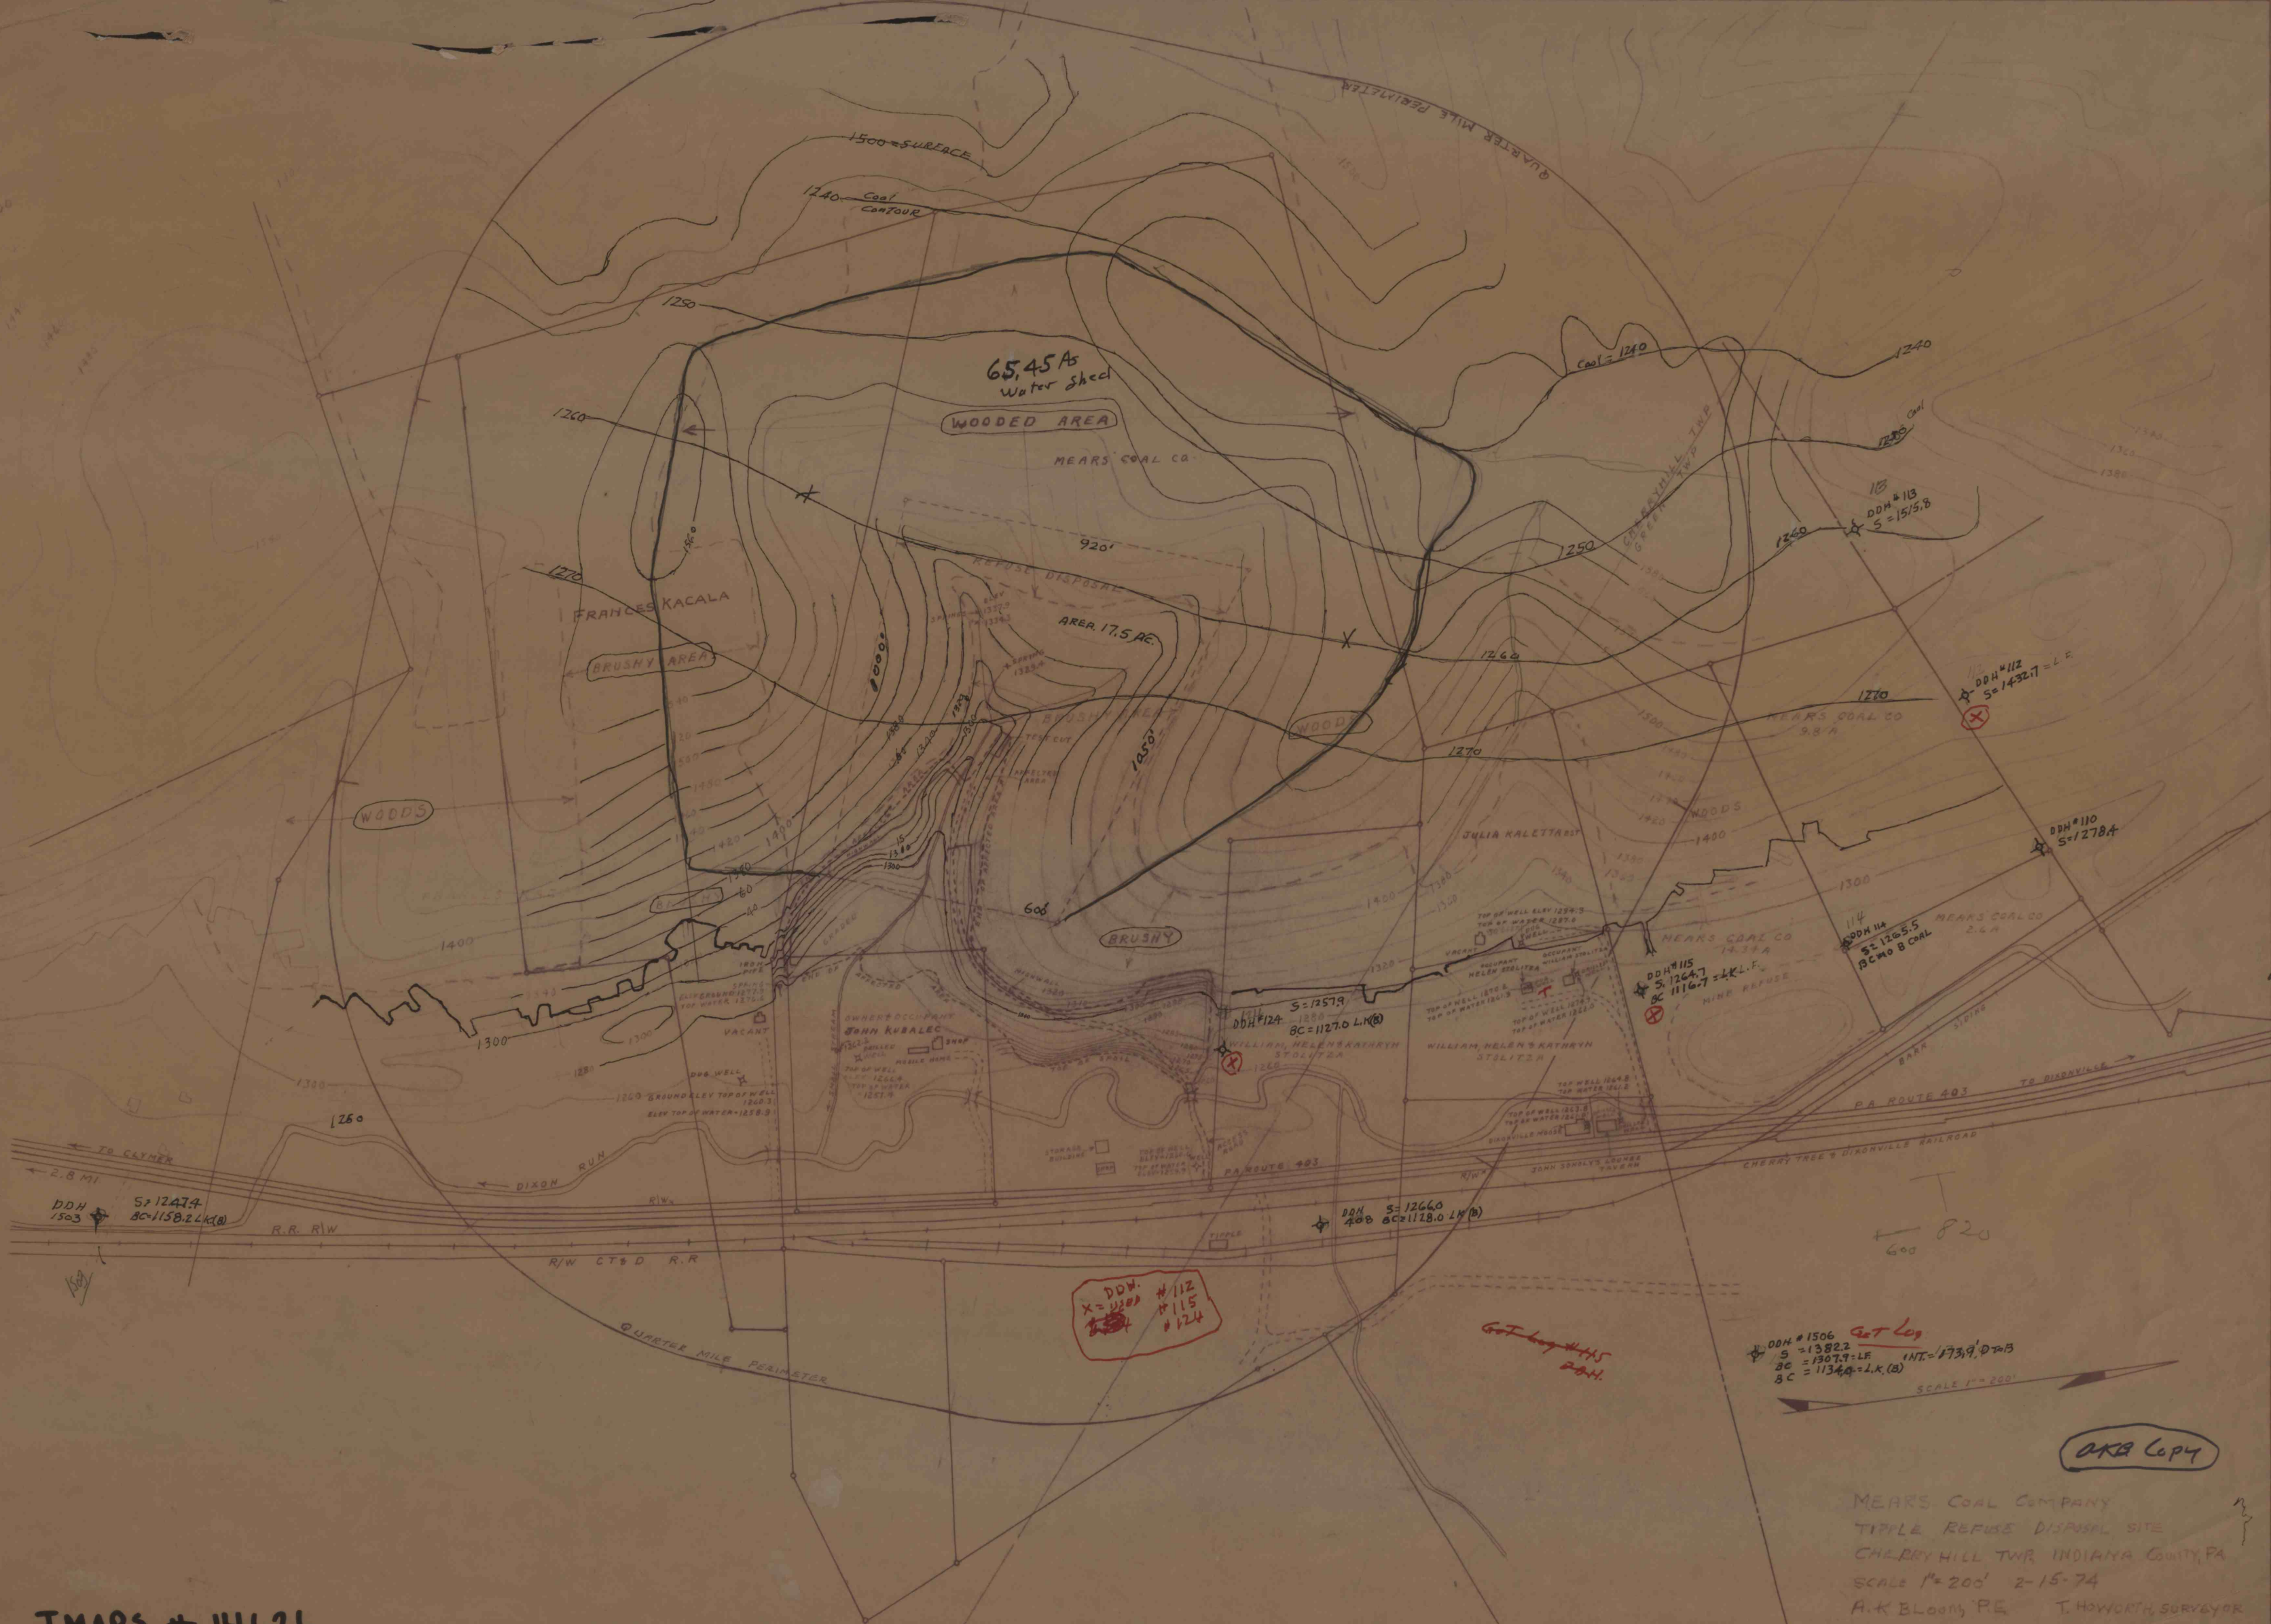

IMAPS # 14626

MEARS COAL COMPANY
TIPPLE REFUSE DISPOSAL SITE
CHERRY HILL TWP, INDIANA COUNTY, PA
SCALE 1"=200' 2-15-74
A.K. BLOOM, P.E. T. HOWARTH, SURVEYOR