


10-12

10-06

10-10

60-01

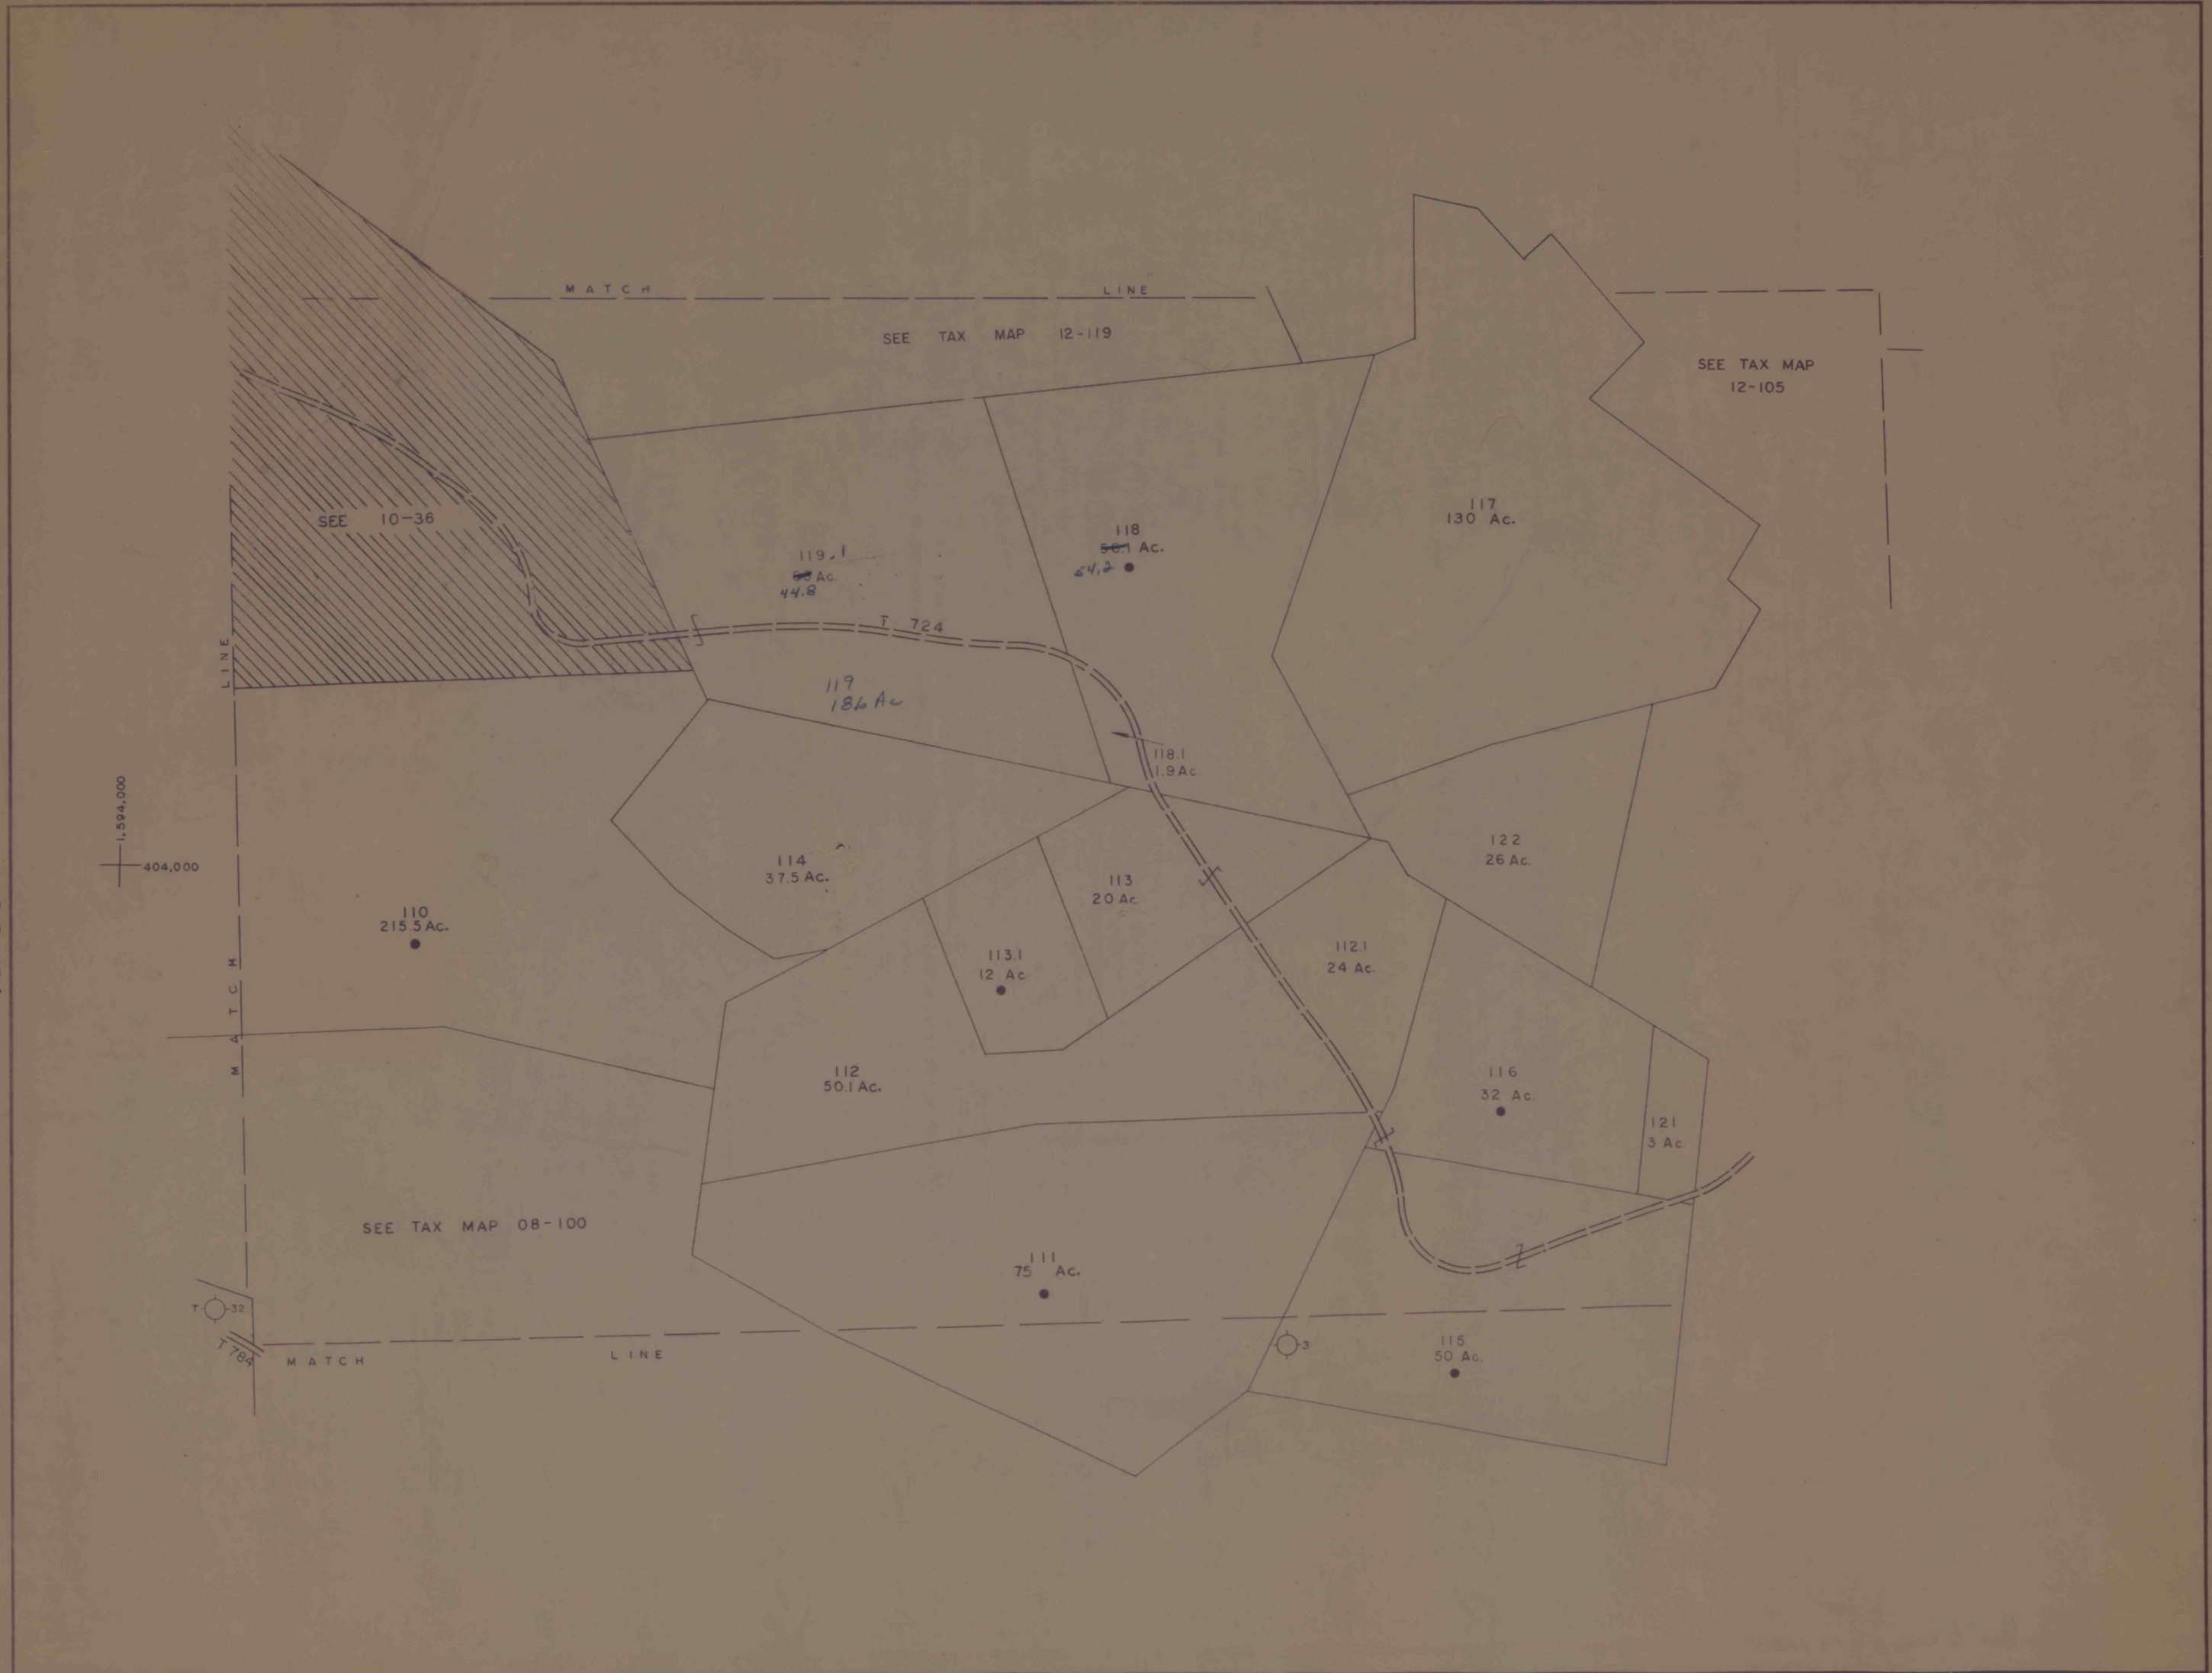

| REVISIONS |     | DESCRIPTION   |
|-----------|-----|---|
| 1         | 190 | 110 111 112 |