
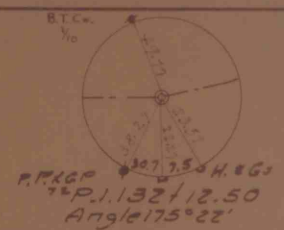


B.M. Spike in base of Oak
150' L.H. of Sta 34+45
Elev. 1260.73

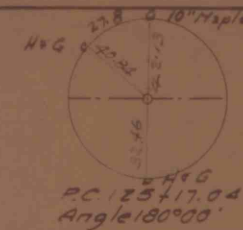

DISTRICT	COUNTY	ROUTE	SEC.	SHEET
10-0	INDIANA	508R-3		19 of 32

CHERRYHILL TOWNSHIP

Final Quantities

REQUIRED LIST



EDGAR & ANNA WILLIAMS

ANNA KACALA

JOHN

KUBALEK

RUSSELVILLE COAL COMPANY

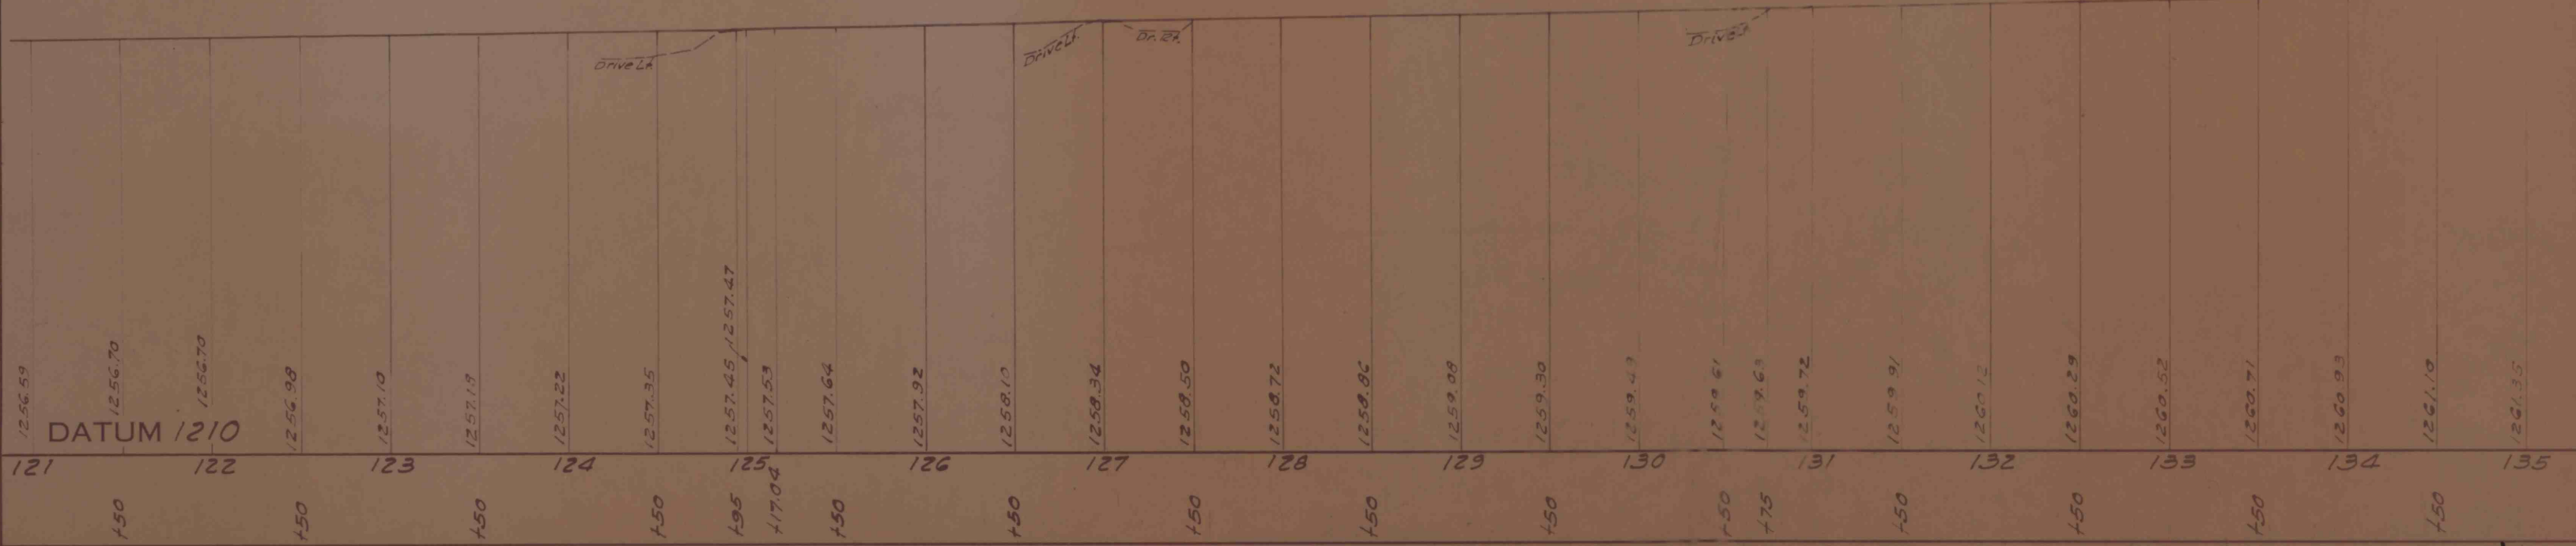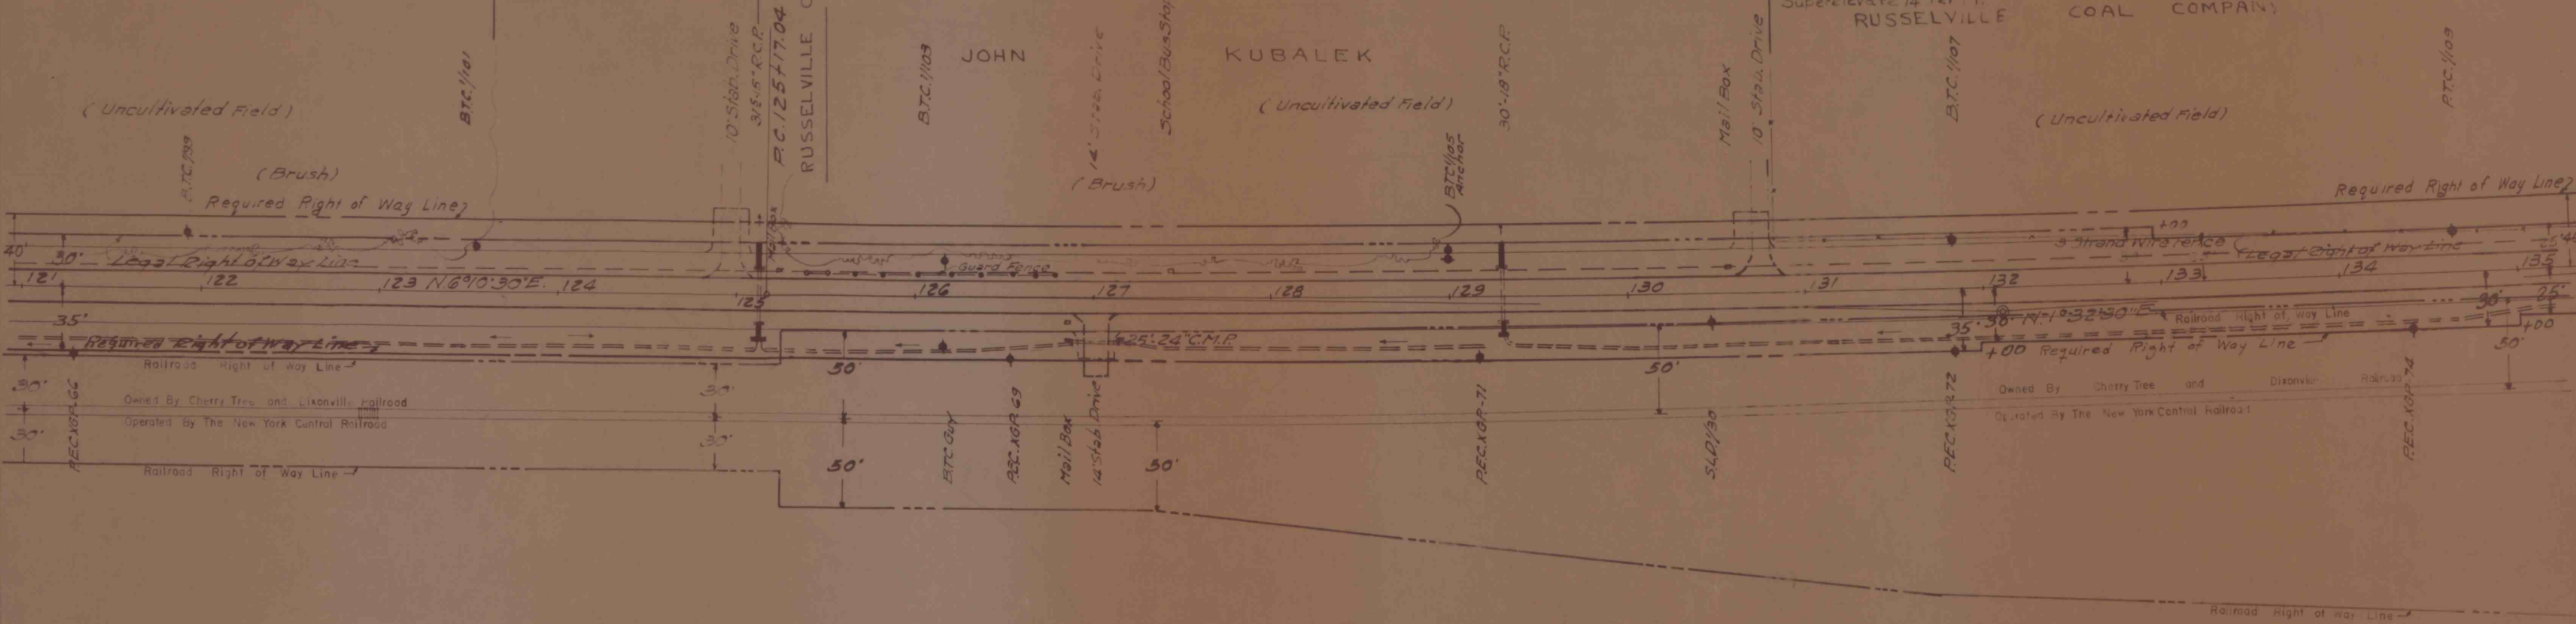

IMAPS # 14638

TRACED BY Rischeberger '57
FINAL BY