


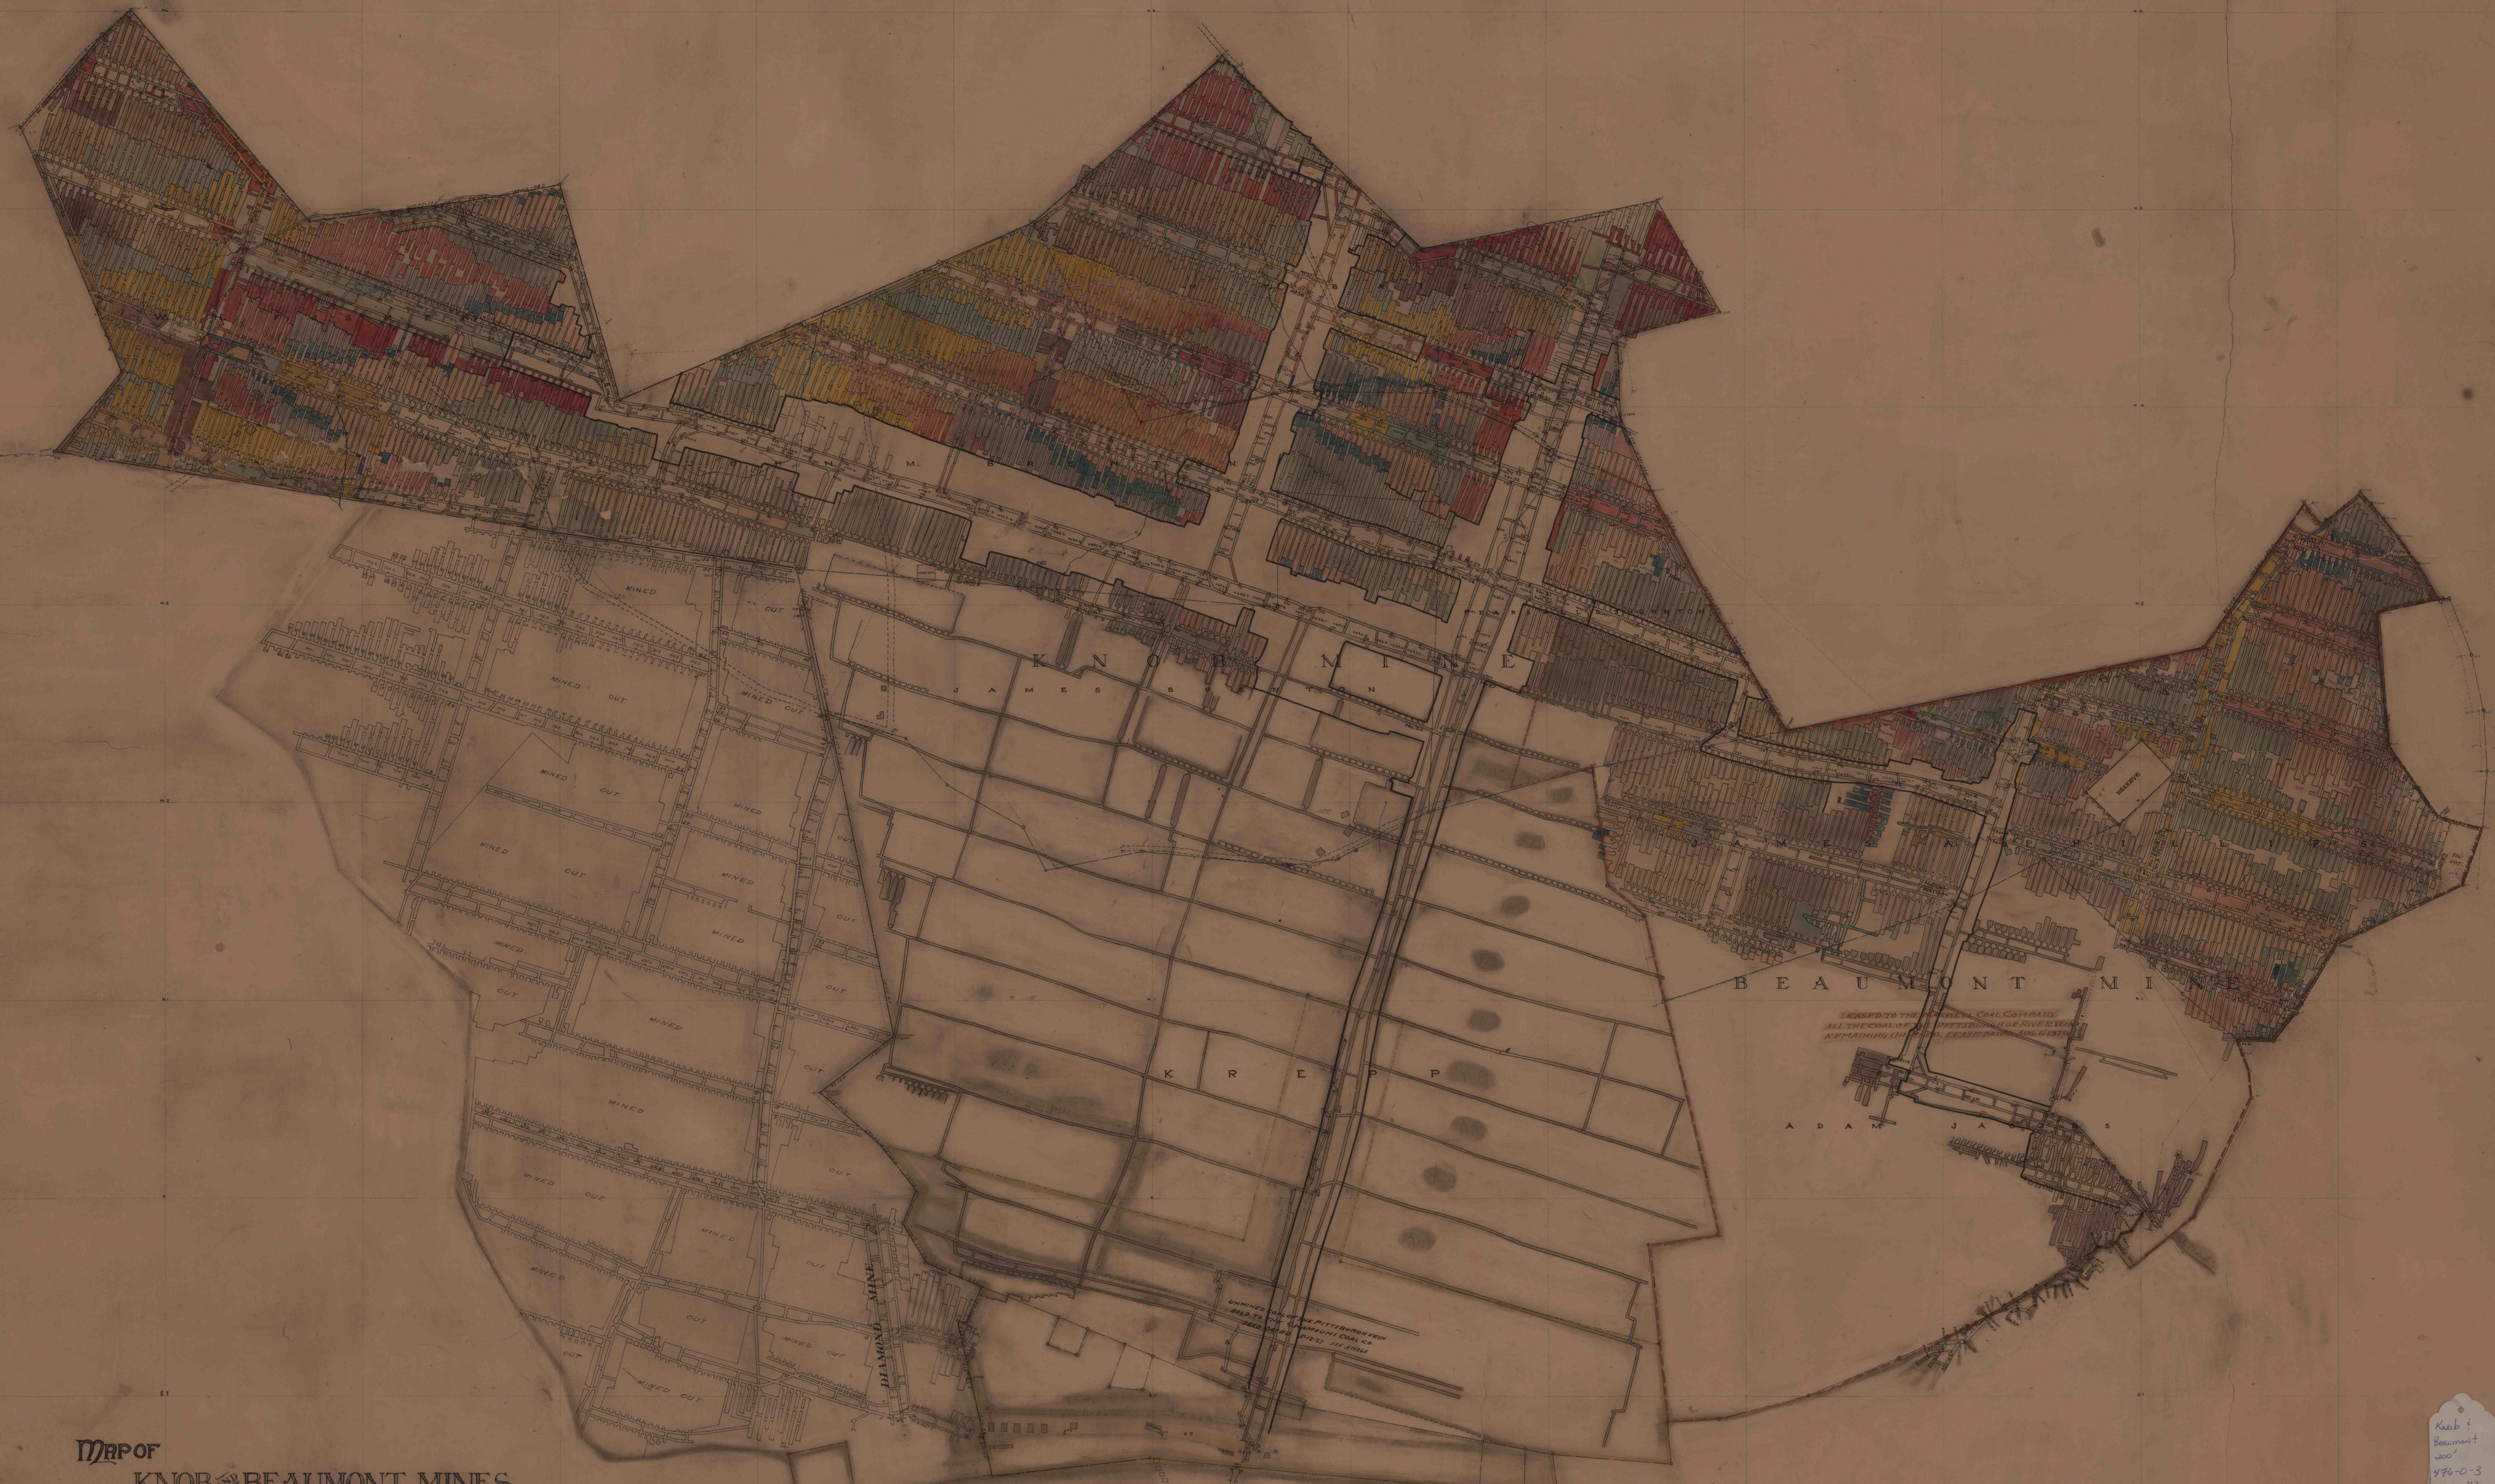

MAP OF
KNOB & BEAUMONT MINES
M.R.C.C. & CO.
Scale 1"=200' Feb'y 16, 1904.

Knob &
Beaumont
Mines
1902-03
x51-45