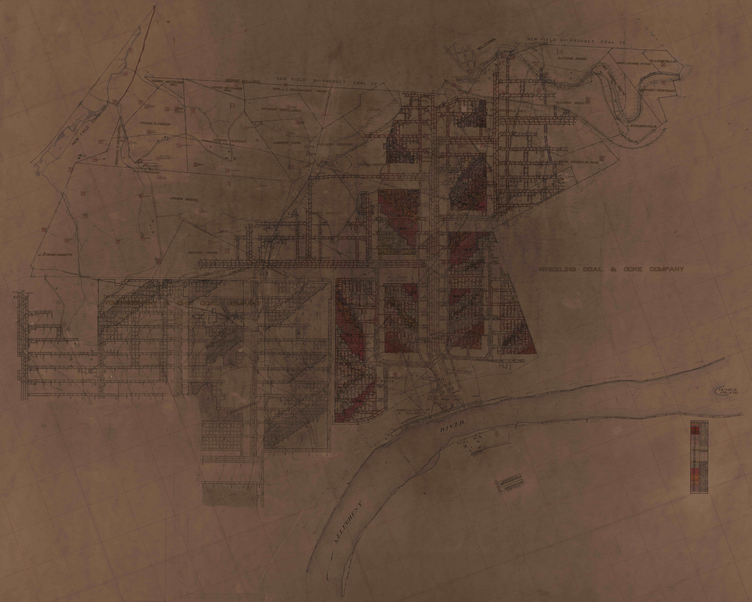
WHEELING COAL & COKE COMPANY
ALLEGHENY
RIVER