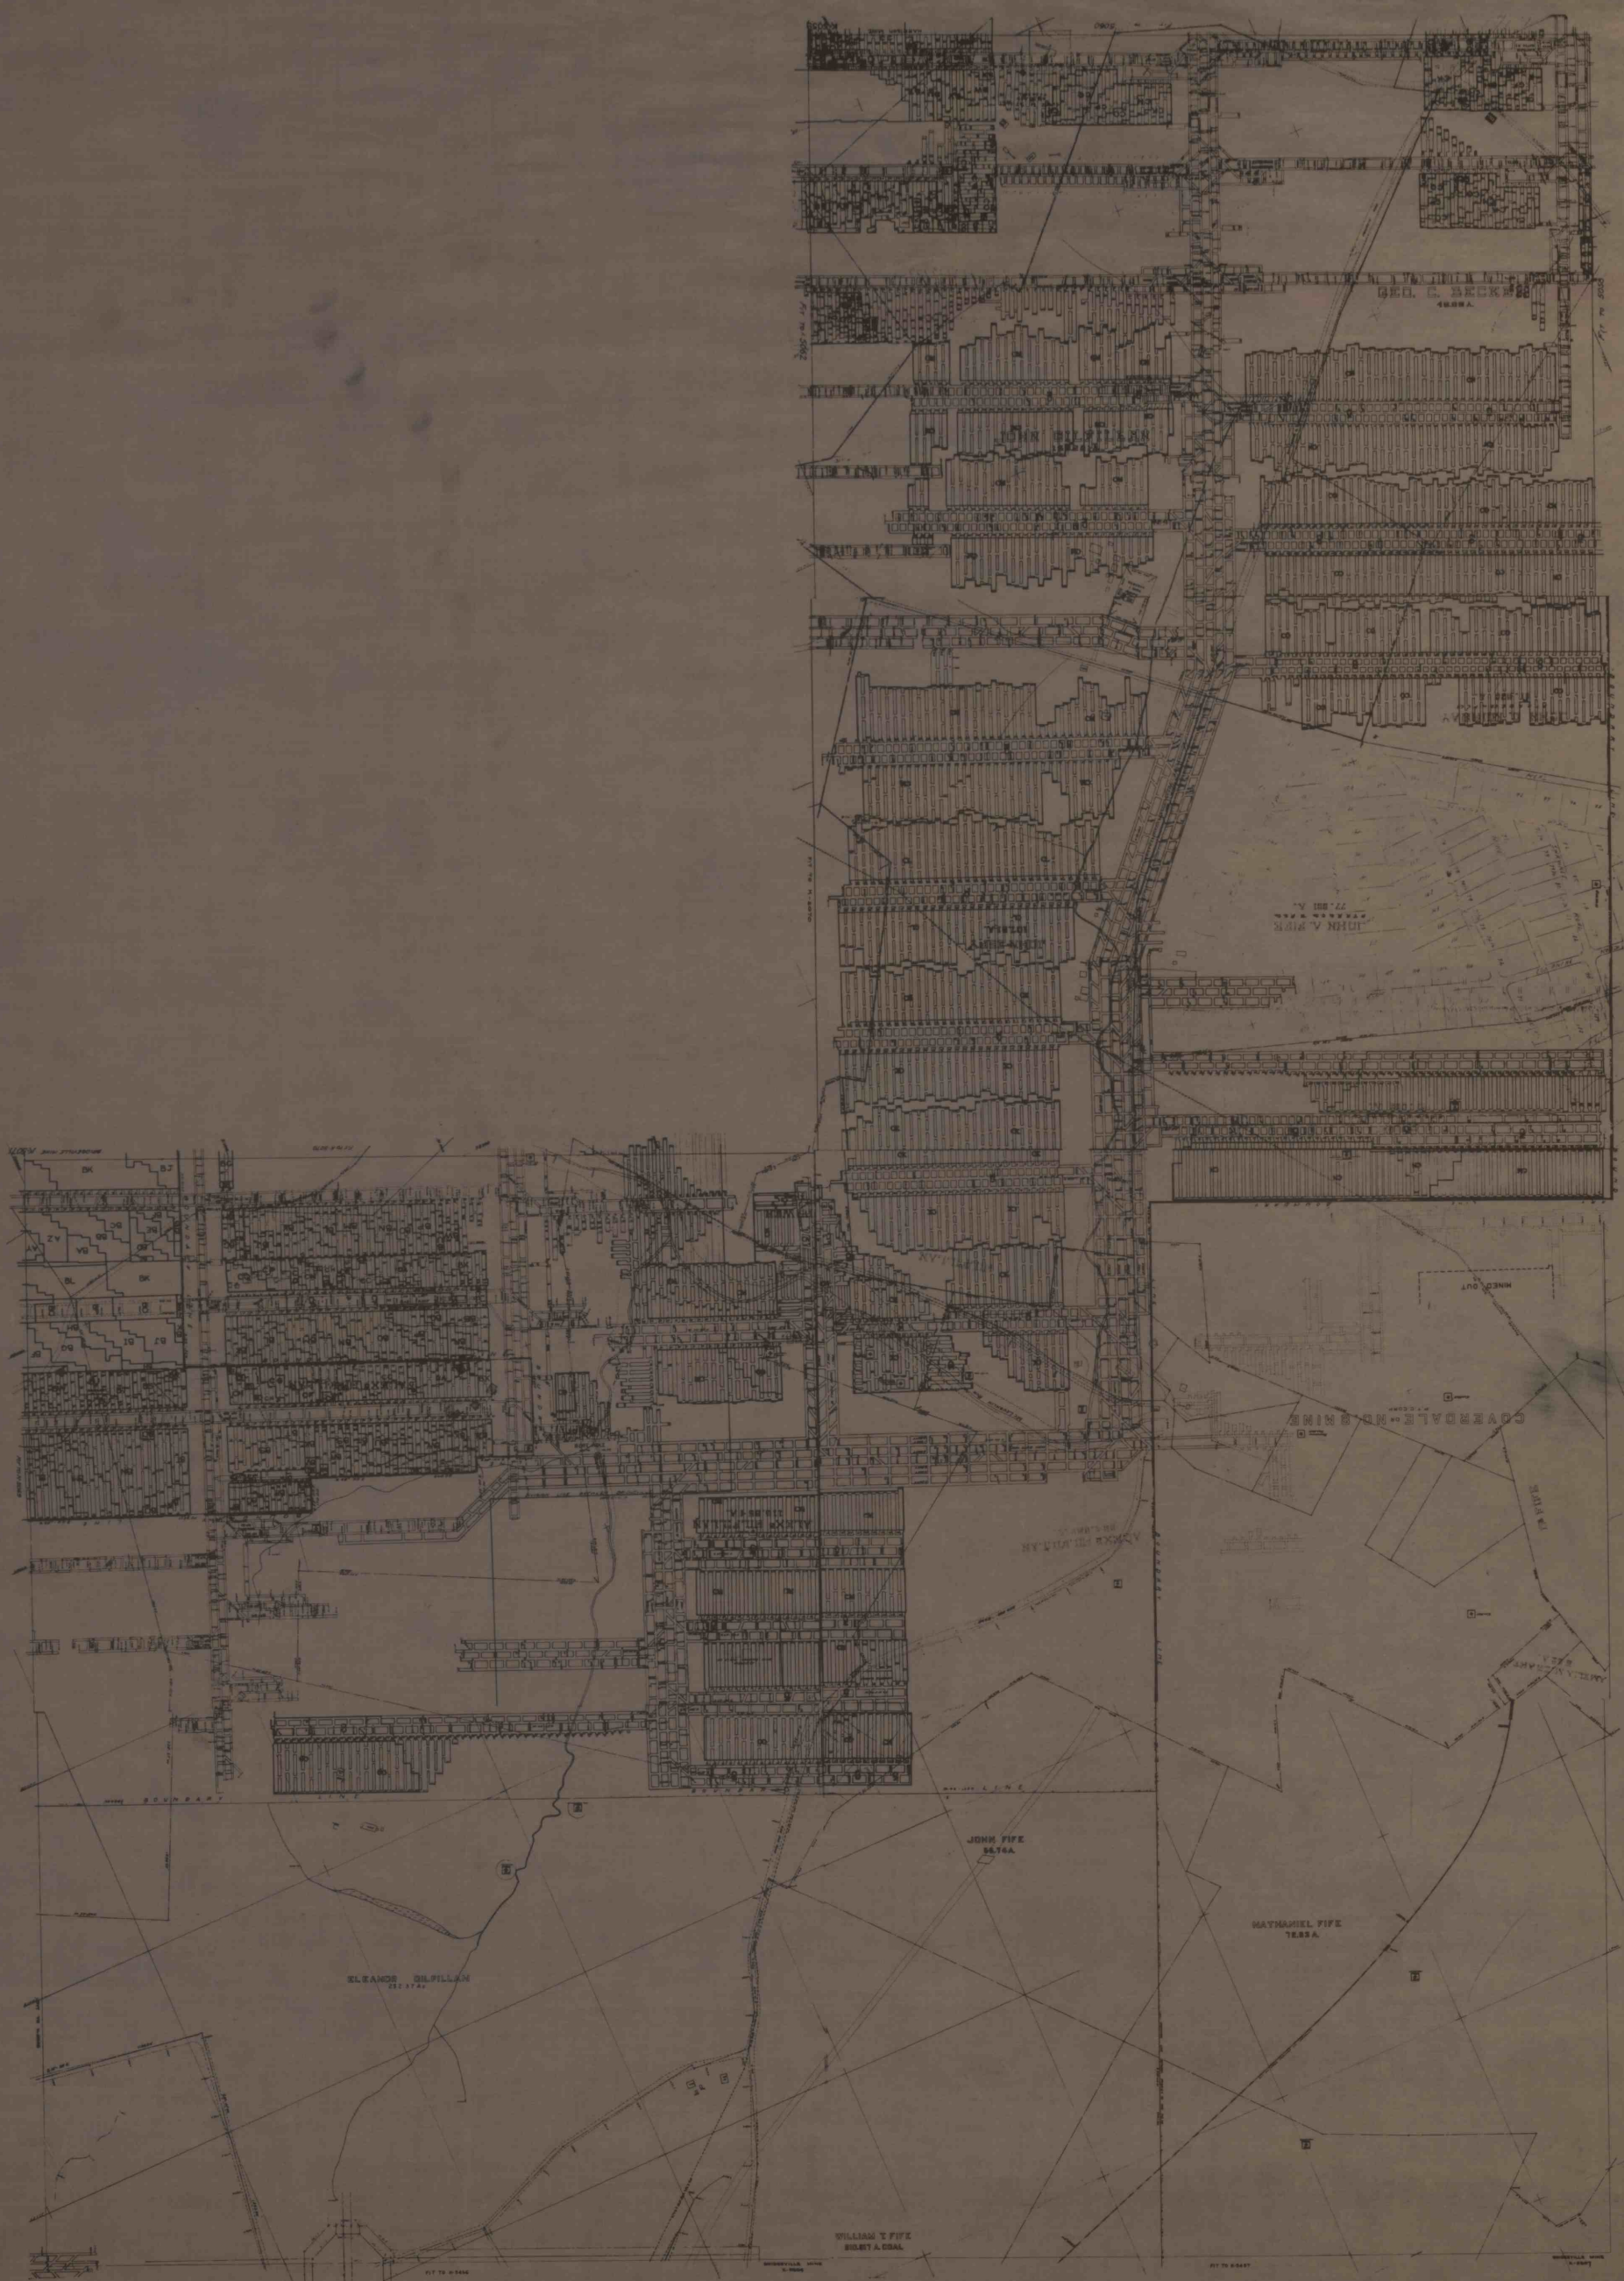
GEO. C. BECKER
JOHN A. FIFE
COVERDALE NO. 8 MINE
MINED OUT
JOHN FIFE
NATHANIEL FIFE
ELEANOR GILFILLAN
WILLIAM T. FIFE
SELECT A. COAL