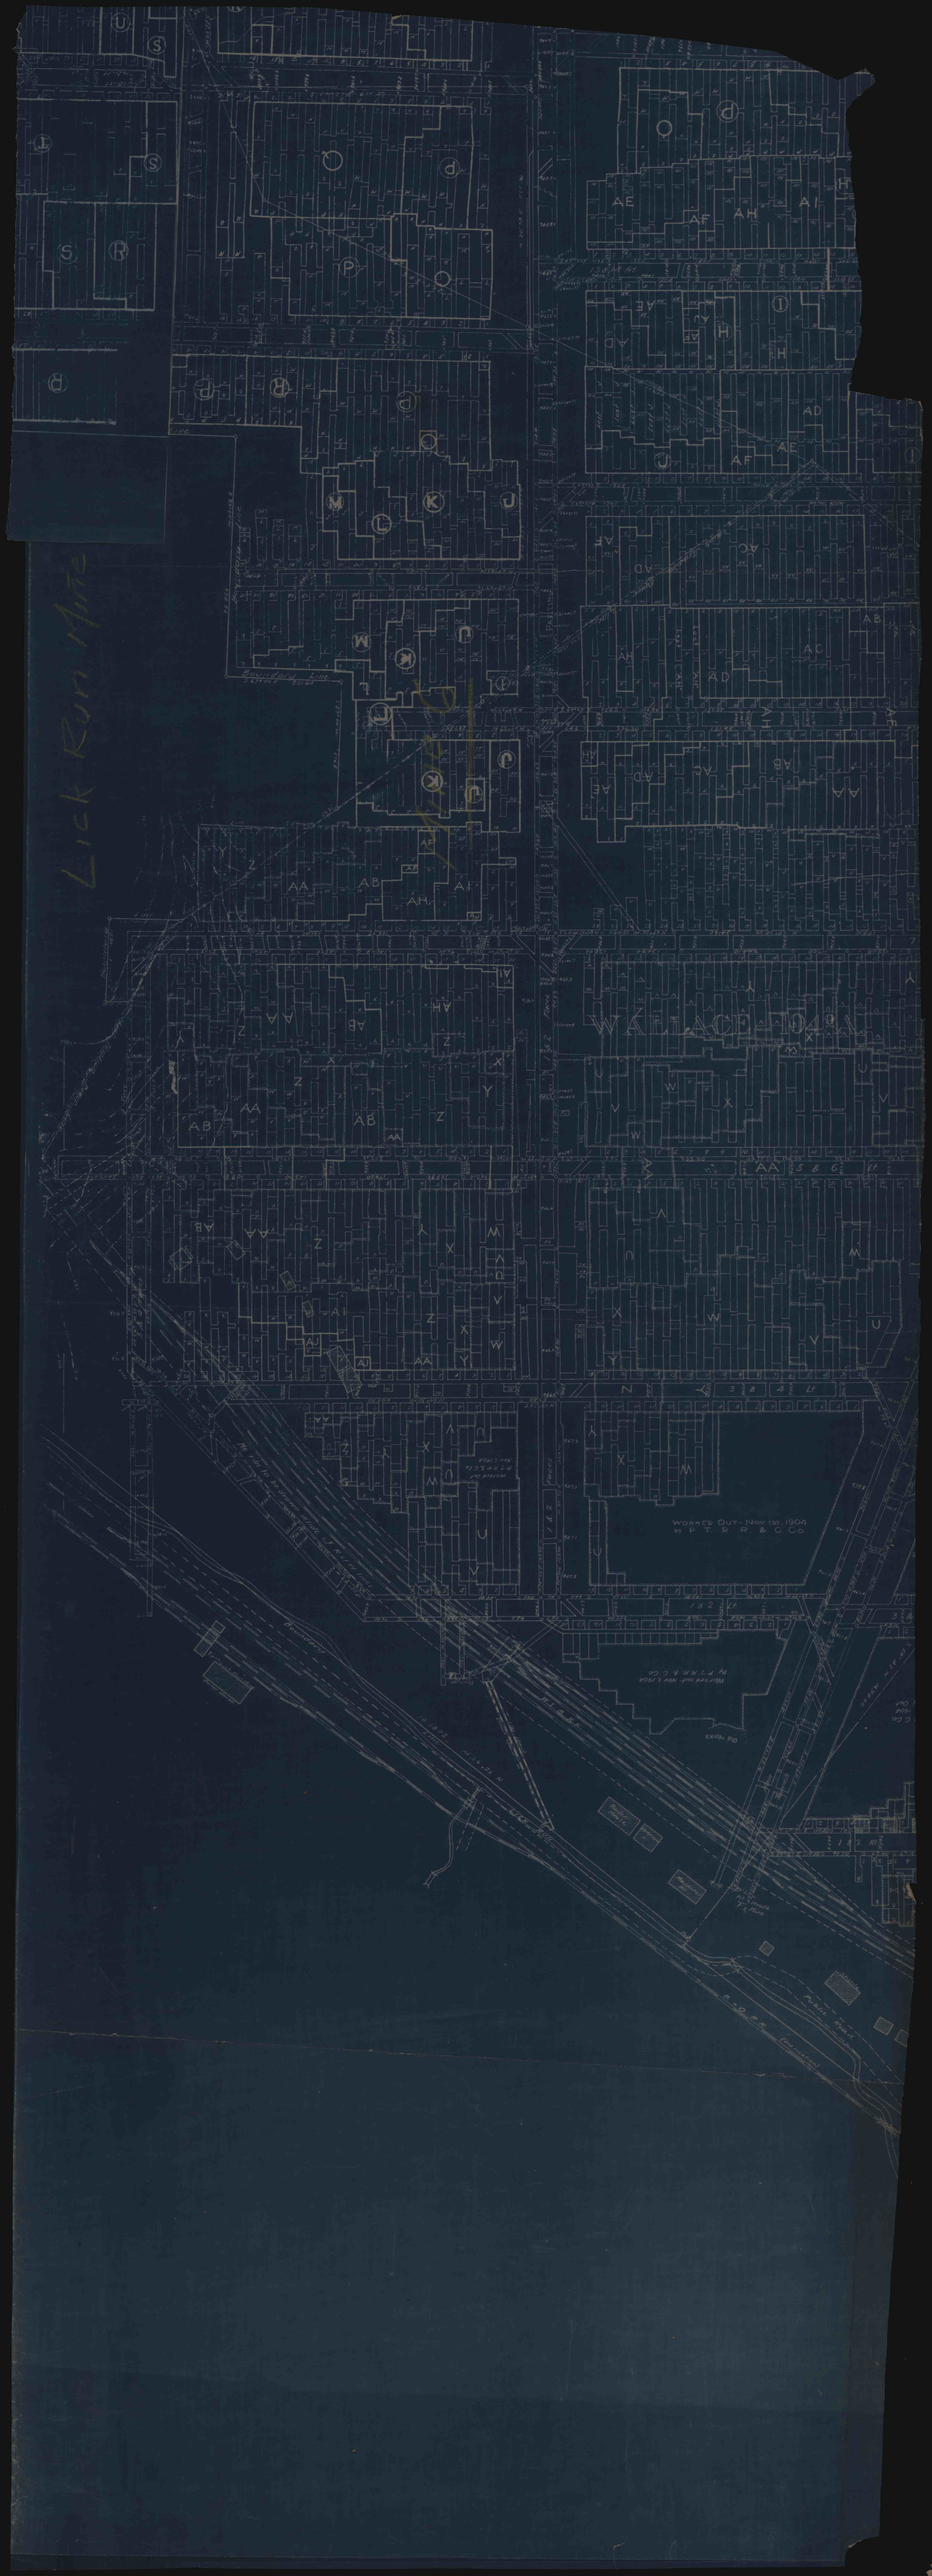
Lick Run Mine
WALLACE-TOWN
WORKED OUT - NOV 1st 1904
BY P. T. R. R. & C. Co.