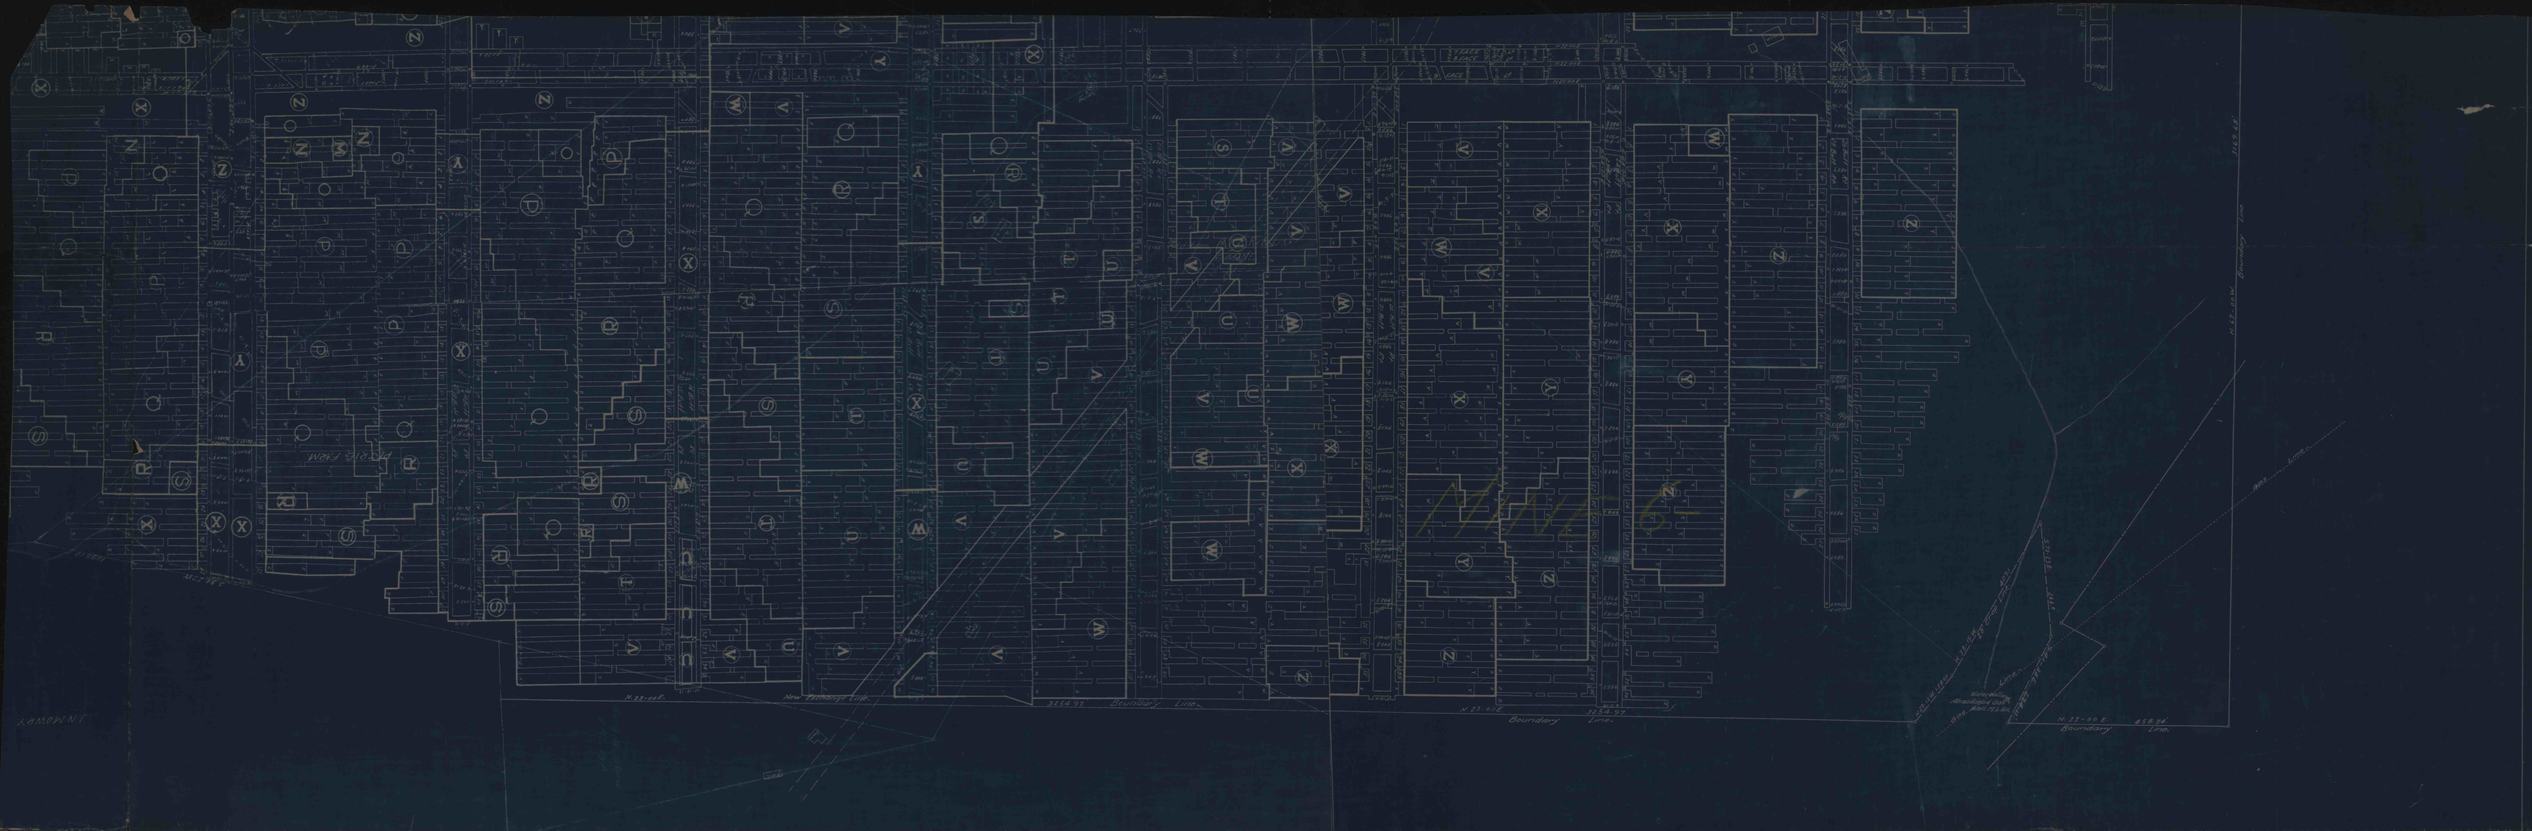


MINE No. 9