


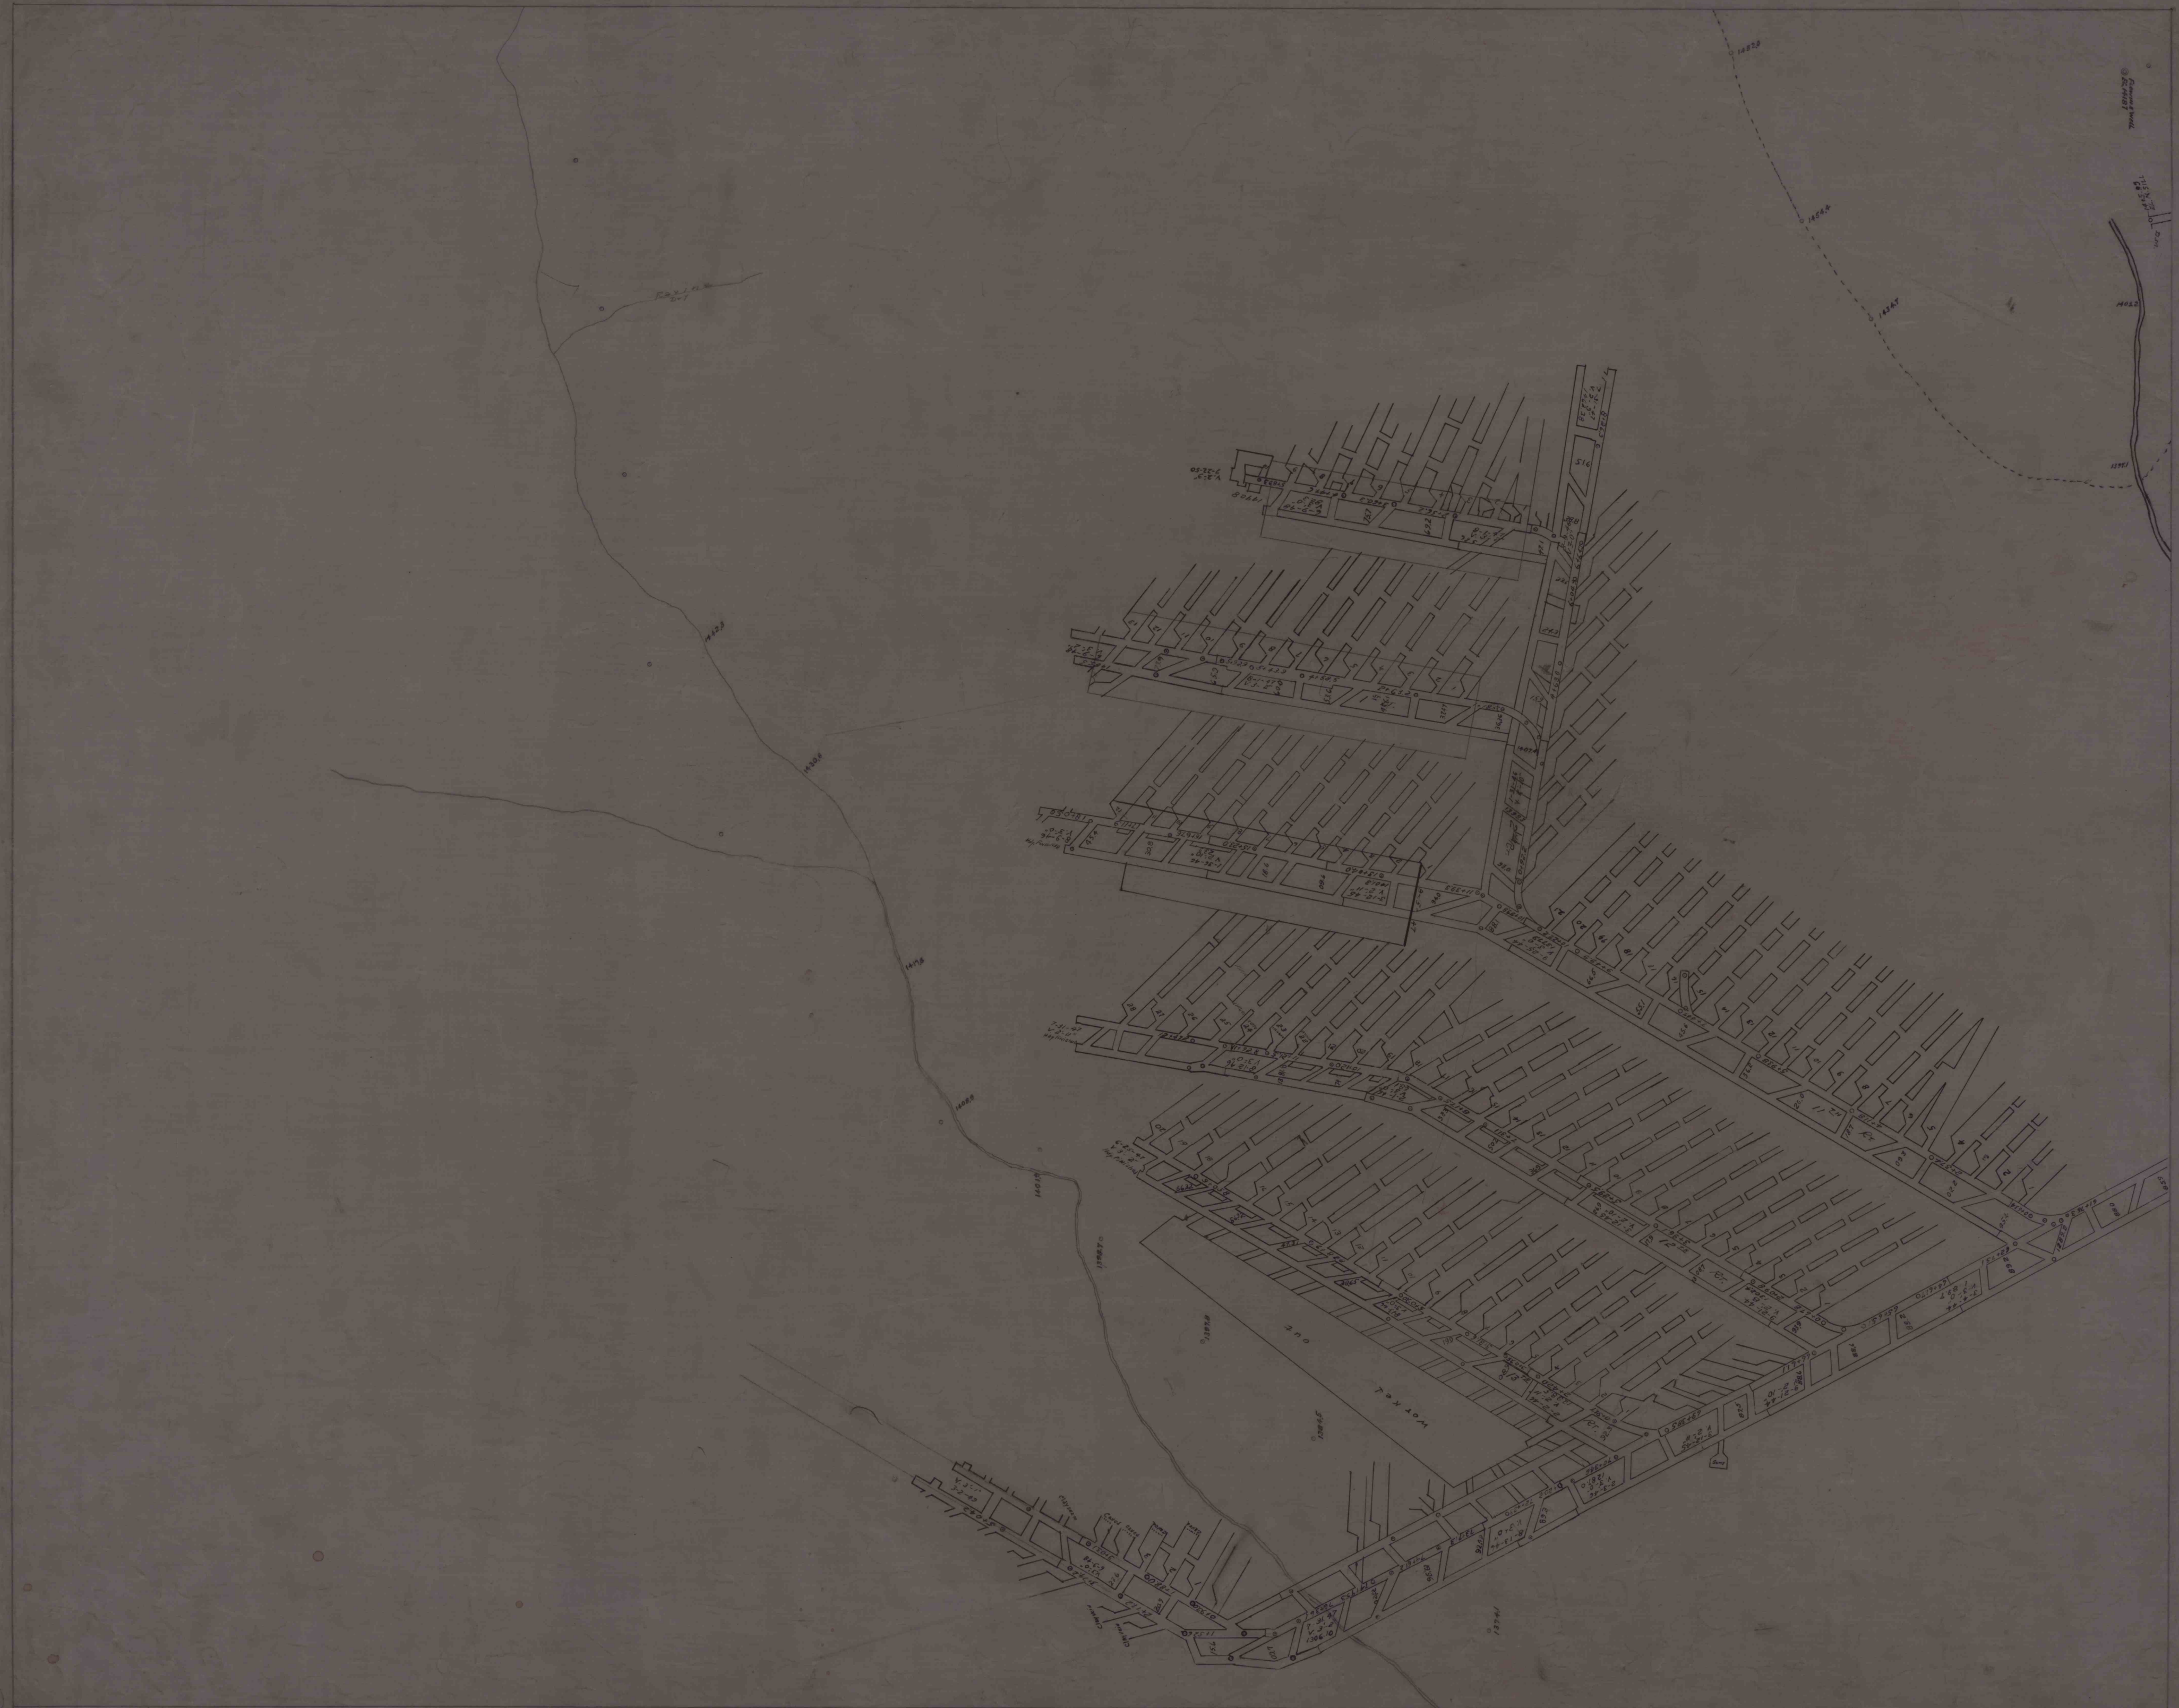

Inaps # 14706