


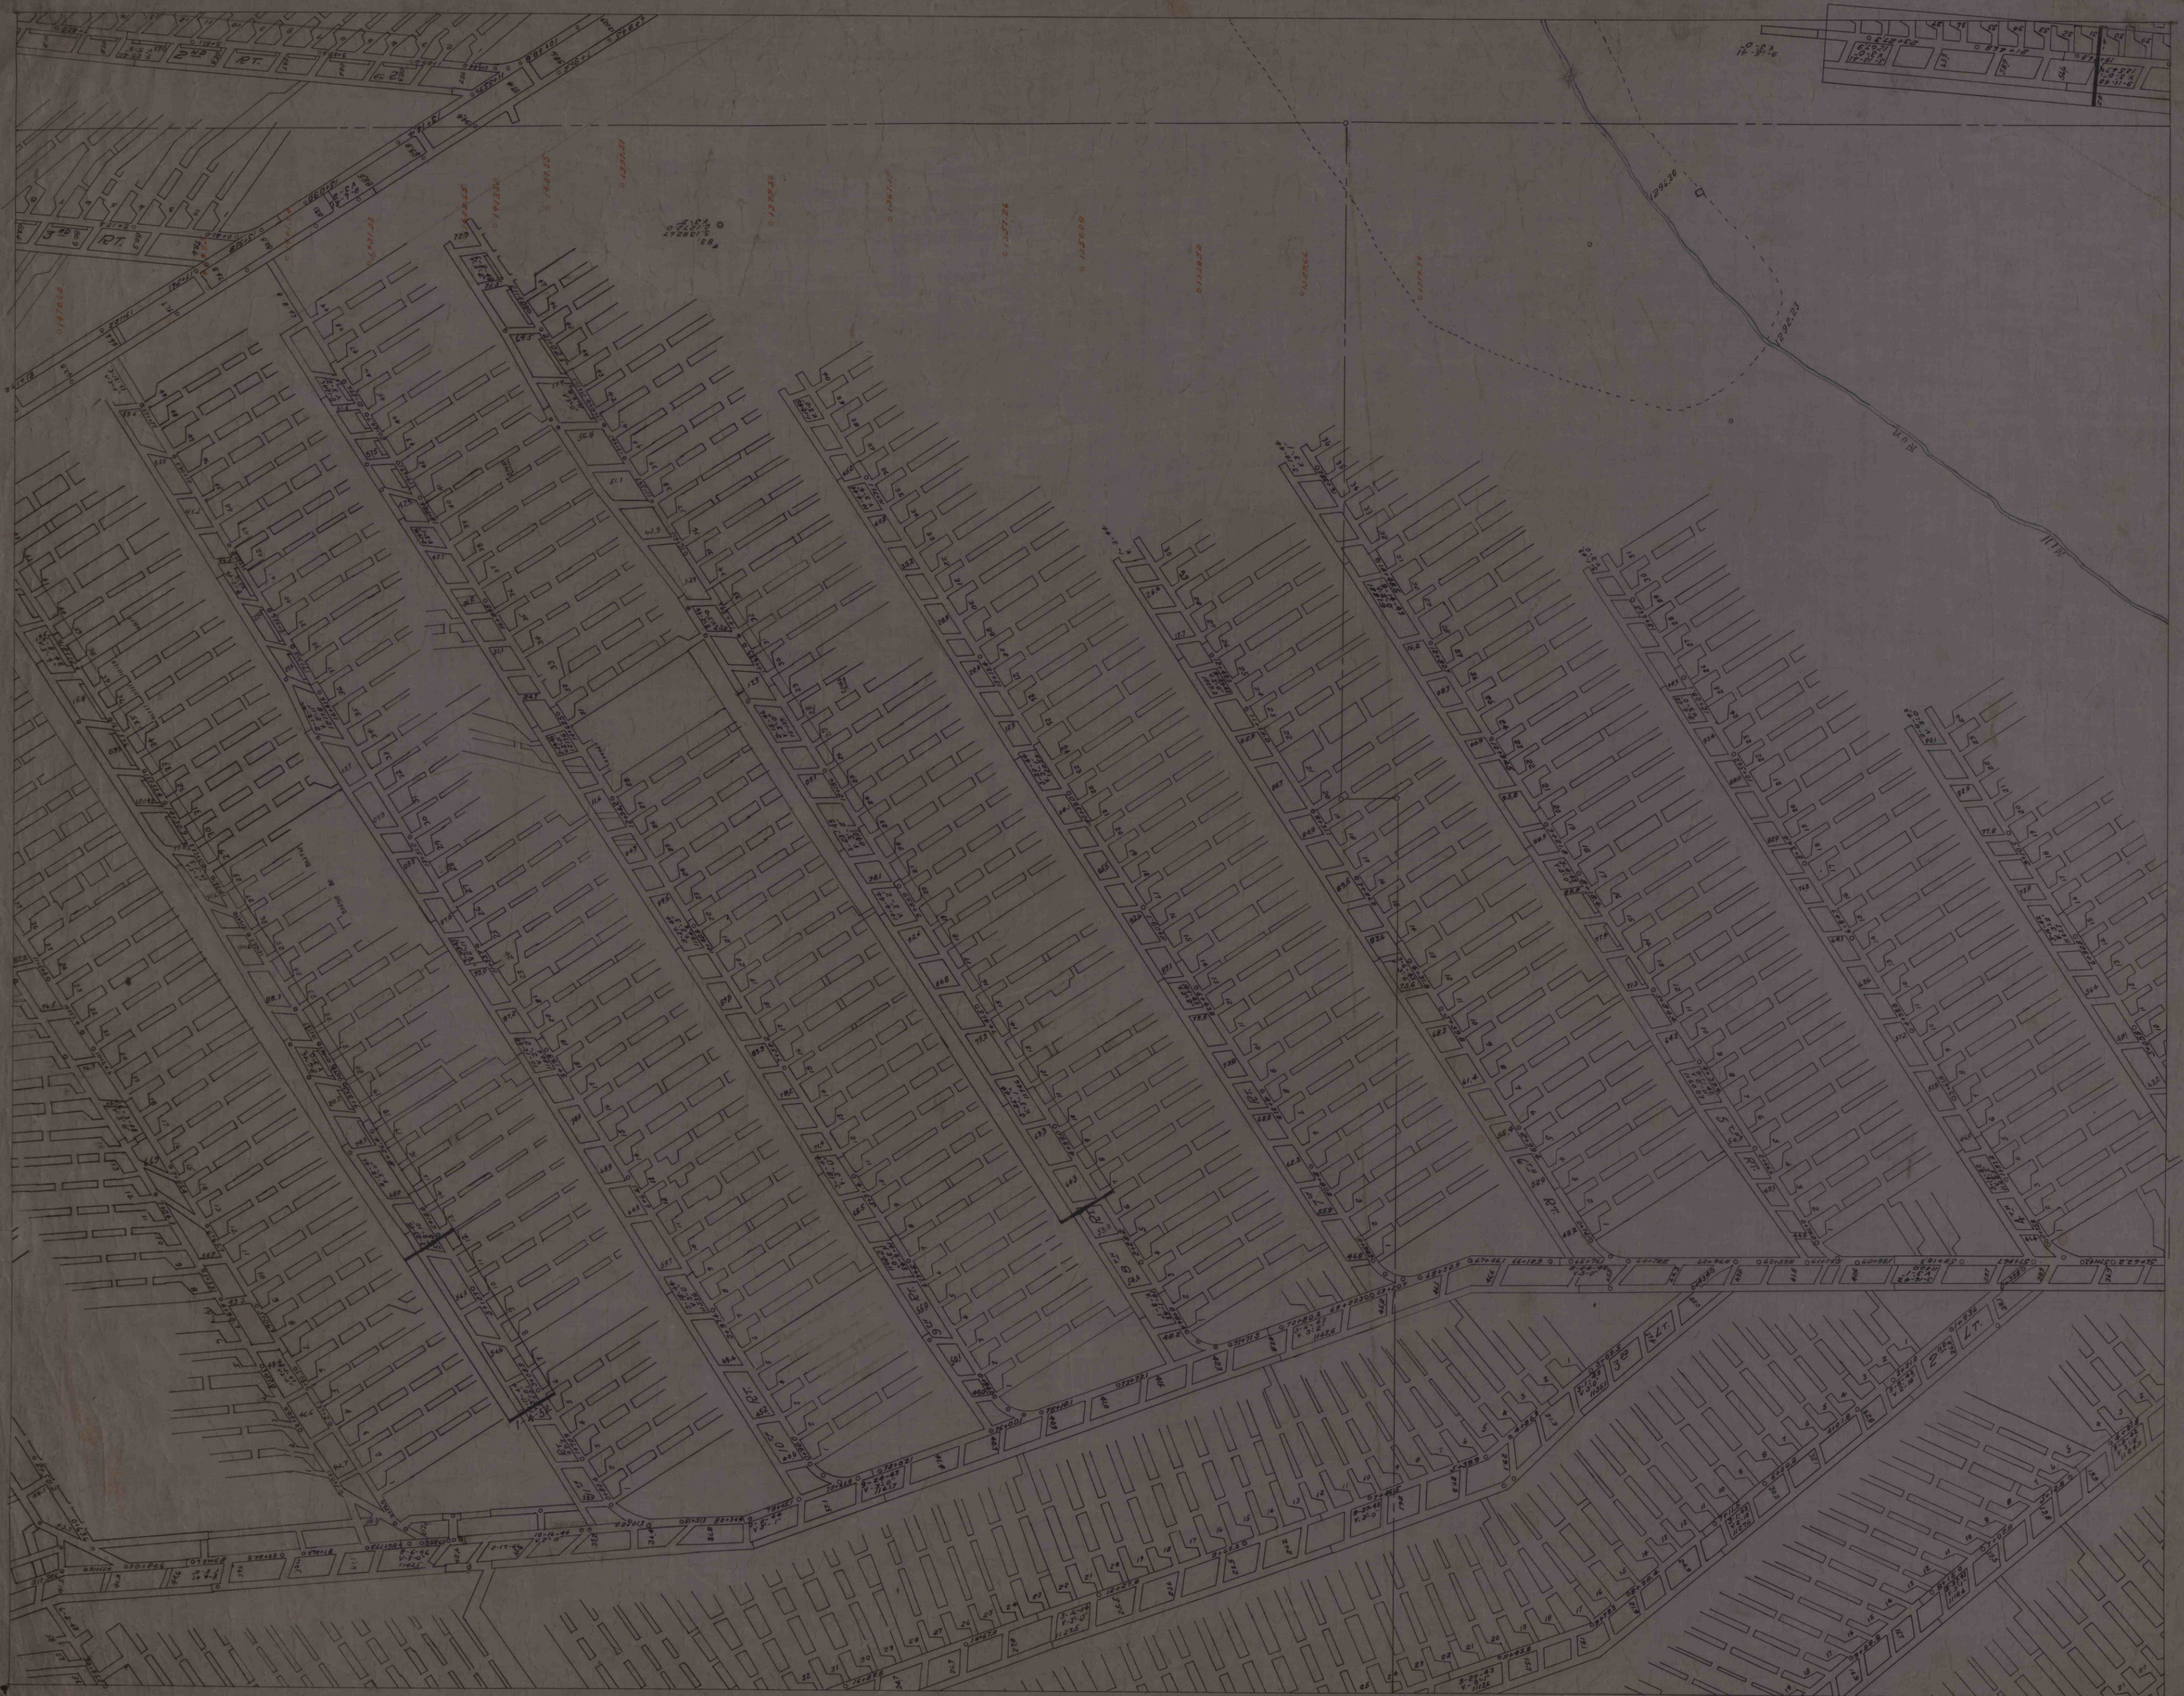

IMAPS# 14724

513M12