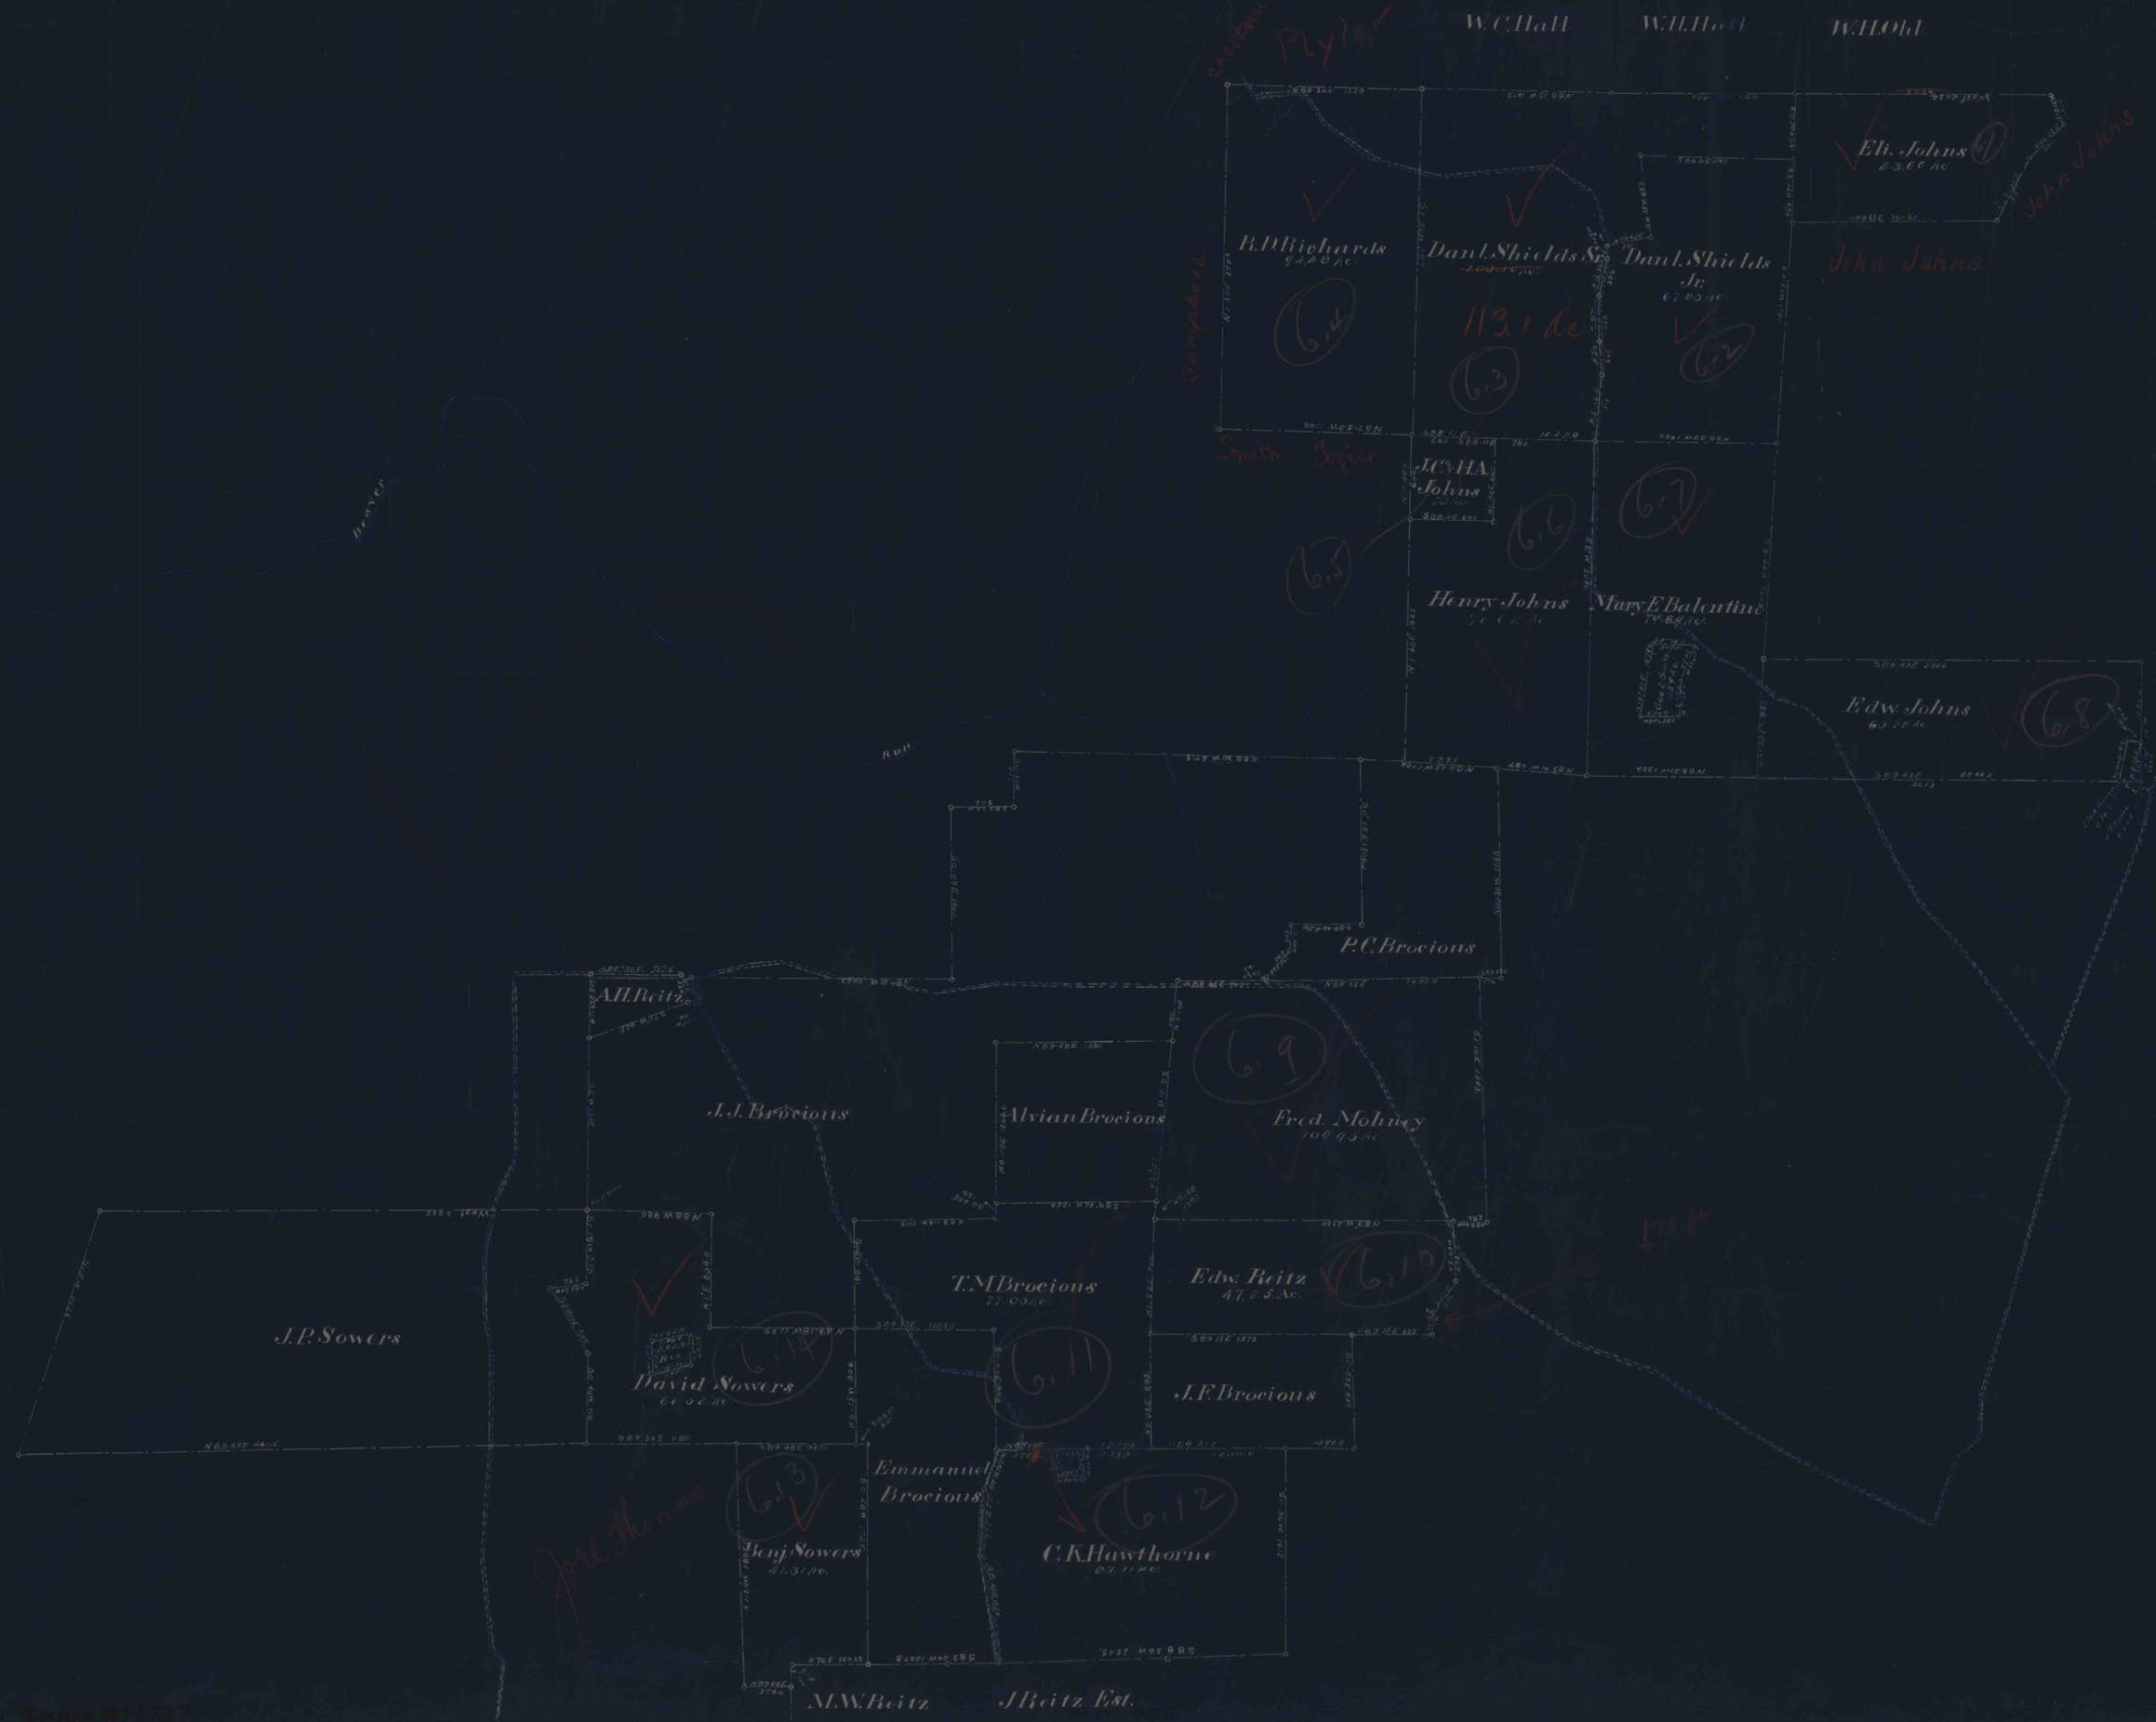BEAVER FIELD 6.1-6.14