


Bore Holes, Penetrating Middle Kittanning Measure
No 5 Mine. Shawmut Mining Company
Aug-22-1938

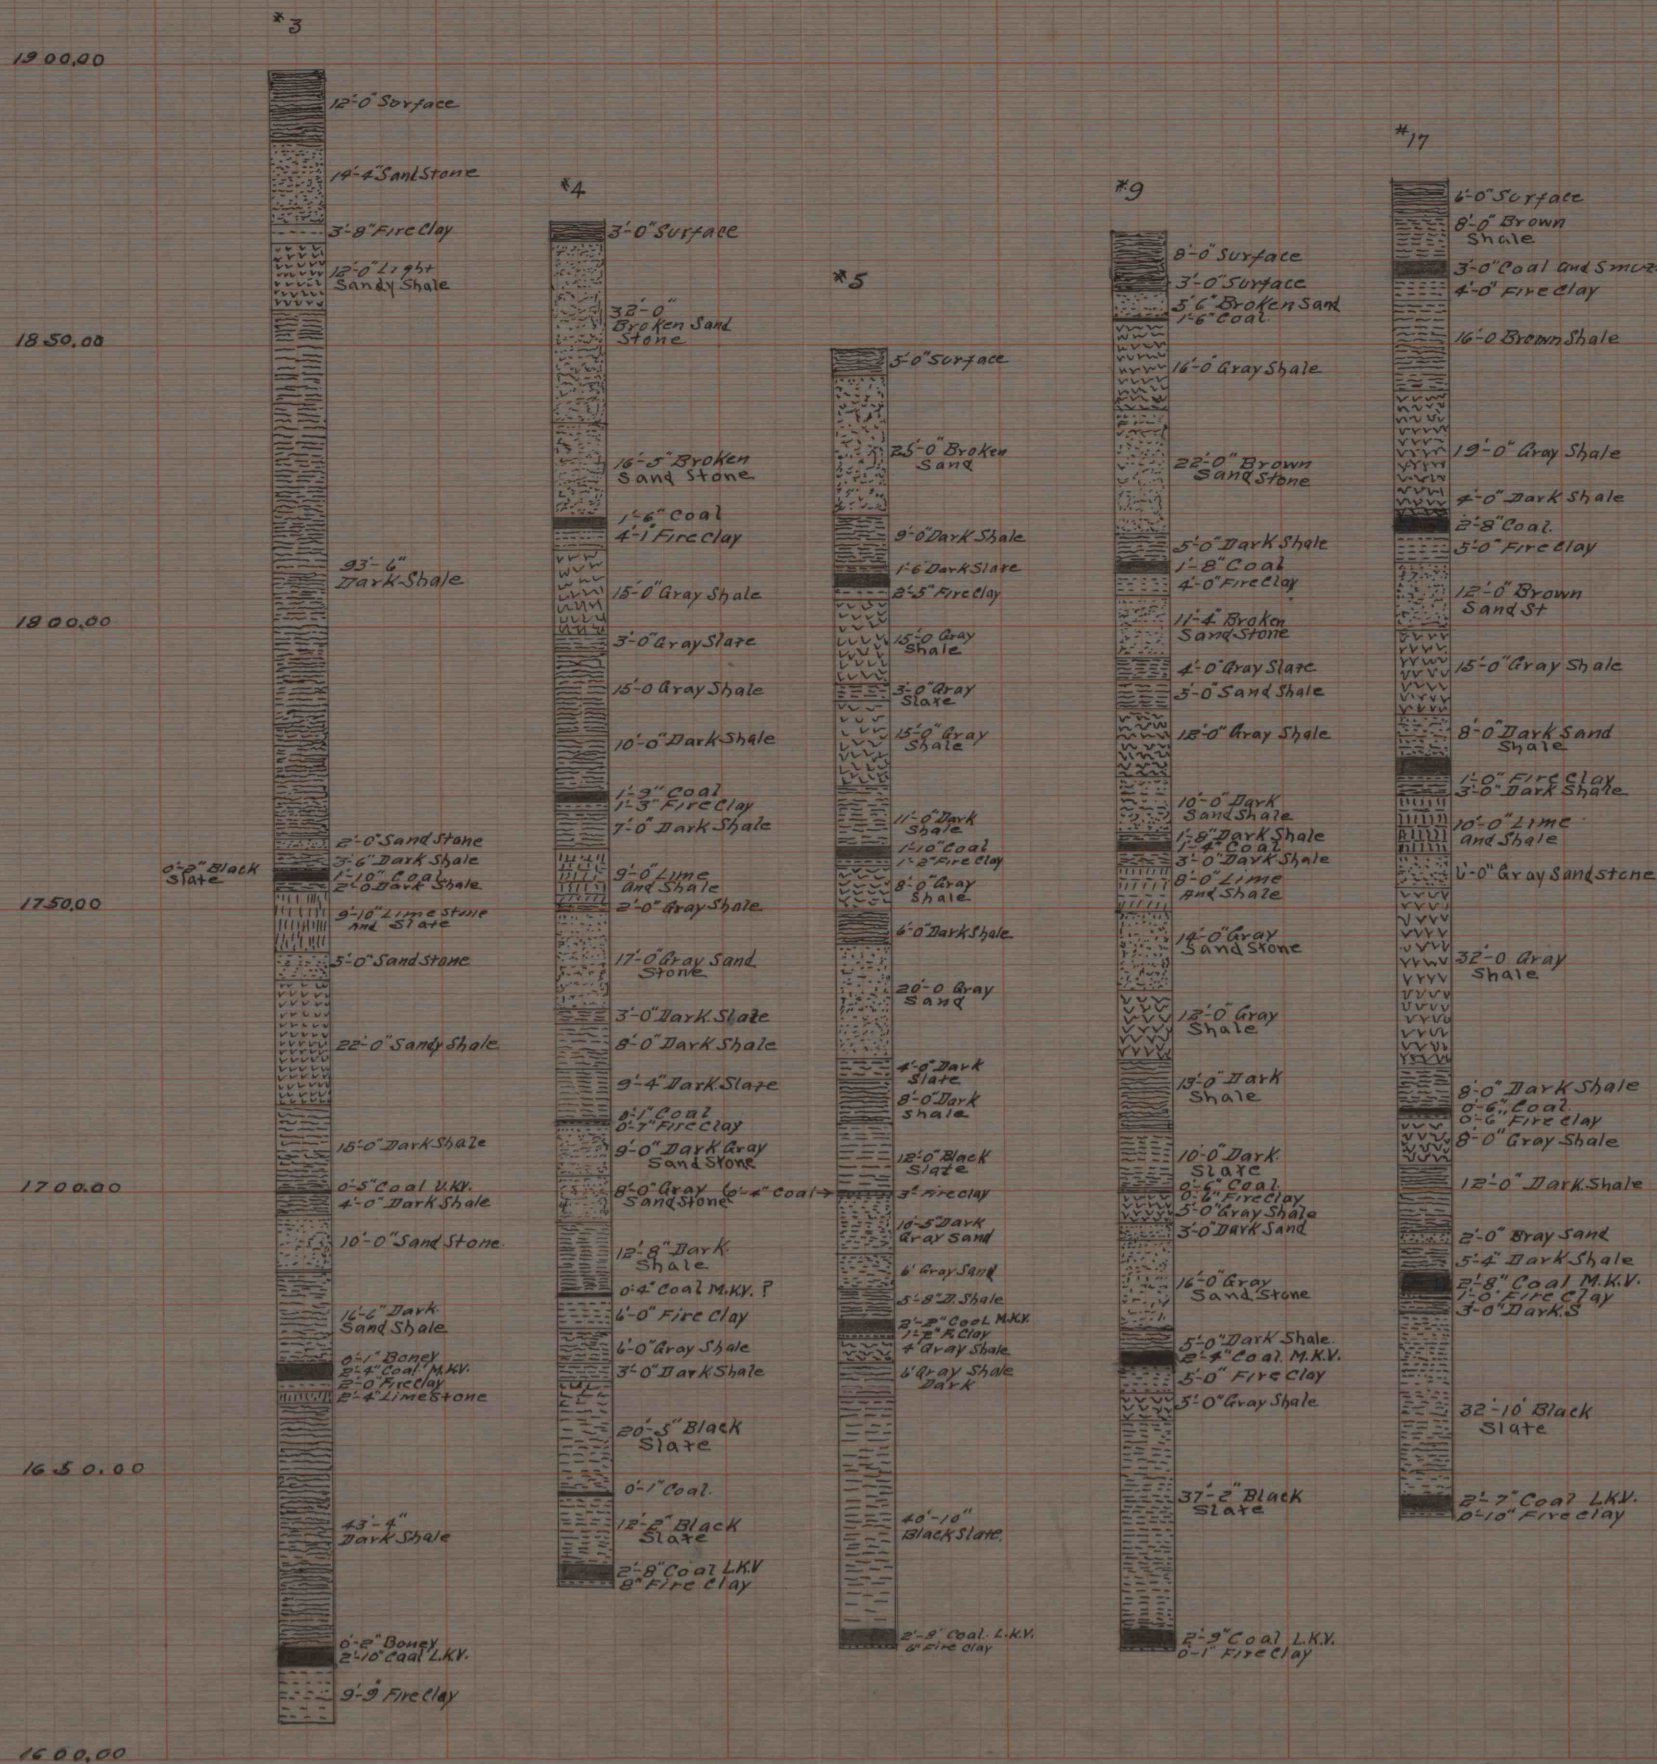

IMAPS # 14795