


— Power House - Ramsaytown —

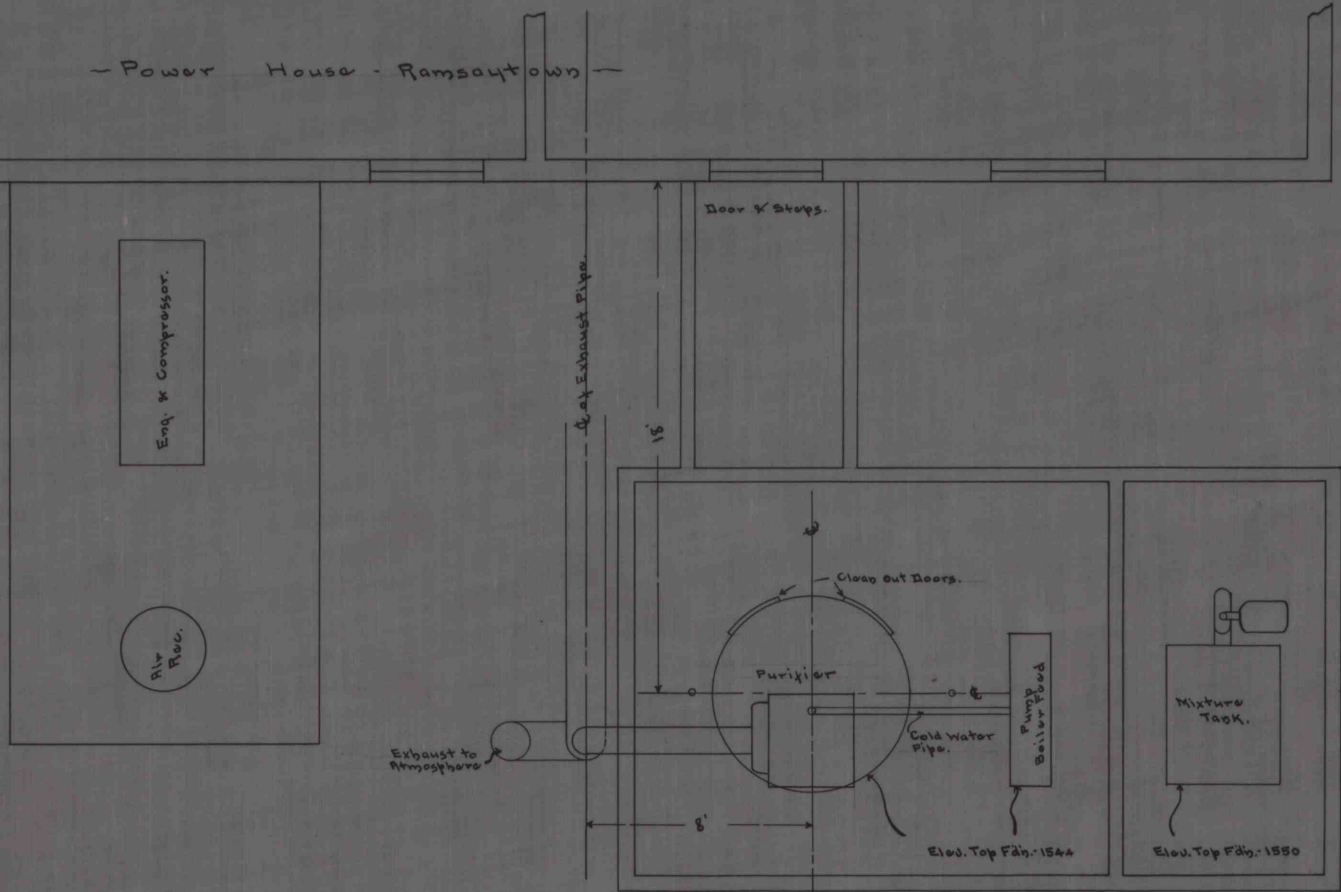

— S. M. Co. —
 Sketch showing location of Heater House
 at Ramsay Power Plant.
 Scale $\frac{1}{4}'' = 1'$
 1-5-16