


SHAWMUT MINING CO




#5 MINE

Room #20 off Old 7th Right Heading
Showing point at which Joe Martini was Killed Dec. 14, 1909
Fox Township, Elk Co., Pa.

* - Showing point where accident occurred.

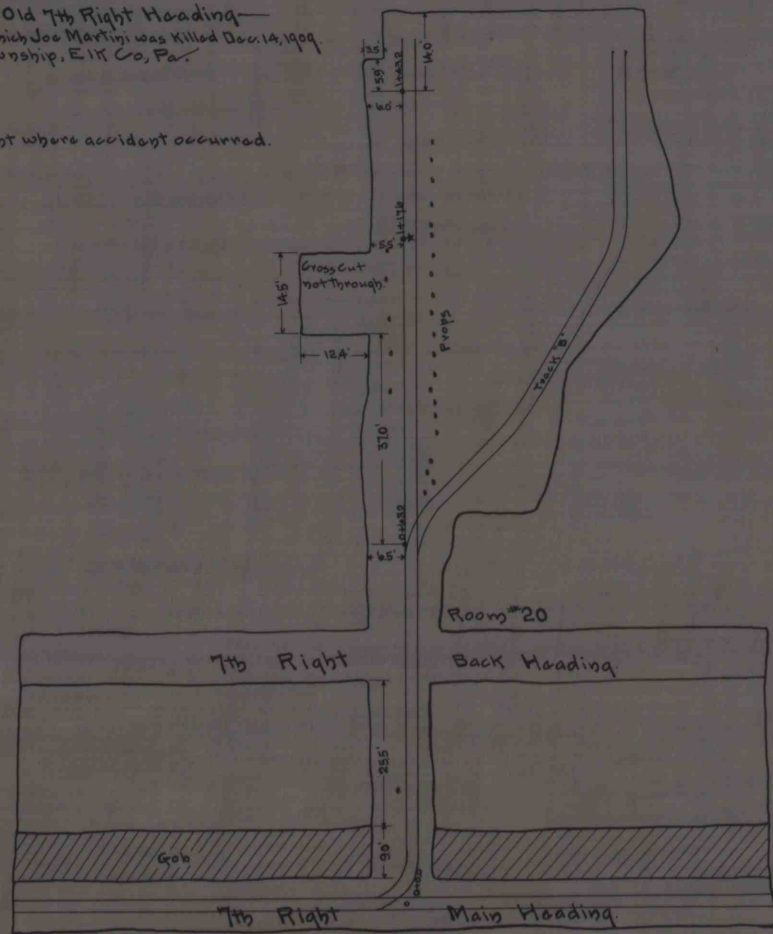

— PLAN —
Scale - 20 feet = 1 inch.

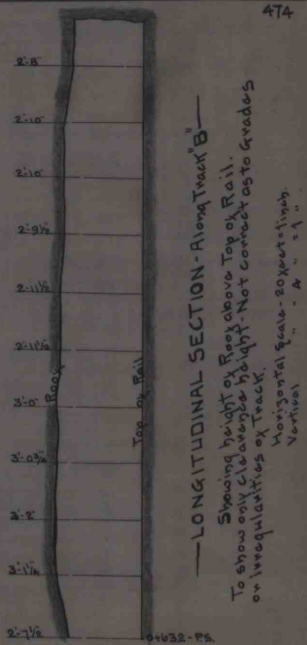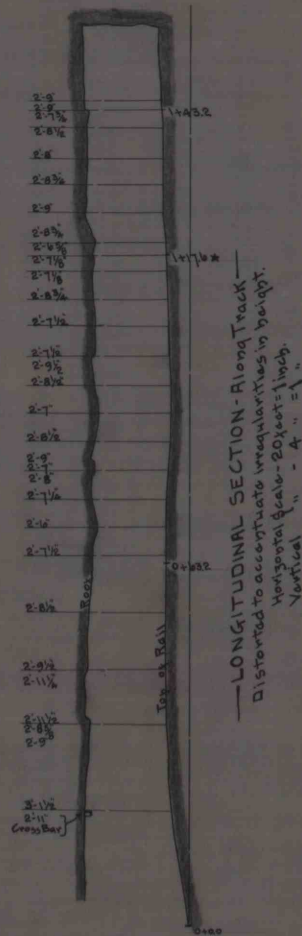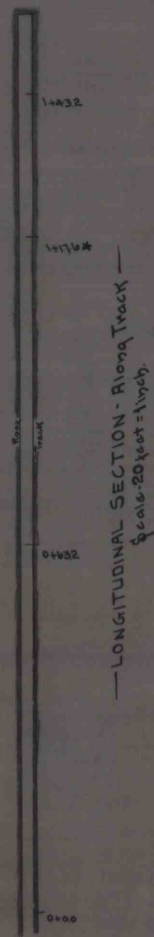

SMASH 14802

Number - 474
Date - Jan. 12, 1910.
Scale - As shown.
Drawn by - P.A.
Correct - *W. H. ...*
Cony Engr.