



N^o 42 Mine.
 Switch in 1st Left N^o 3.

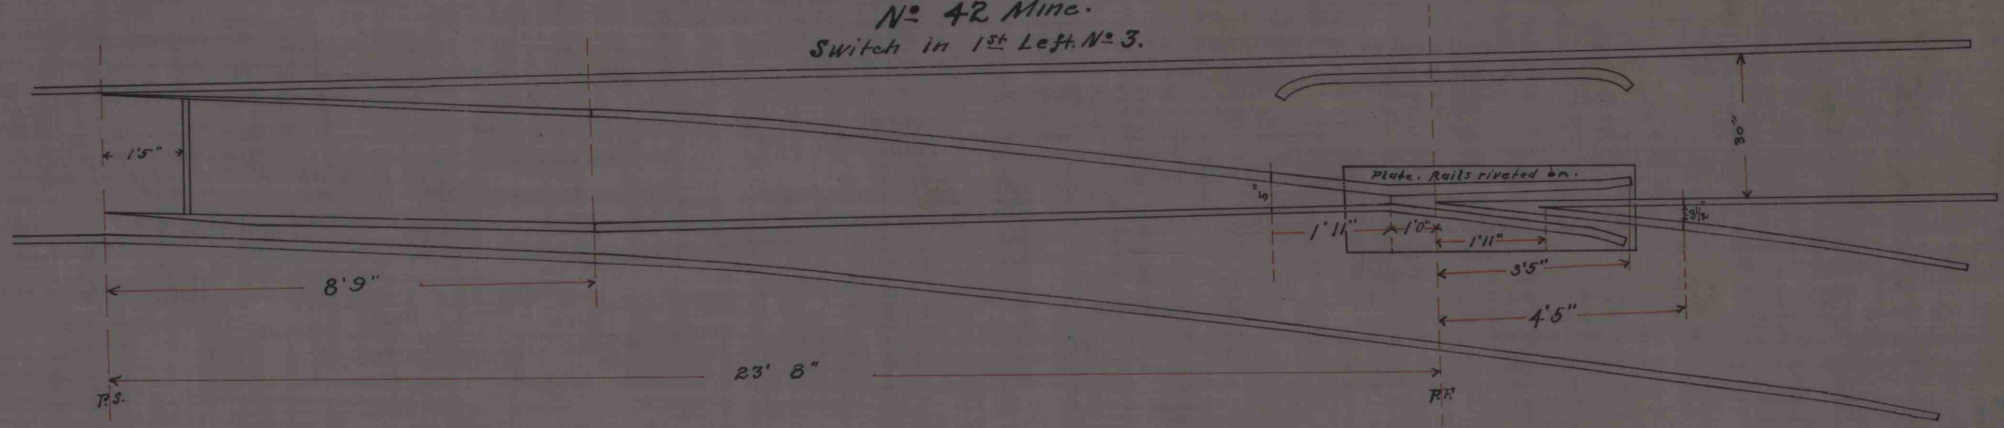

N^o 31 Mine.
 Switch on Main Haulage.

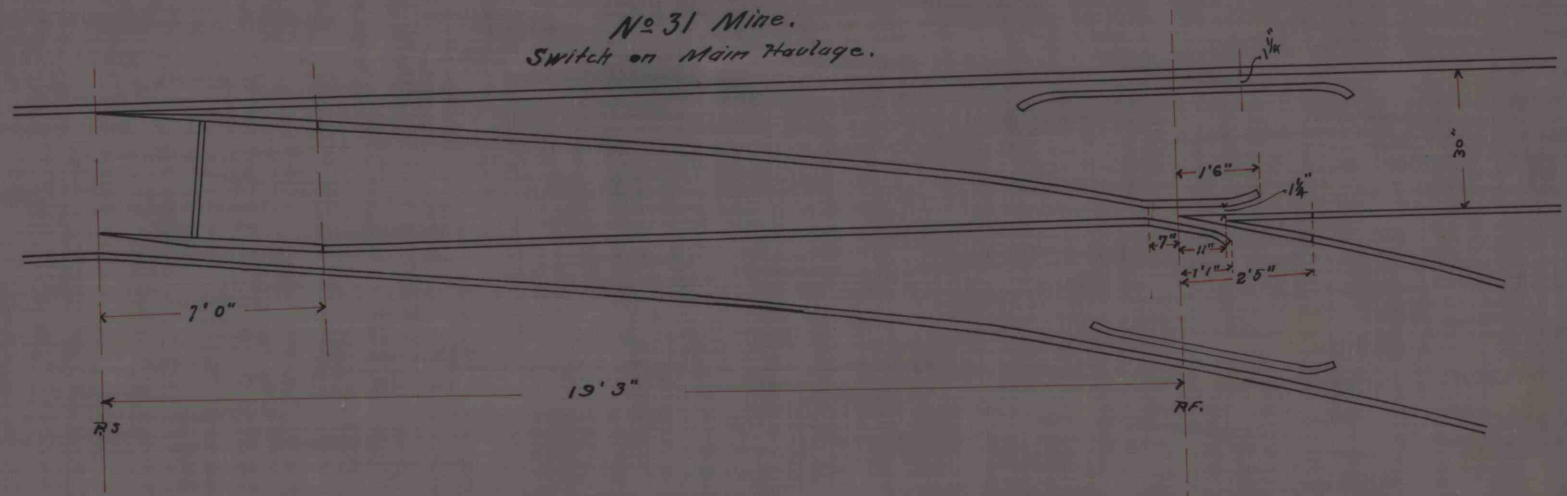

Scale $\frac{1}{2}'' = 1'0''$
 CH

IMAPS # 14805