


A. S M I T H E S T A T E

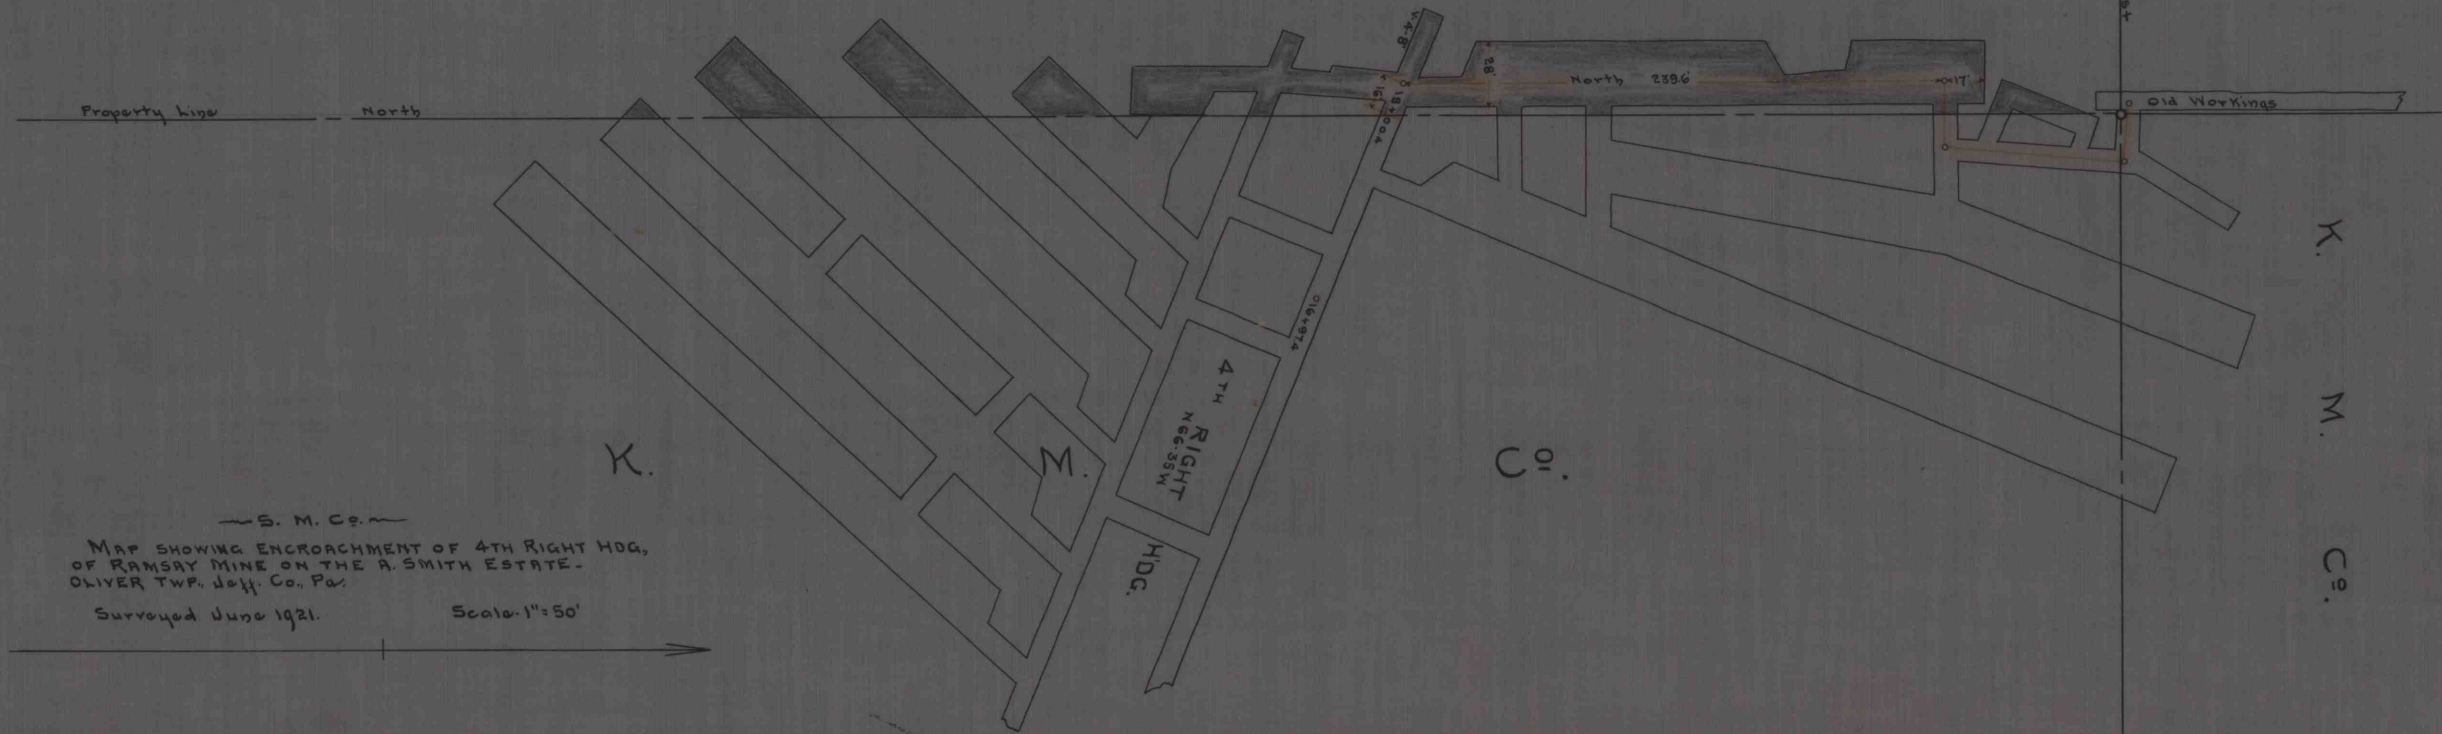

MAP SHOWING ENCROACHMENT OF 4TH RIGHT HDG,
OF RAMSAY MINE ON THE A. SMITH ESTATE.
OLIVER TWP, Jeff. Co., Pa.

Surveyed June 1921.

Scale 1"=50'