




PROCTOR

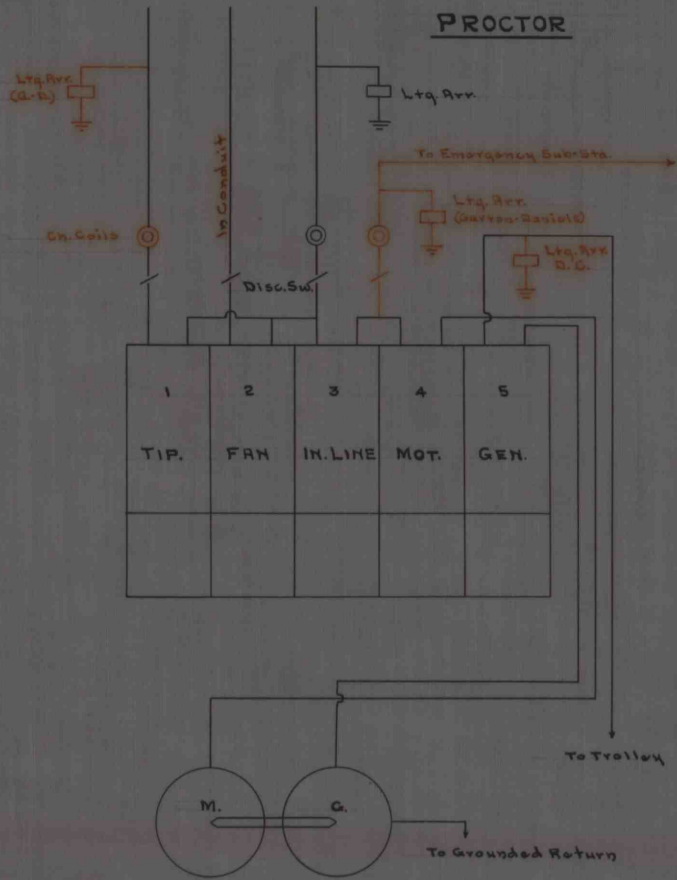

Nº 42

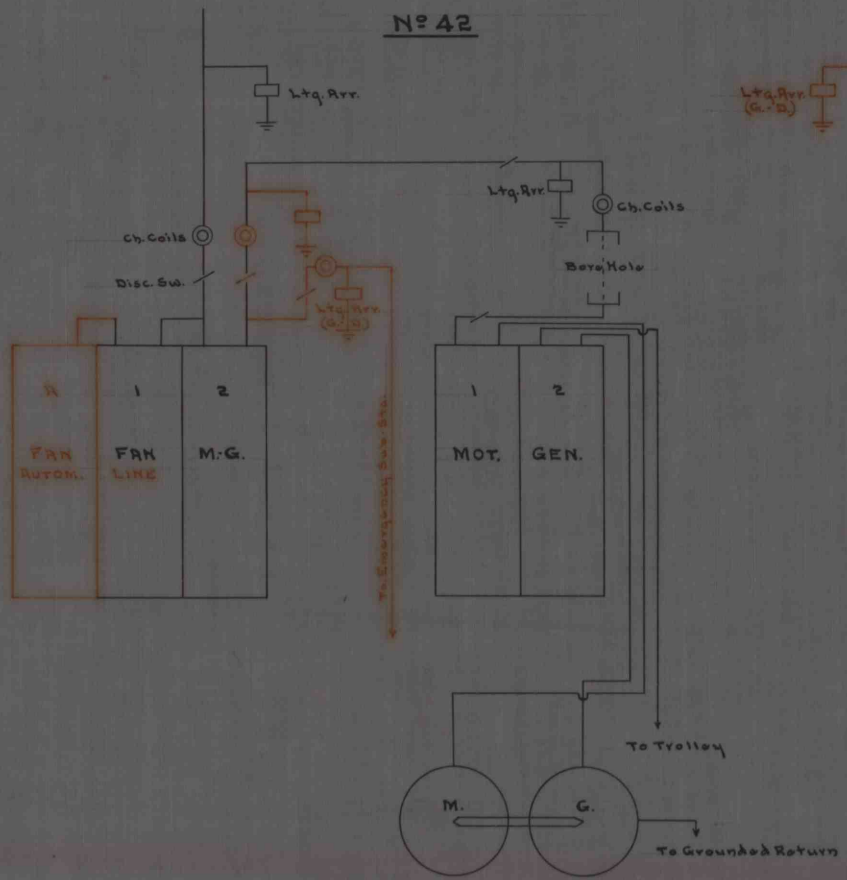

Nº 31

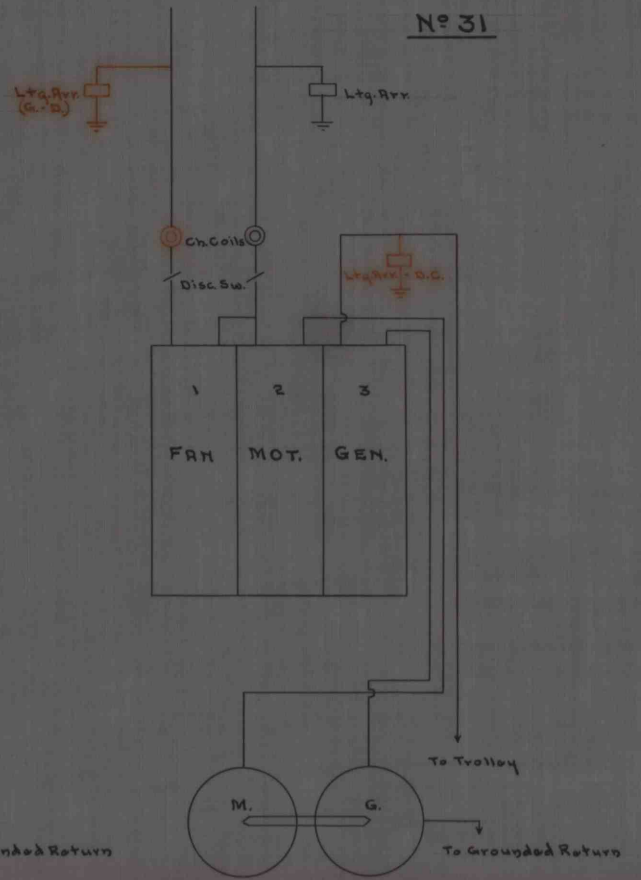

— SHAWMUT MINING CO. —
 Schematic Diagram.
 CHARLES M. MEARS Co. CON. ENGRS.
 DR. Nº 1262 Oct. 9 - 1924.
 Additions by W.R.C. Nov. 19 - "