


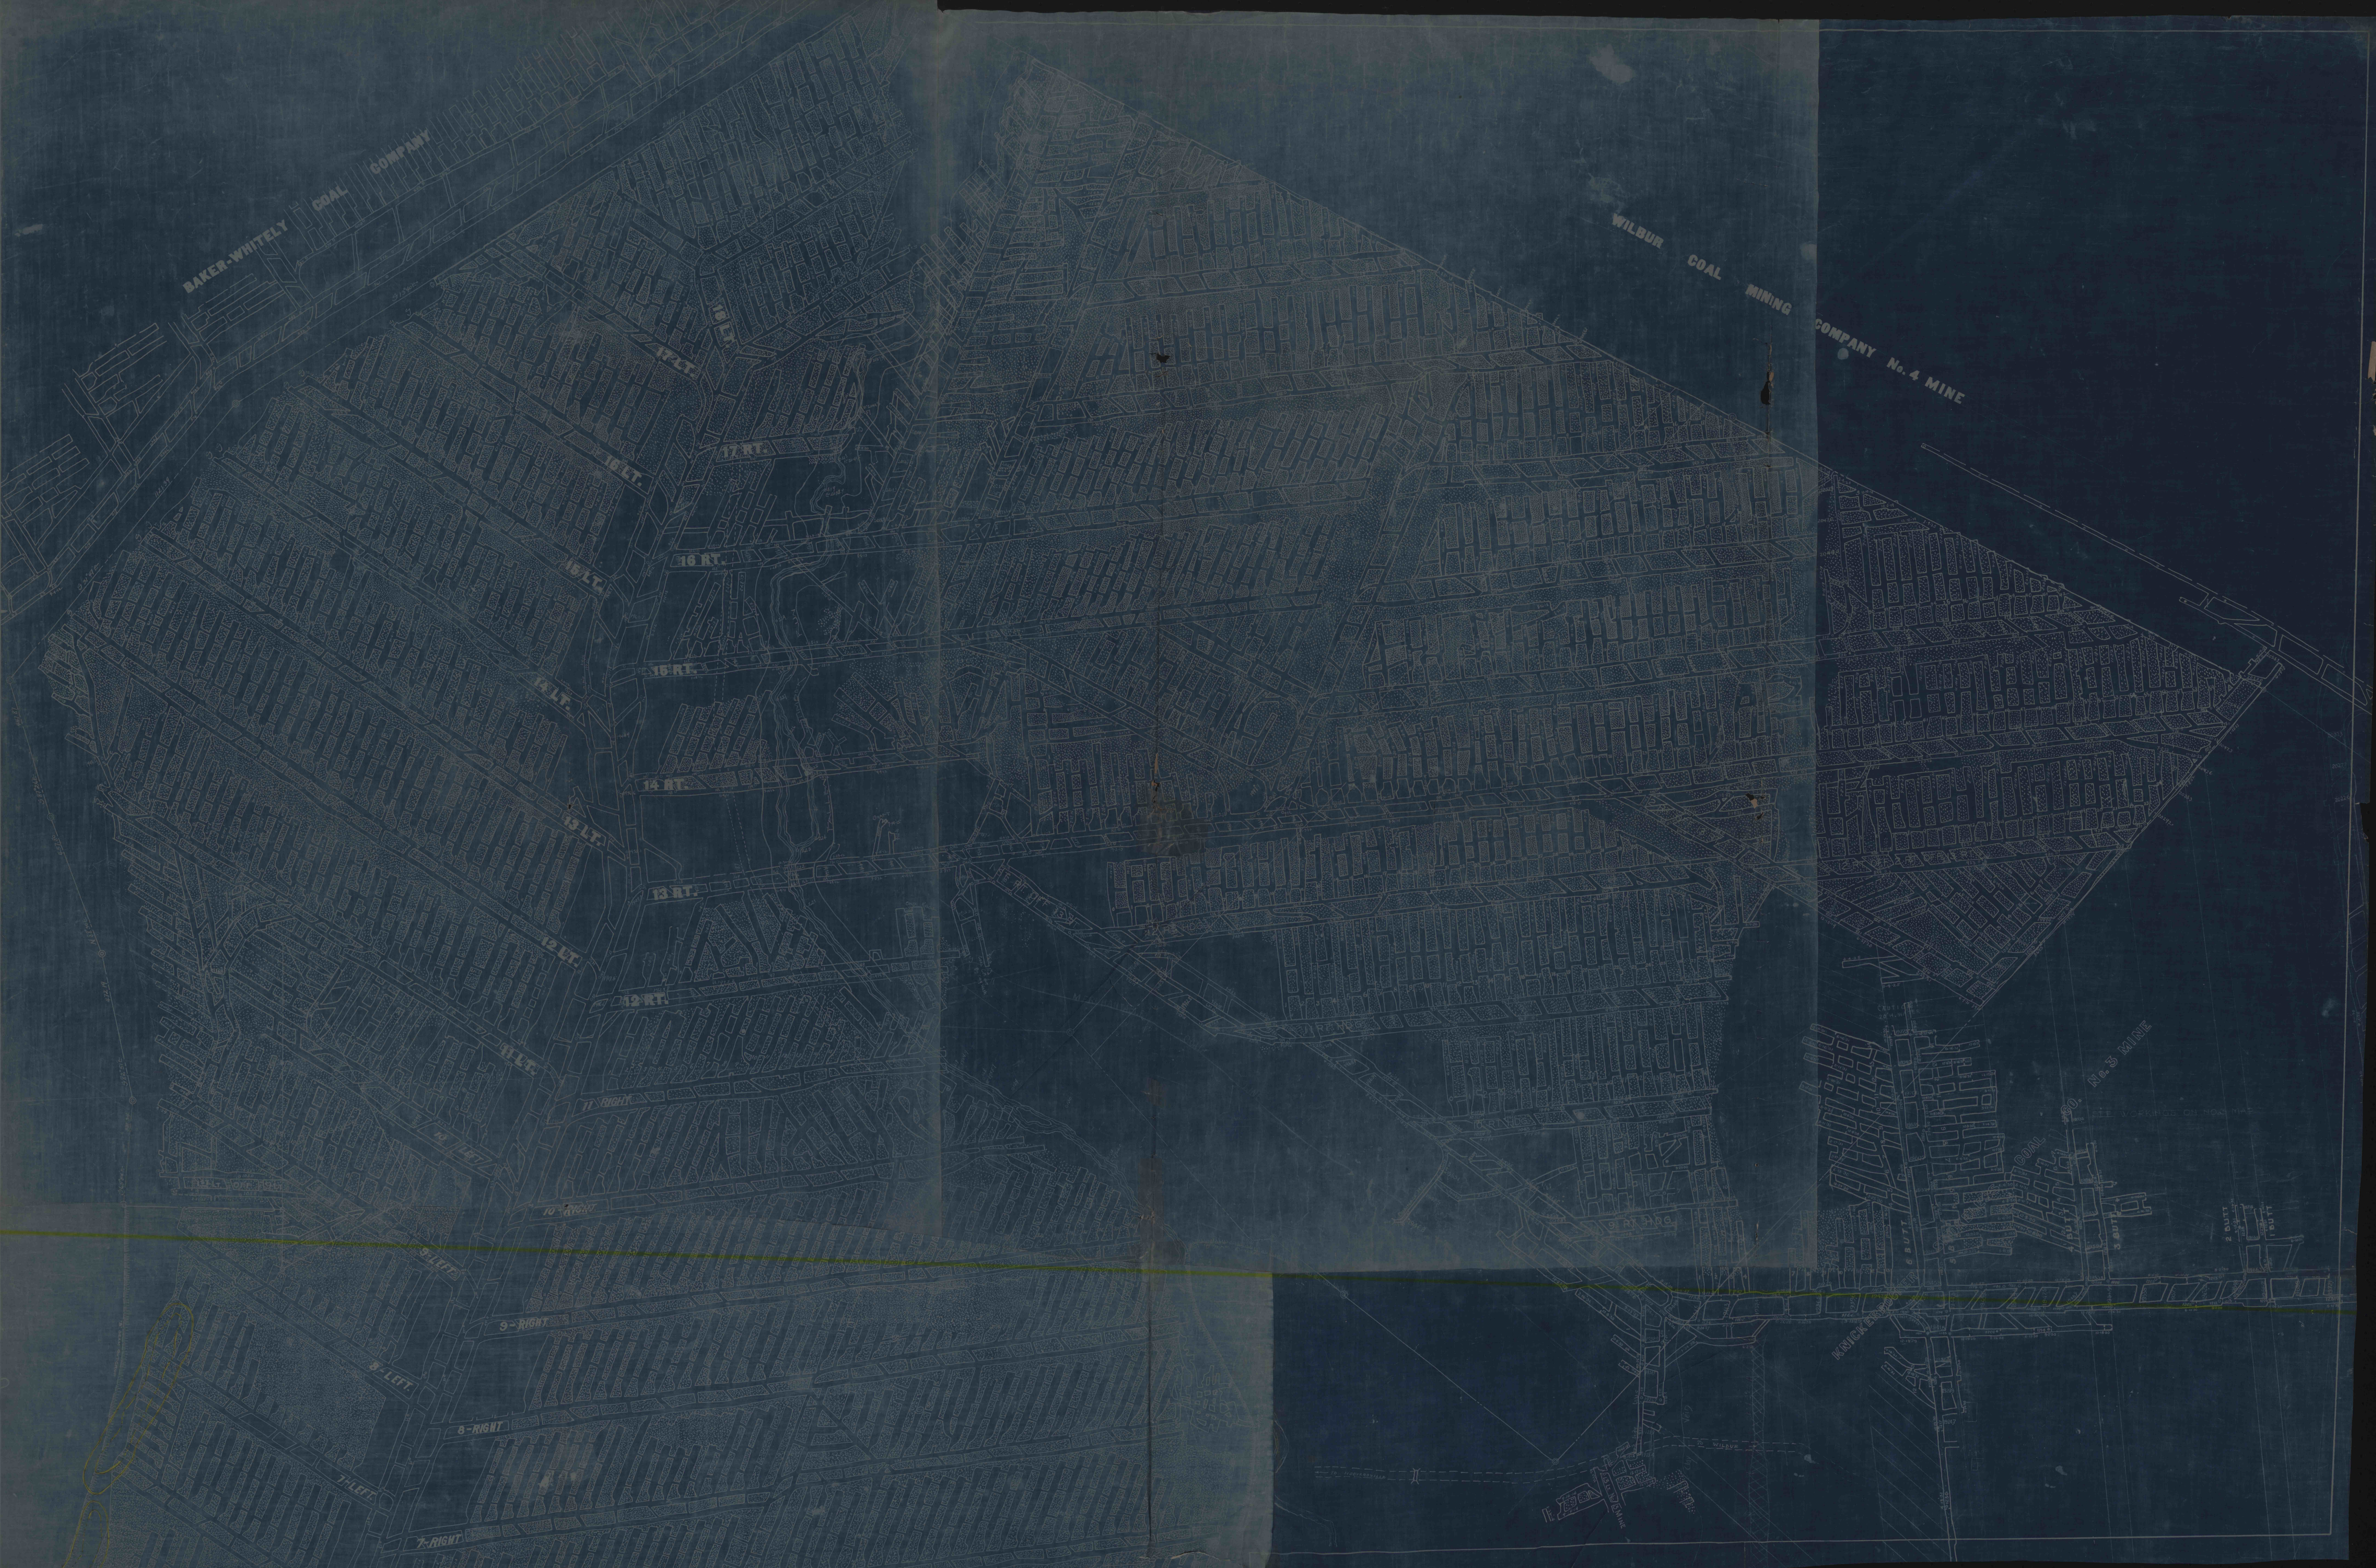

SOMERSET MINING COMPANY
MAP OF
KNICKERBOCKER No. 1
HOOVERVILLE PA. SCALE 1 IN = 100 FT.