IMAPS # 14865

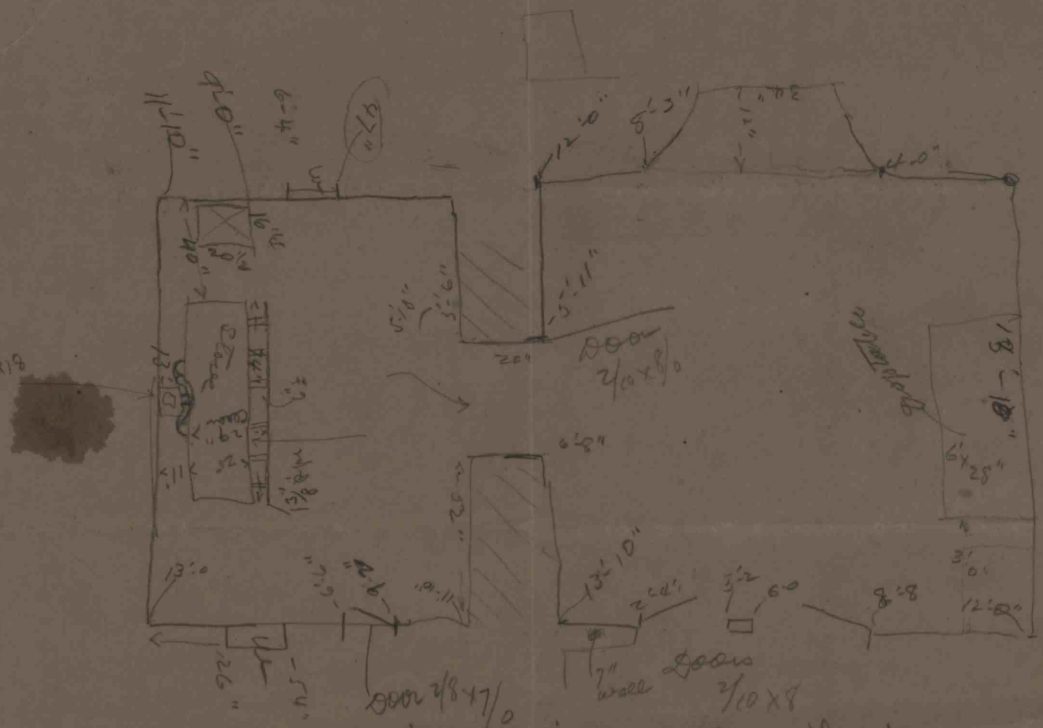
13x18
Door 2/10x8/0
Door 2/8x7/0
Doors 2/10x8
7" well
Addition to Shiloh Presbyterian Church
May 1977