


NEW SHAWMUT MINING CO ST. MARYS PA.
 STANDARD CLASS A MAGAZINE LOCATION,
 5000 LBS. CAPACITY,
 NO. 3 PROCTOR MINE,
 JAY TWP. ELK CO. CALEDONIA, PA.

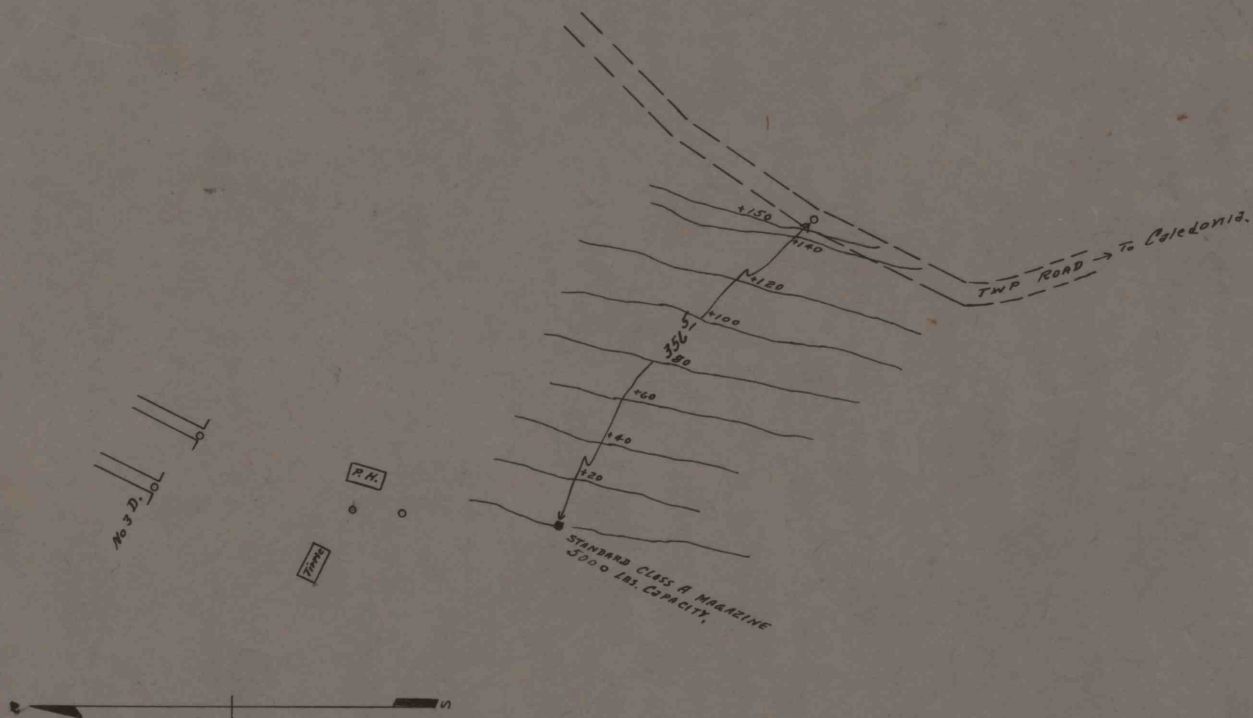

SCALE 1 INCH = 100 FT.
 P3-1

IMAPS # 14869