


— NEW SHAWUT MINING CO. —
 PROFILE OF NO. 2 PROCTOR.
 TRACK AND GROUND; - FEEDER ELEV.
 MAY-14-49

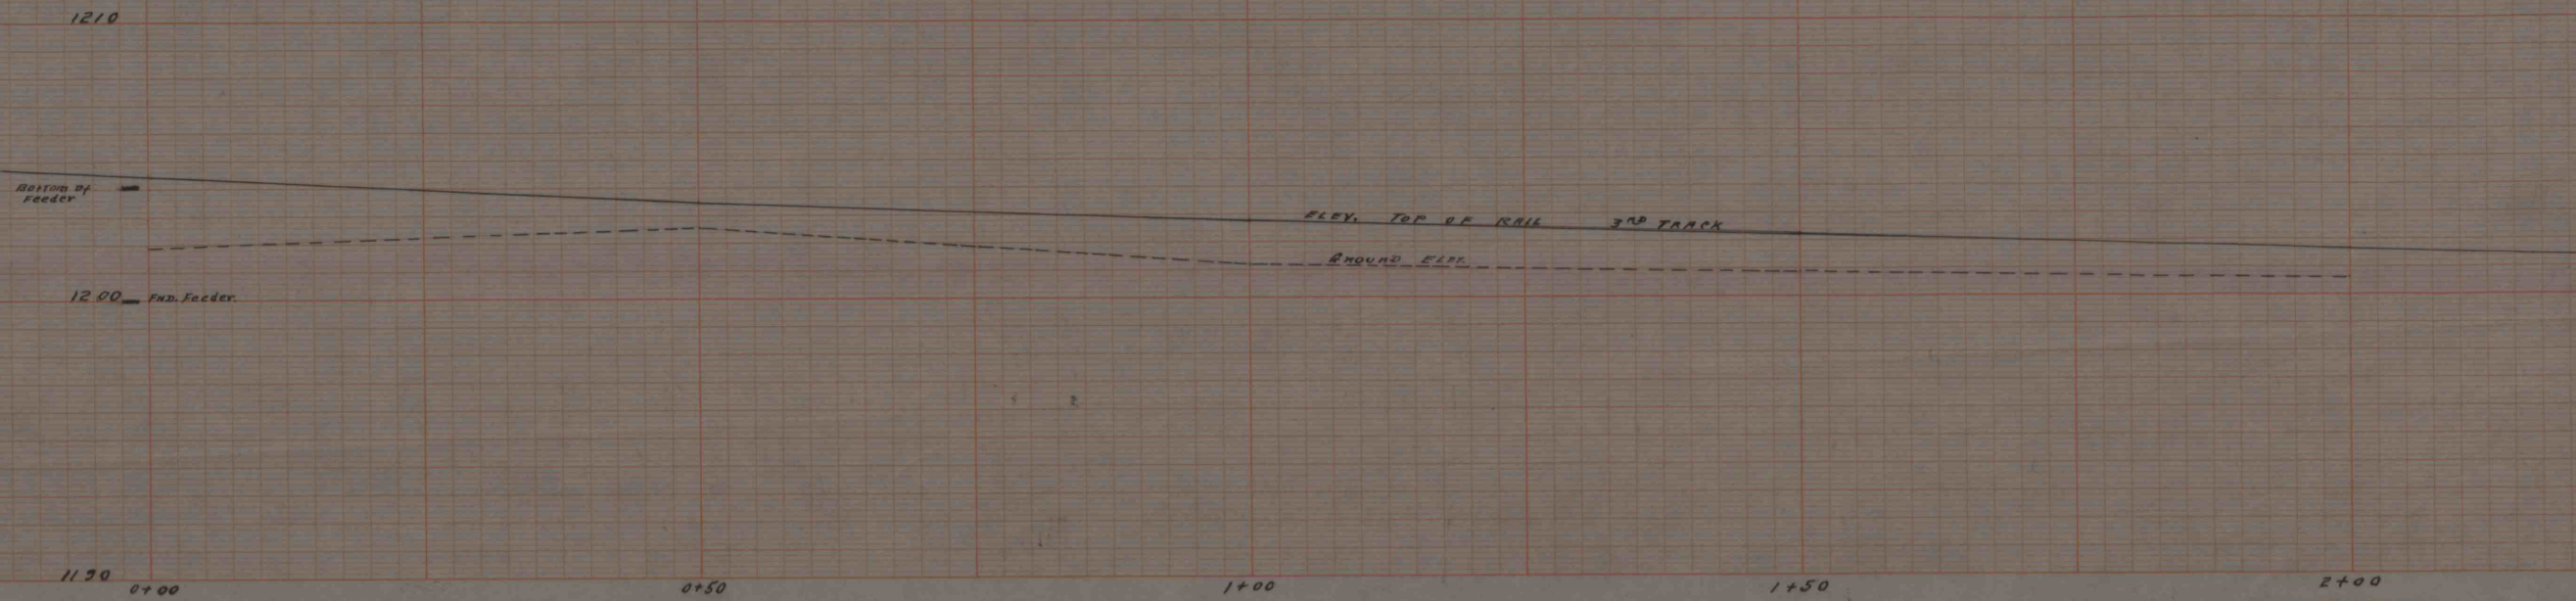

TRADE STANDARD MARK
 MADE IN U.S.A.
 PROFILE PLATE A 4 x 20
 100 & 200 SCALE
 KEUFFEL & ESSER CO.

KEUFFEL & ESSER CO.
 NEW YORK

TRADE STANDARD MARK
 MADE IN U.S.A.
 PROFILE PLATE A 4 x 20
 100 & 200 SCALE
 KEUFFEL & ESSER CO.

IMAS # 14879