


PROPOSED EXTENSION OF No 1 TIPPLE - TYLER MINES.

Number. 666
Date. 5-24-21
Scale. 1/8" = 1'
Drawn by. F.O.D.

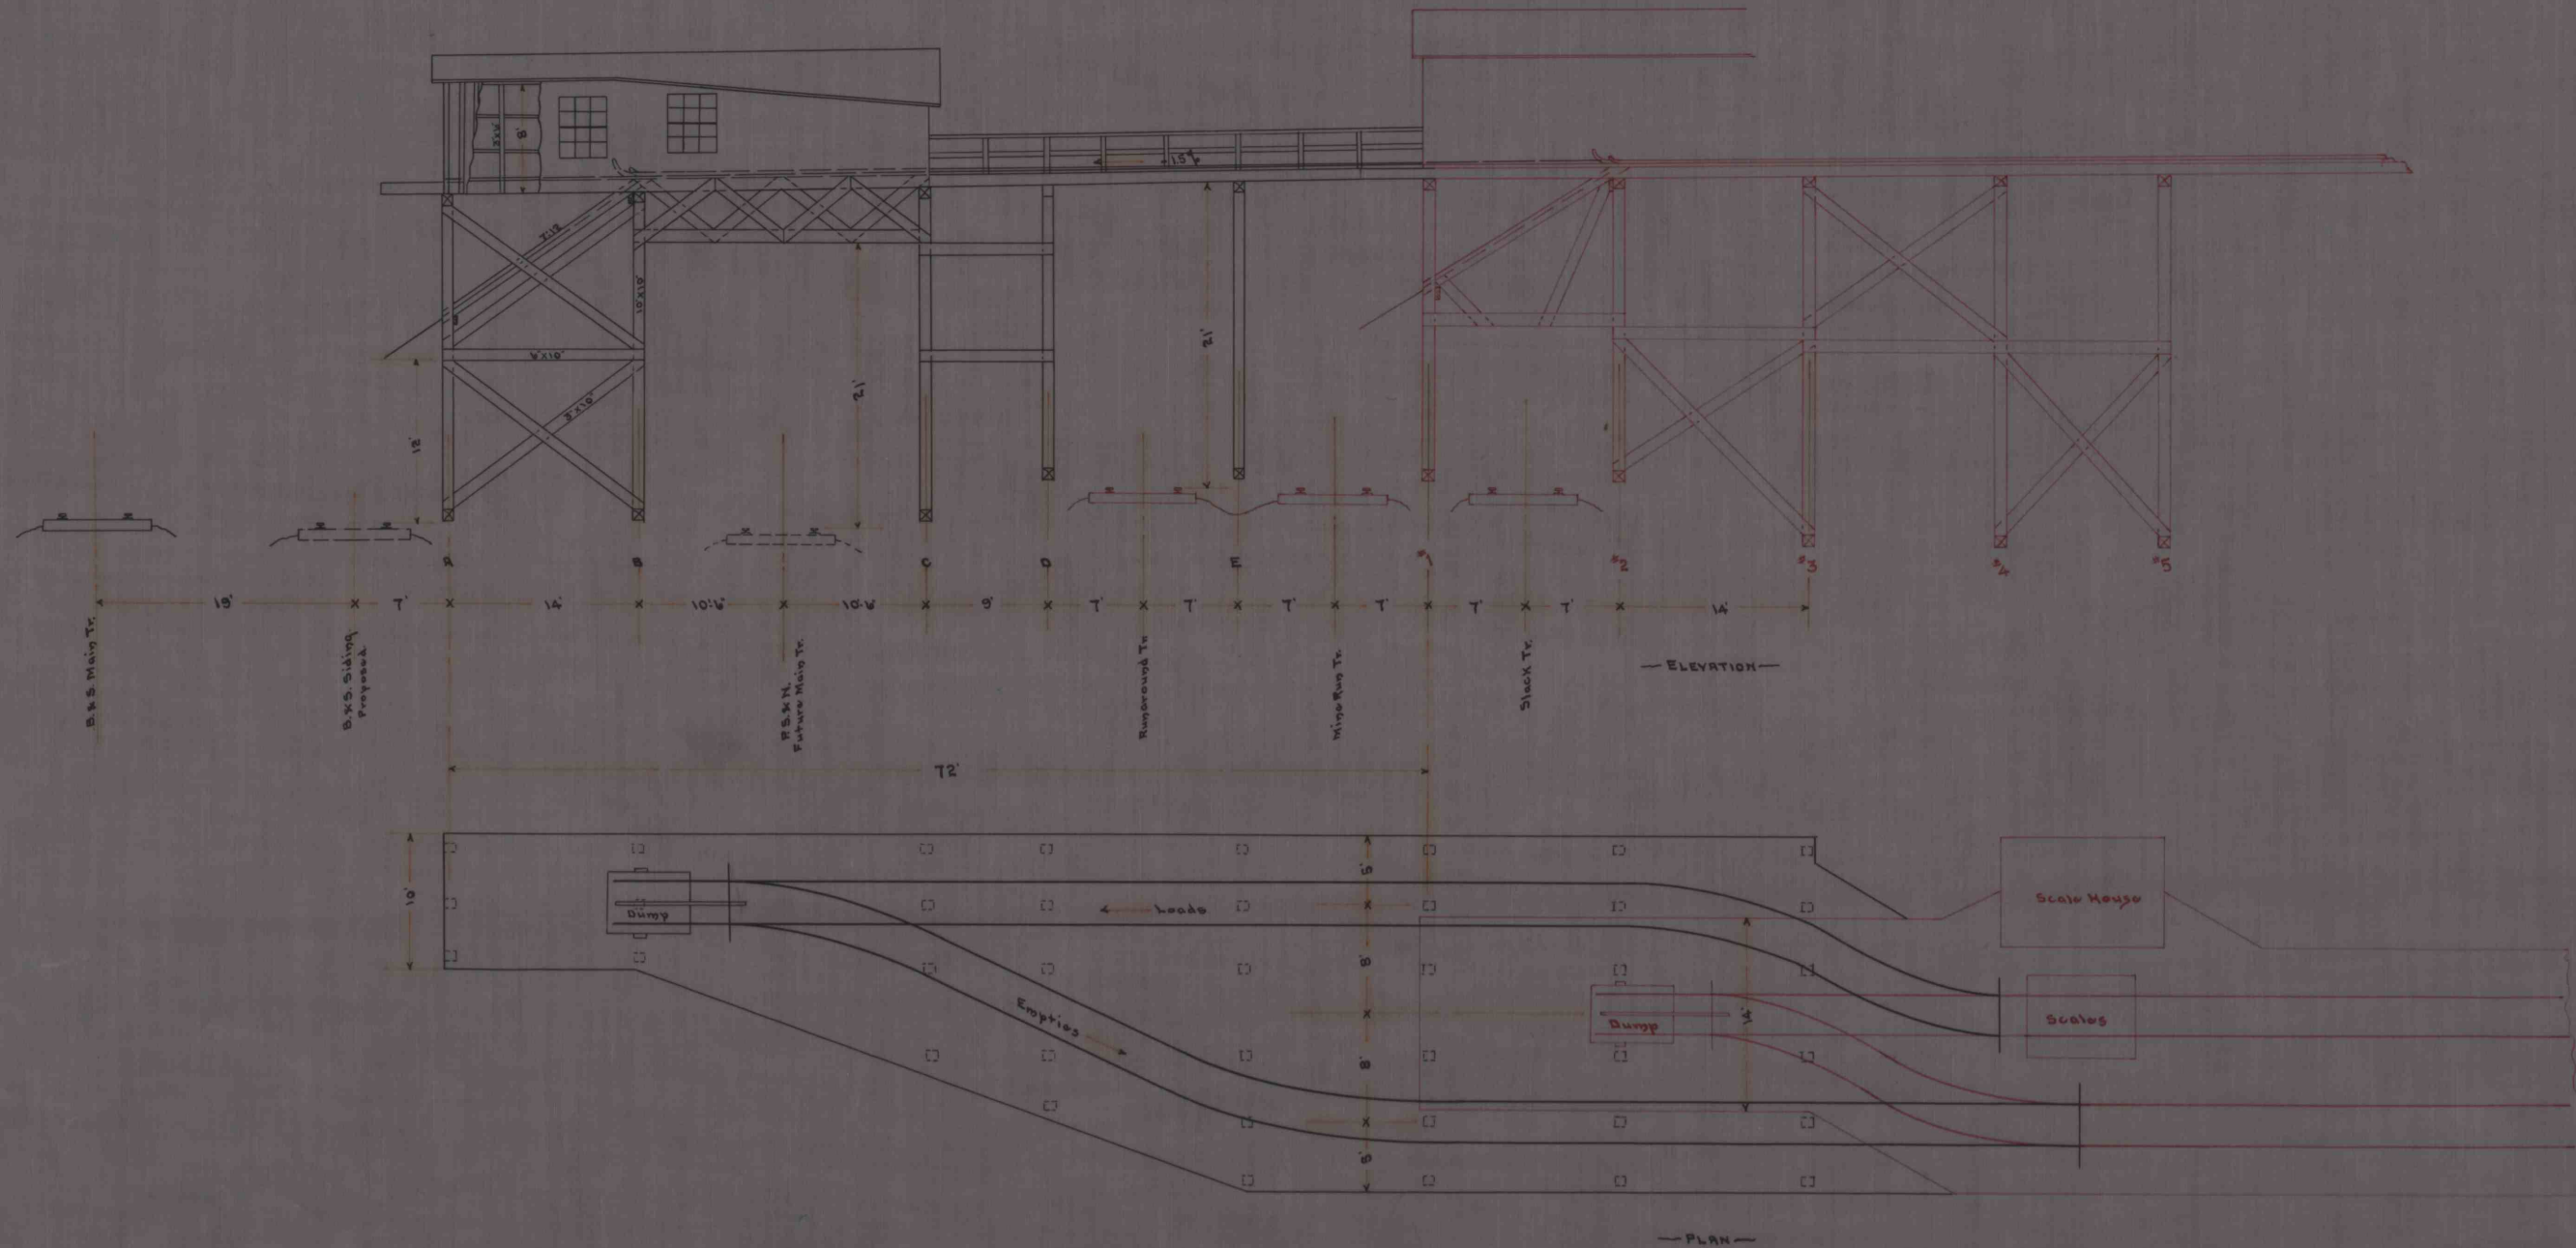

IMAPS # 14921