S. 1 8052-5

511

Foundation Plan
for
20"x22" Engine D.C. to 14-200-180 T.R. Dynamo
Ridgway Dynamo and Engine Co.
Ridgway, Pa. Dec. 21, 1906

Note: Bolt ends project 6" above bottom of casting.
Make proper allowance for grouting.
Leave space around bolts in pipes until engine is set, then grout with soft cement.

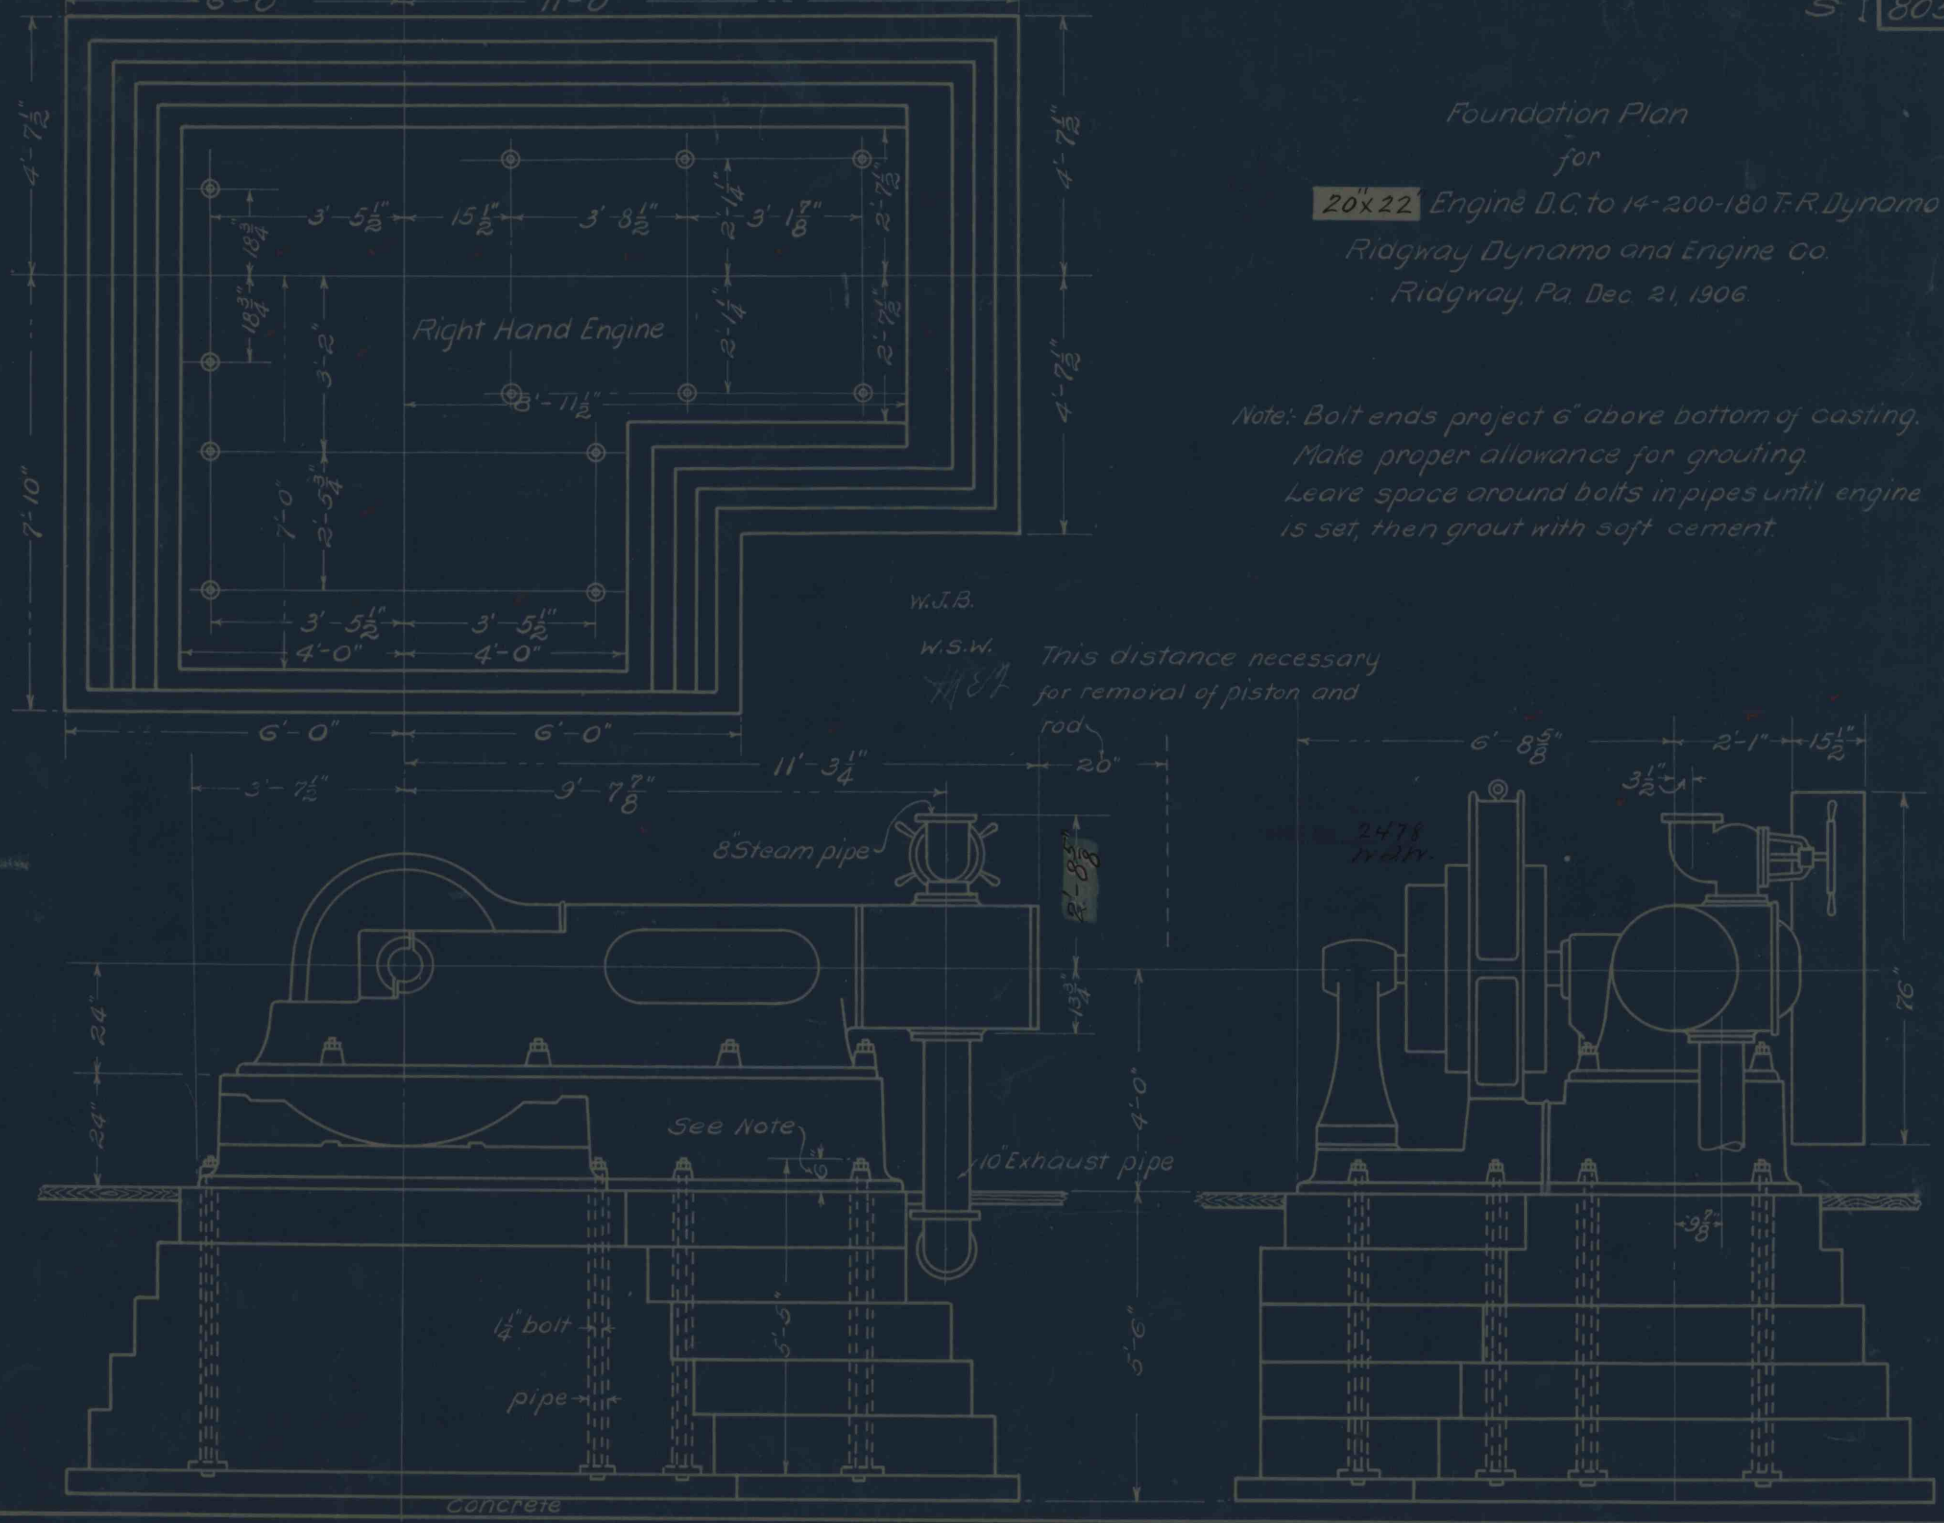

IMAPS# 14925