Reduce A only, Dec 19-13. Flange changed from 1 To 7/8
Tread From 2 1/2 To 3"
Inside Fref From 1 3/8 To 1 5/32"
Wheel Gauge Changed From 35 3/4" To 35 5/8"

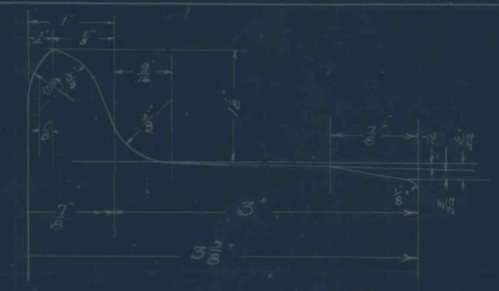

Date		S.O.	Ord. No.	Req. No.	Name
June	28-13	28031			Shawmut Mining Co.
Dec	3-13	29842	576		" " "
Feb.	2-13	30624		597	" " "

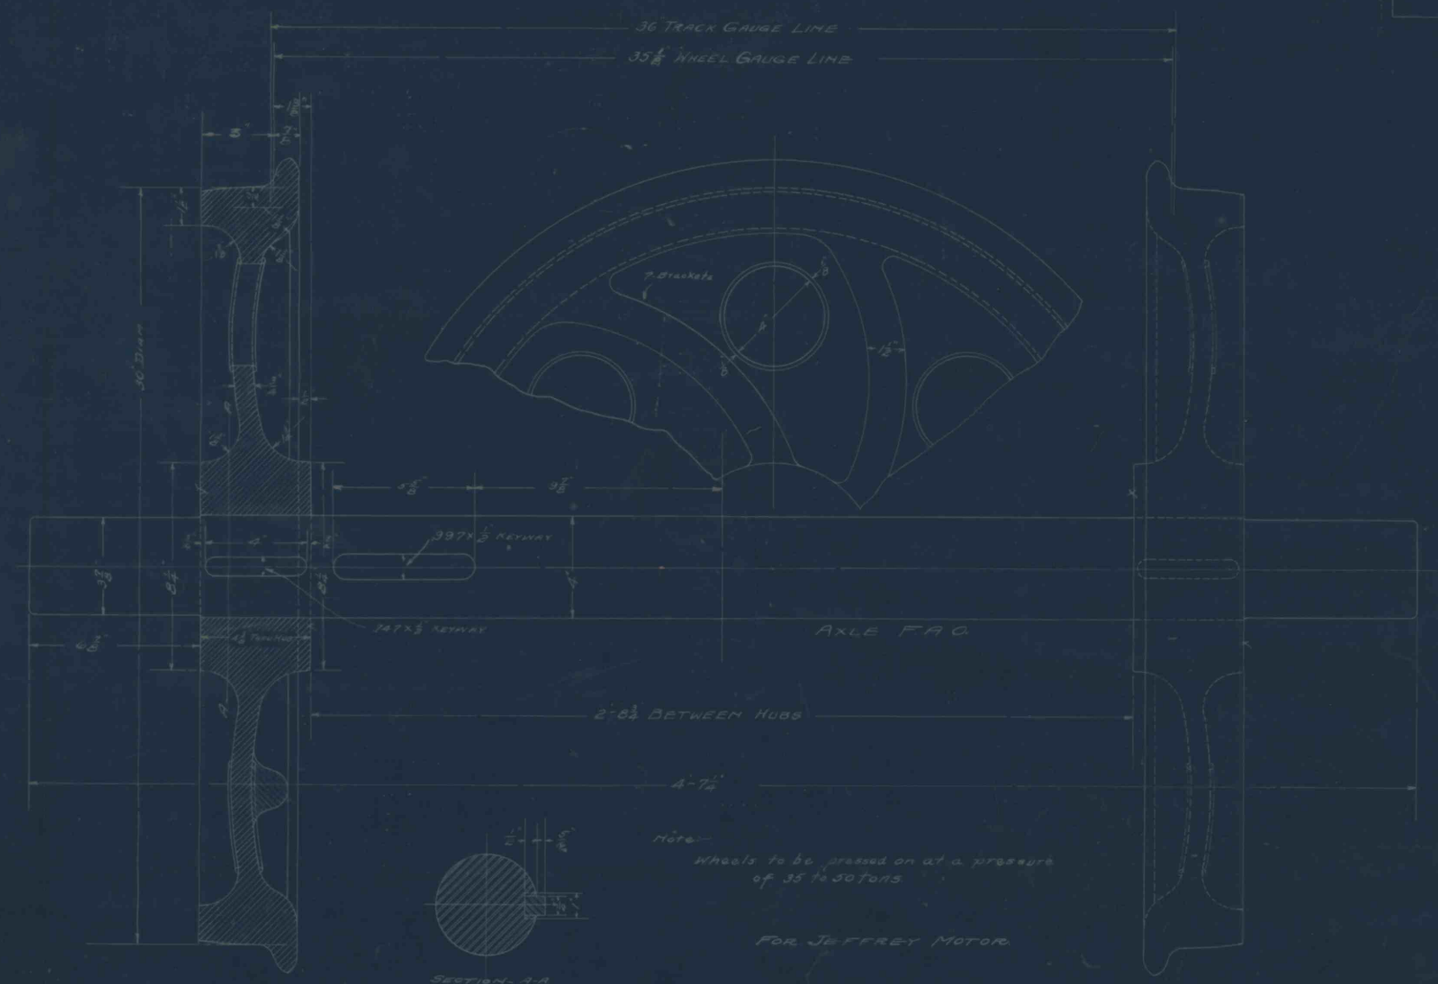

Note:-
Wheels to be pressed on at a pressure of 35 to 50 tons.

For Jeffrey Motor.

Remarks 14944

Redrawn from Old Wheels & Axle
C.L. F.R.C.

American Car & Foundry Co.,
Engineering Dept.
Berwick Pa.
30" Motor Wheels & Axle
For
Shawmut Mining Co.

Correct:-
Mgr.

Approved:-
Supt.

Folio	X.Y.
No	864

7-15-13