


Number 704
 Date 11.5.24.
 Scale 1/4" = 1'
 Drawn by P.O.


— S.M.C. —
FAN-MOTOR HOUSES

Note—
 Some dimension figures are changed
 hereon Nov. 6th.
 See that necessary height is used to
 clear switchboards.

— FOR NO 31 MINE —

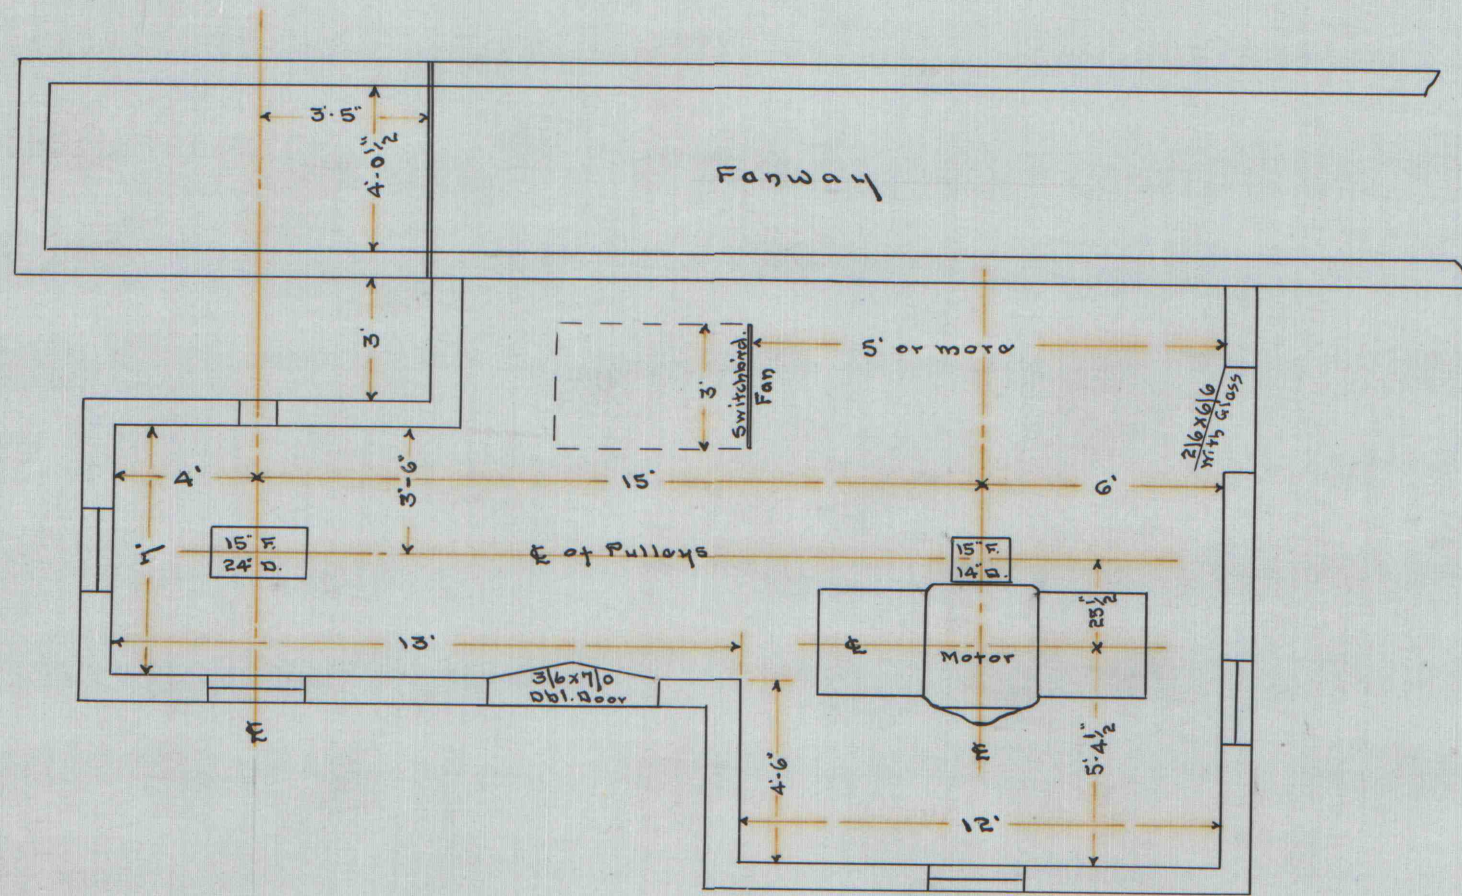


— PLAN —

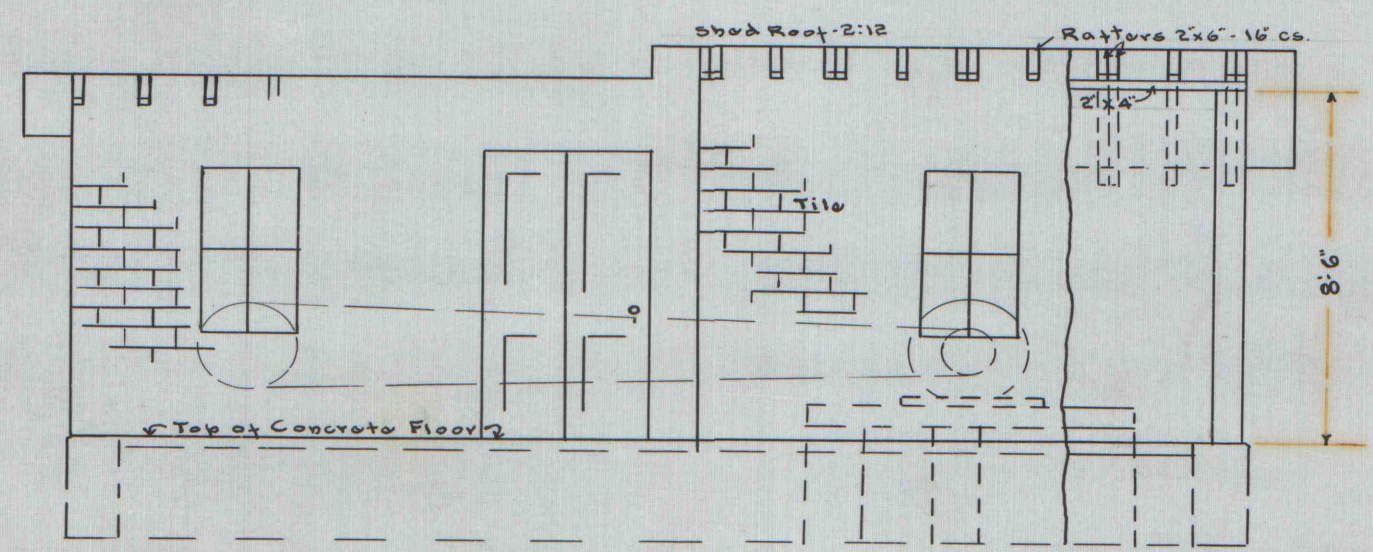


— ELEV. —

— FOR NO 42 MINE —

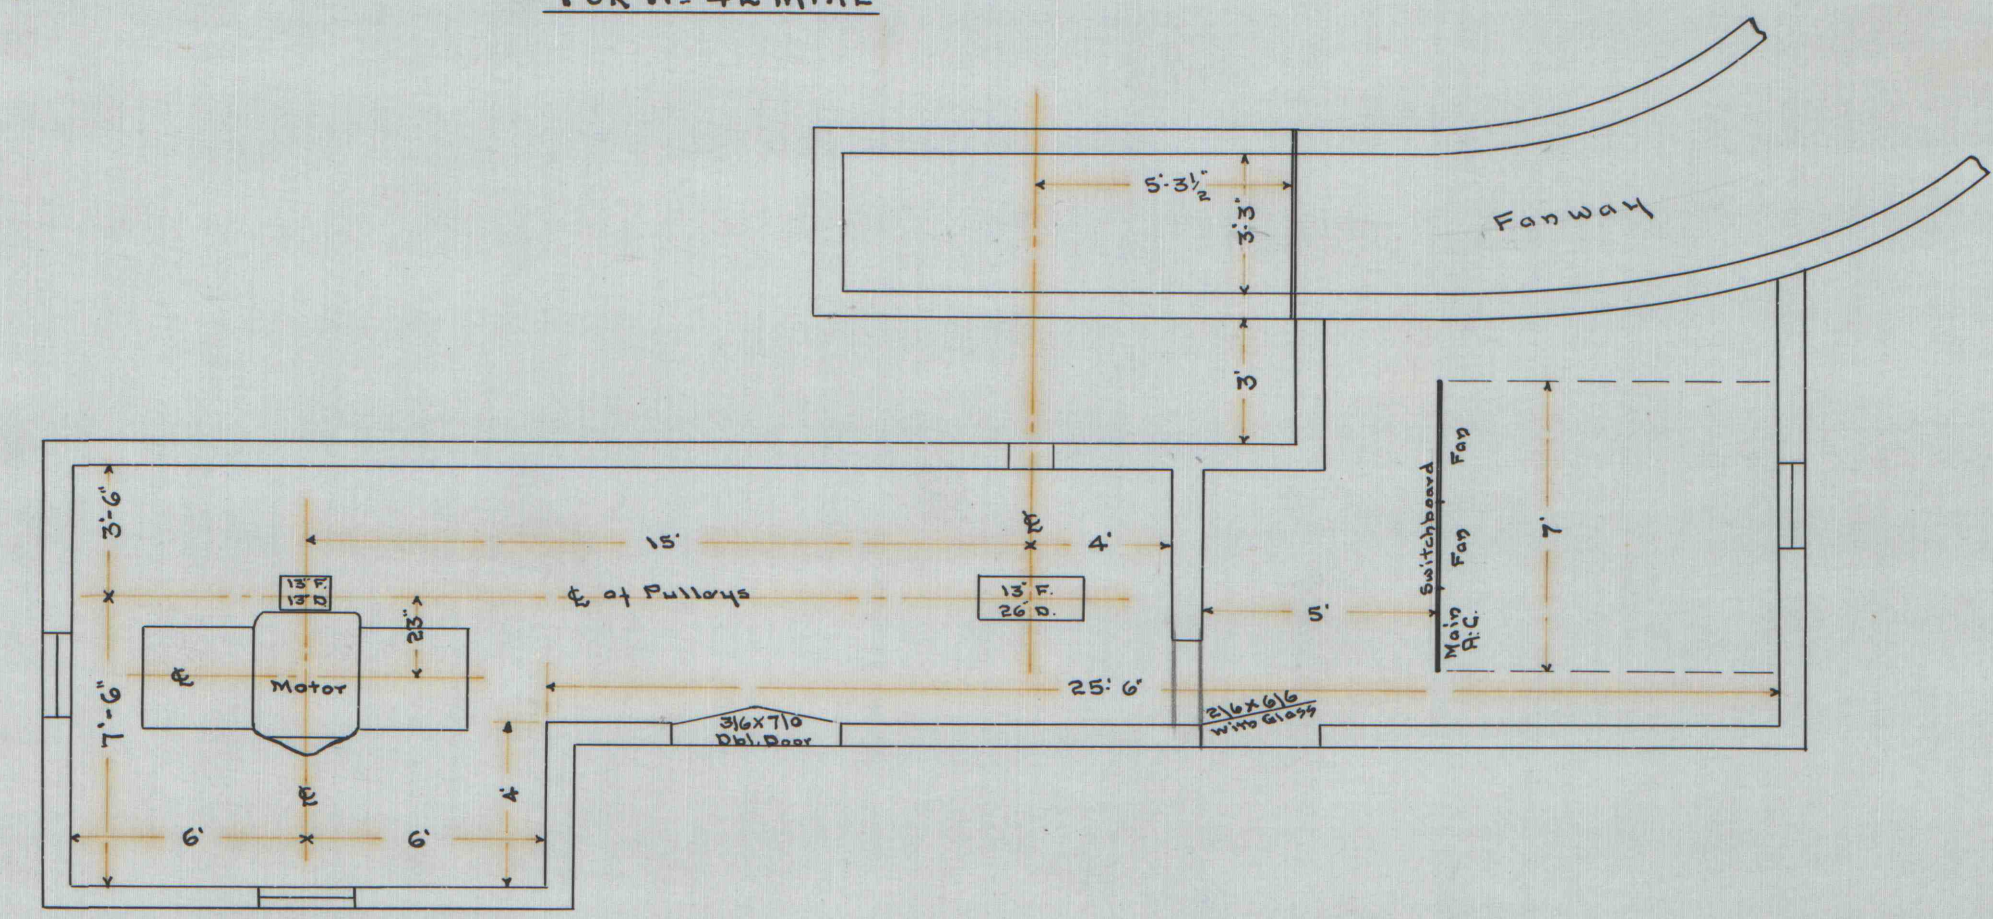

— PLAN —

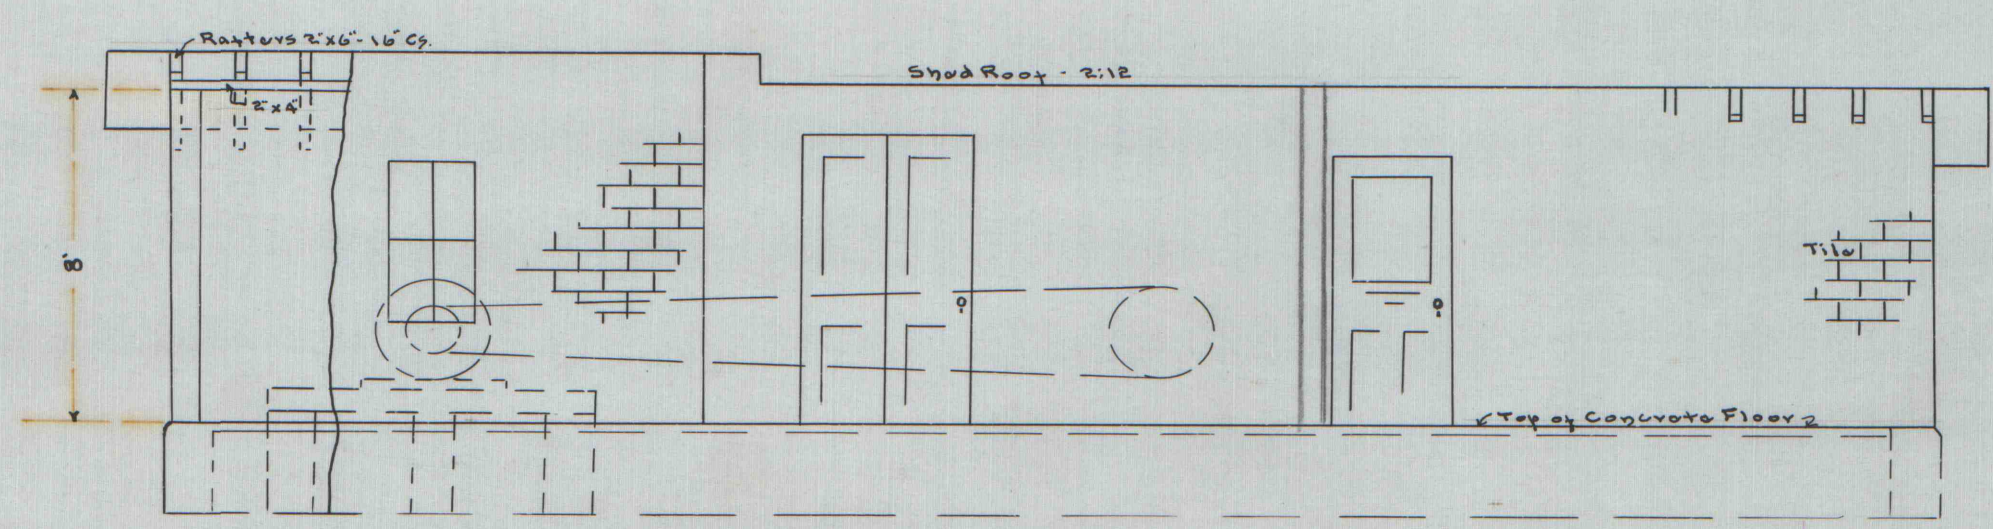

— ELEV. —