


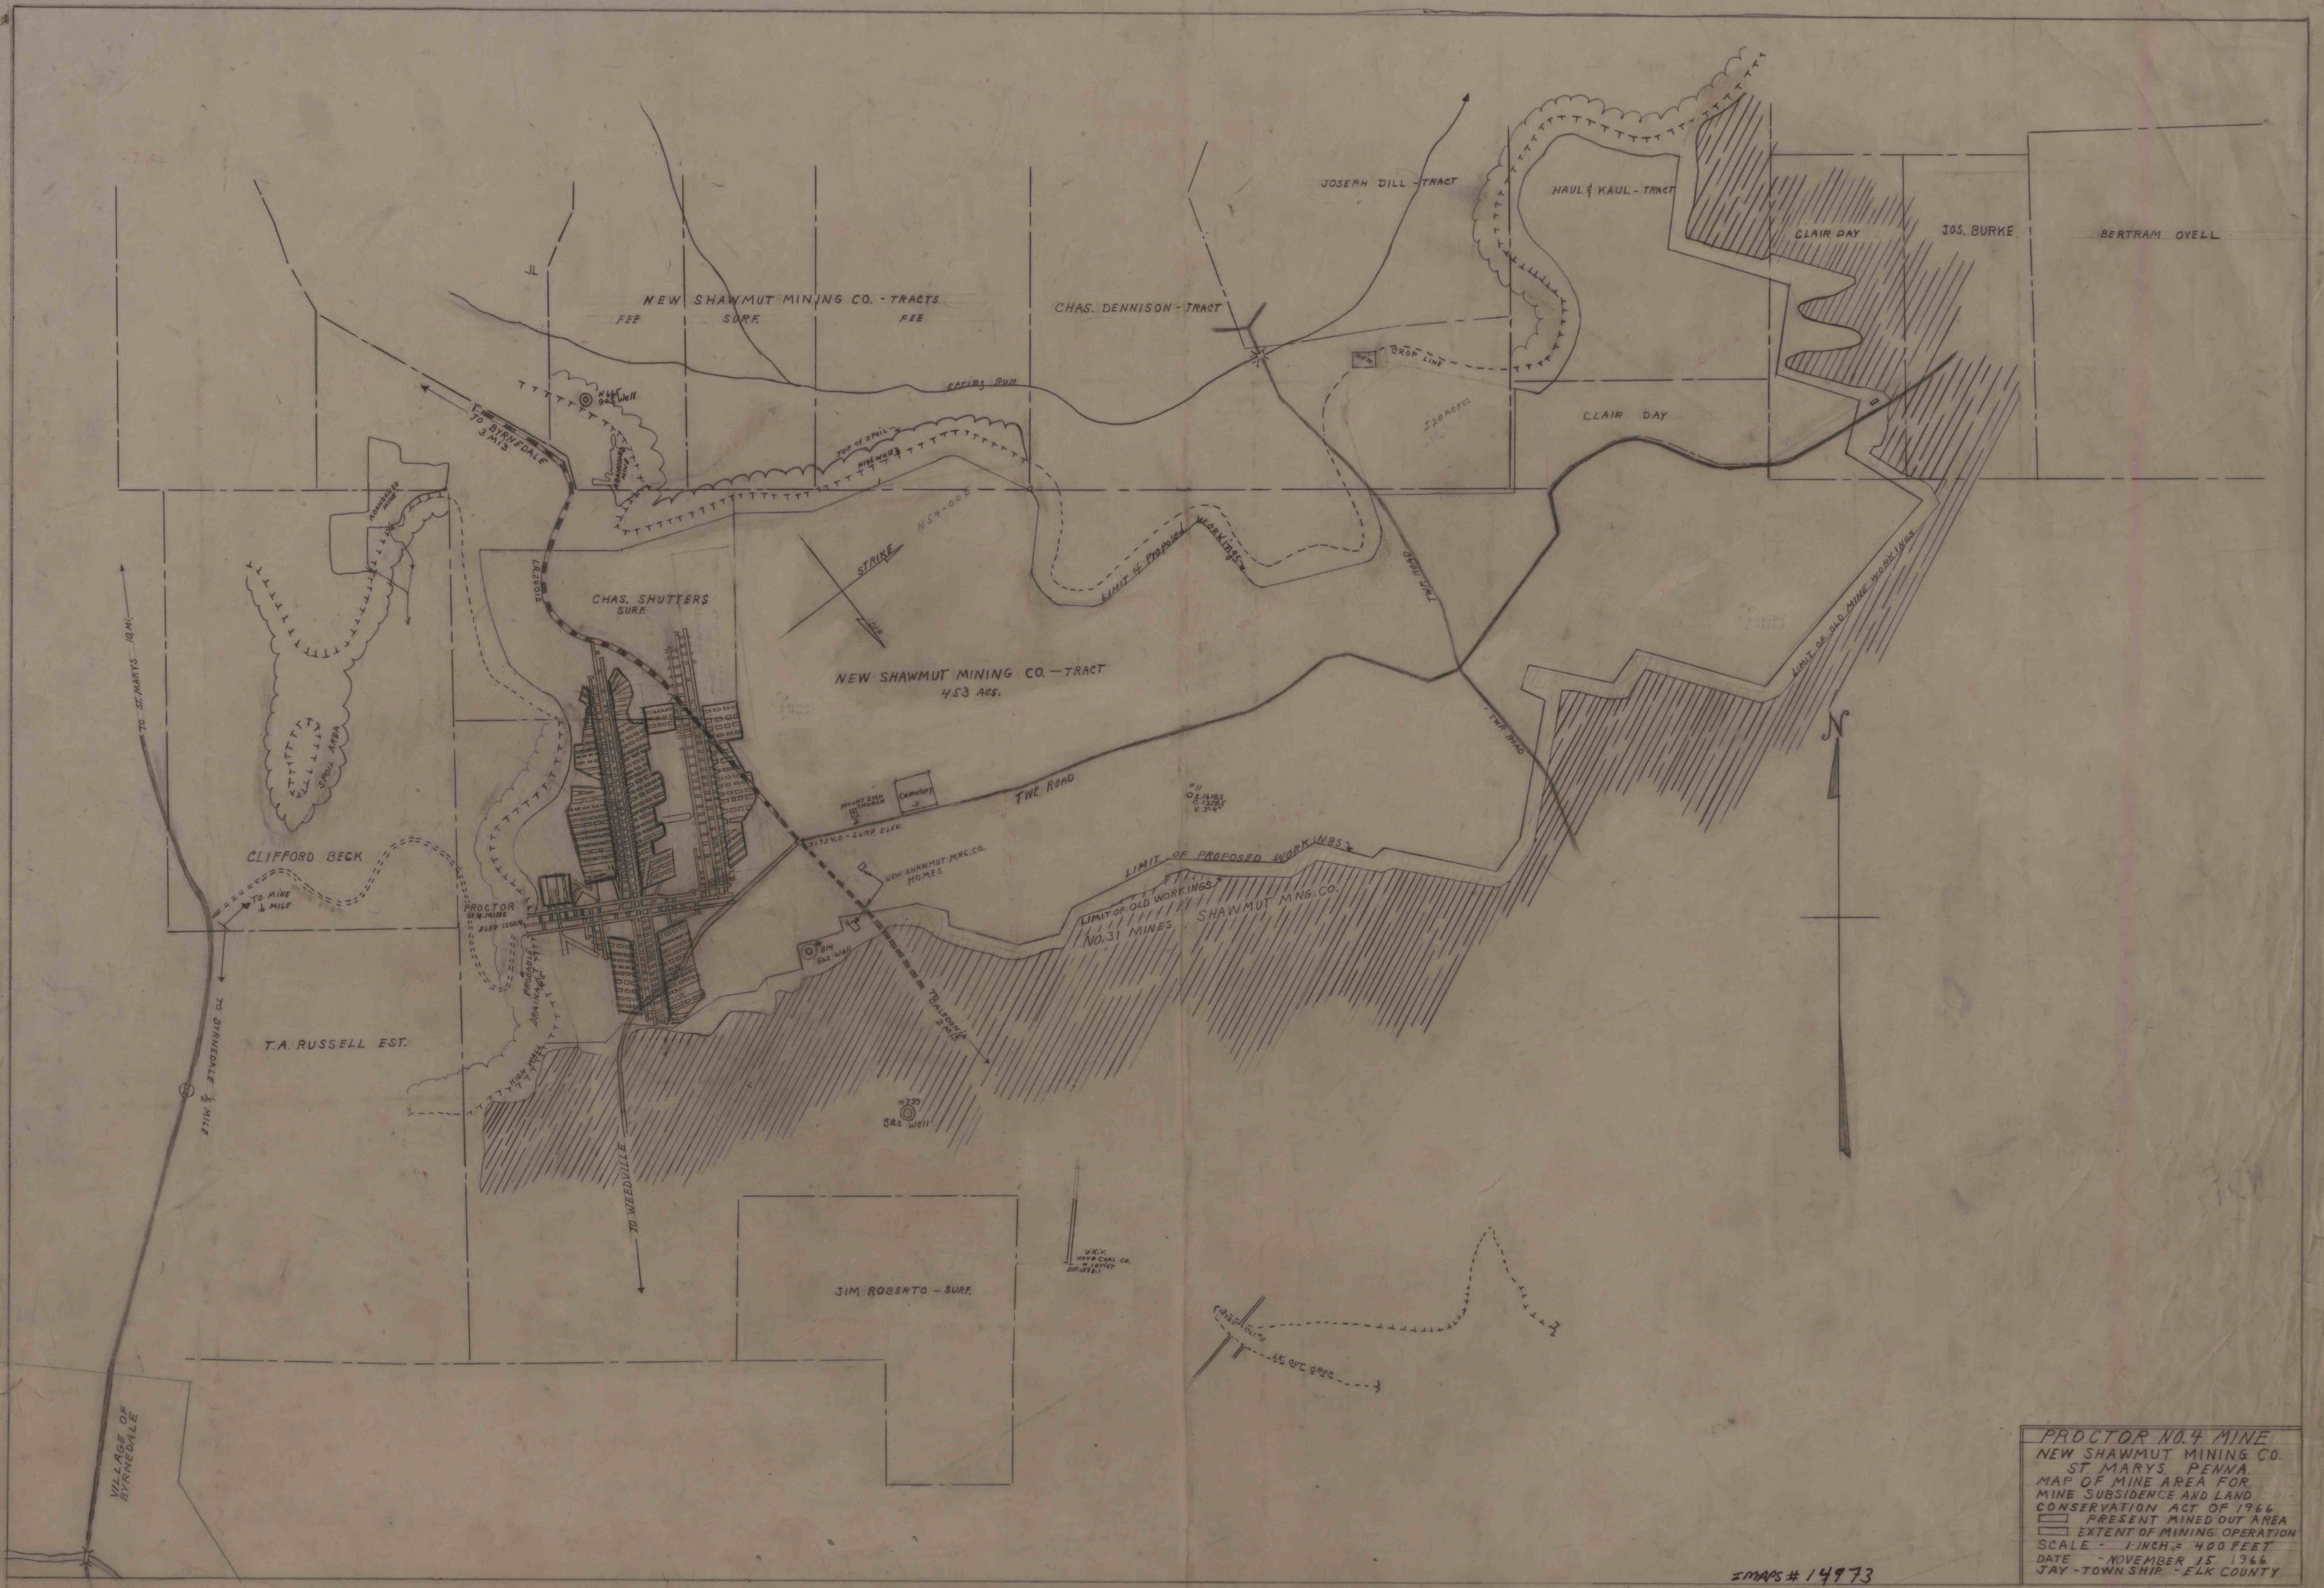

PROCTOR NO. 4 MINE
NEW SHAWMUT MINING CO.
ST. MARYS, PENNA.
MAP OF MINE AREA FOR
MINE SUBSIDENCE AND LAND
CONSERVATION ACT OF 1966
PRESENT MINED OUT AREA
EXTENT OF MINING OPERATION
SCALE - 1 INCH = 400 FEET
DATE - NOVEMBER 15, 1966
JAY TOWNSHIP - ELK COUNTY

EMAPS # 14973

MAP USED FOR SUBSIDENCE & WATER PERMIT.
A spring added

DATE Changed from Aug. 15, 1966
TO NOV. 22, 1966