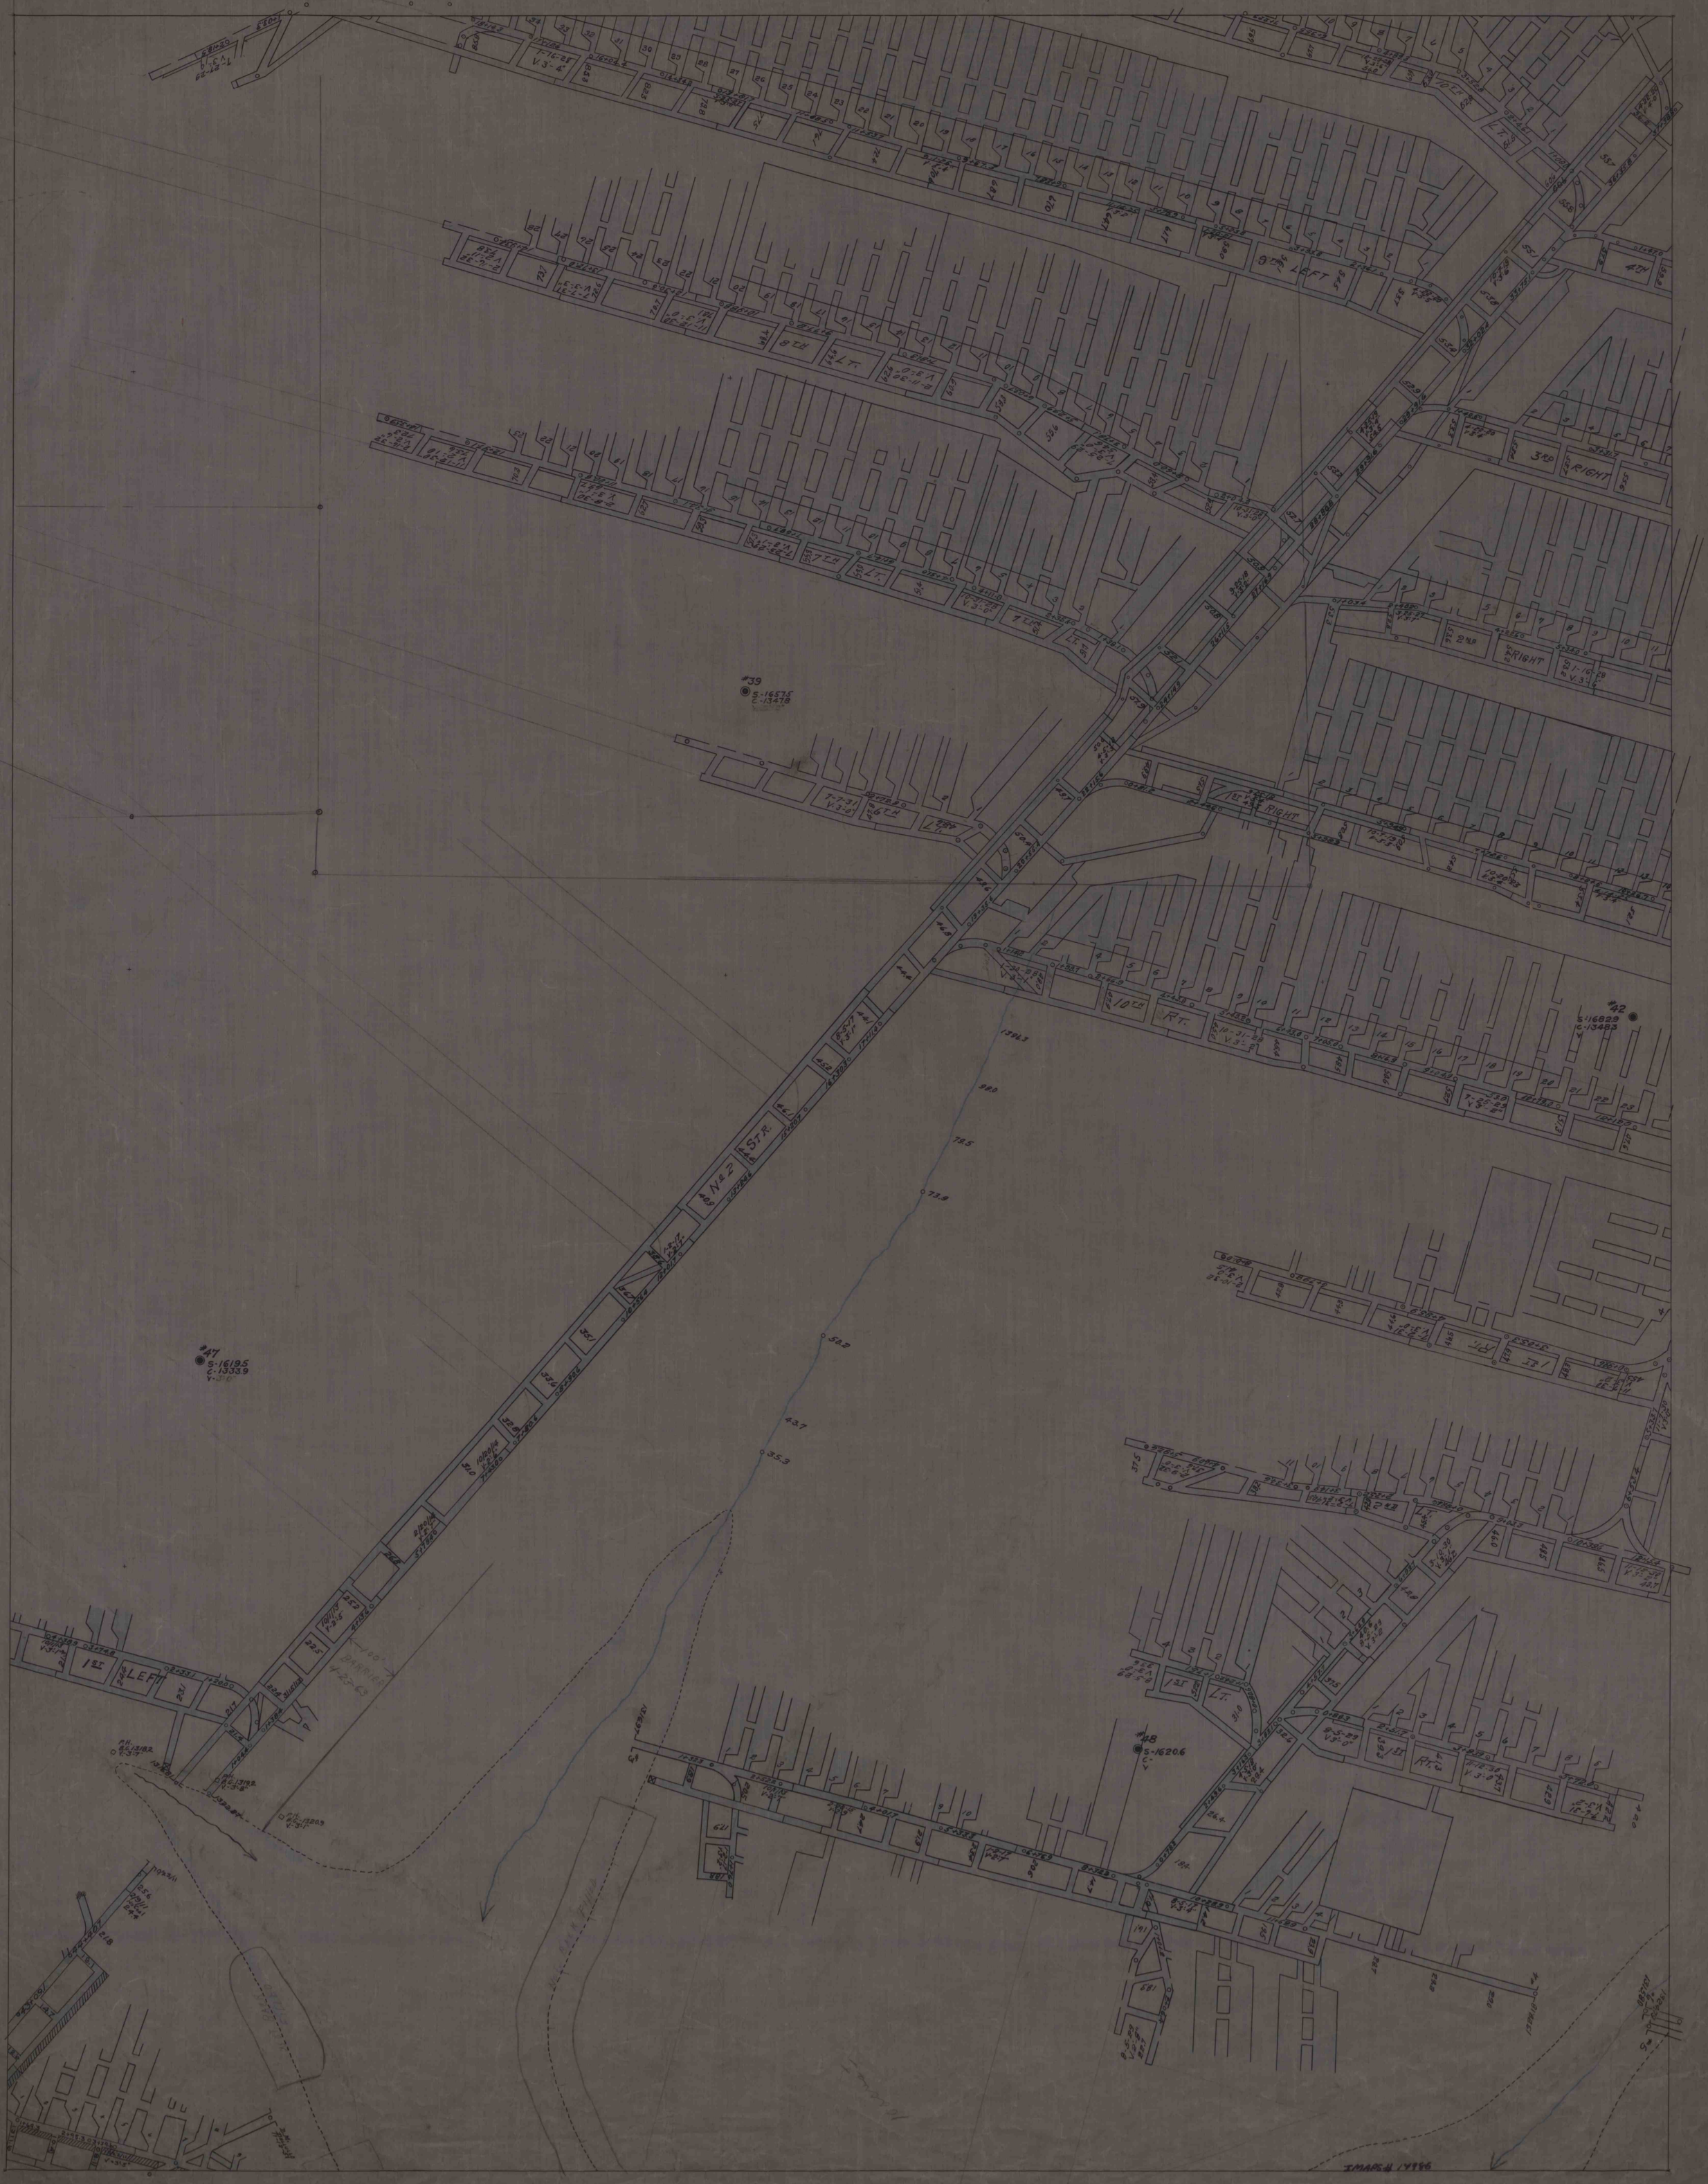
#39
S-16575
C-13478
#42
S-16829
C-13483
#47
S-16195
C-13339
#48
S-16206
1ST RIGHT
2ND RIGHT
3RD RIGHT
4TH
5TH
6TH
7TH
8TH
9TH
10TH
1ST LEFT
2ND LEFT
3RD LEFT
4TH LEFT
5TH LEFT
6TH LEFT
7TH LEFT
8TH LEFT
9TH LEFT
10TH LEFT
1ST RT.
2ND RT.
3RD RT.
4TH RT.
5TH RT.
6TH RT.
7TH RT.
8TH RT.
9TH RT.
10TH RT.
1ST L.T.
2ND L.T.
3RD L.T.
4TH L.T.
5TH L.T.
6TH L.T.
7TH L.T.
8TH L.T.
9TH L.T.
10TH L.T.
457 ST.
BARRIER
IMAGE # 19986