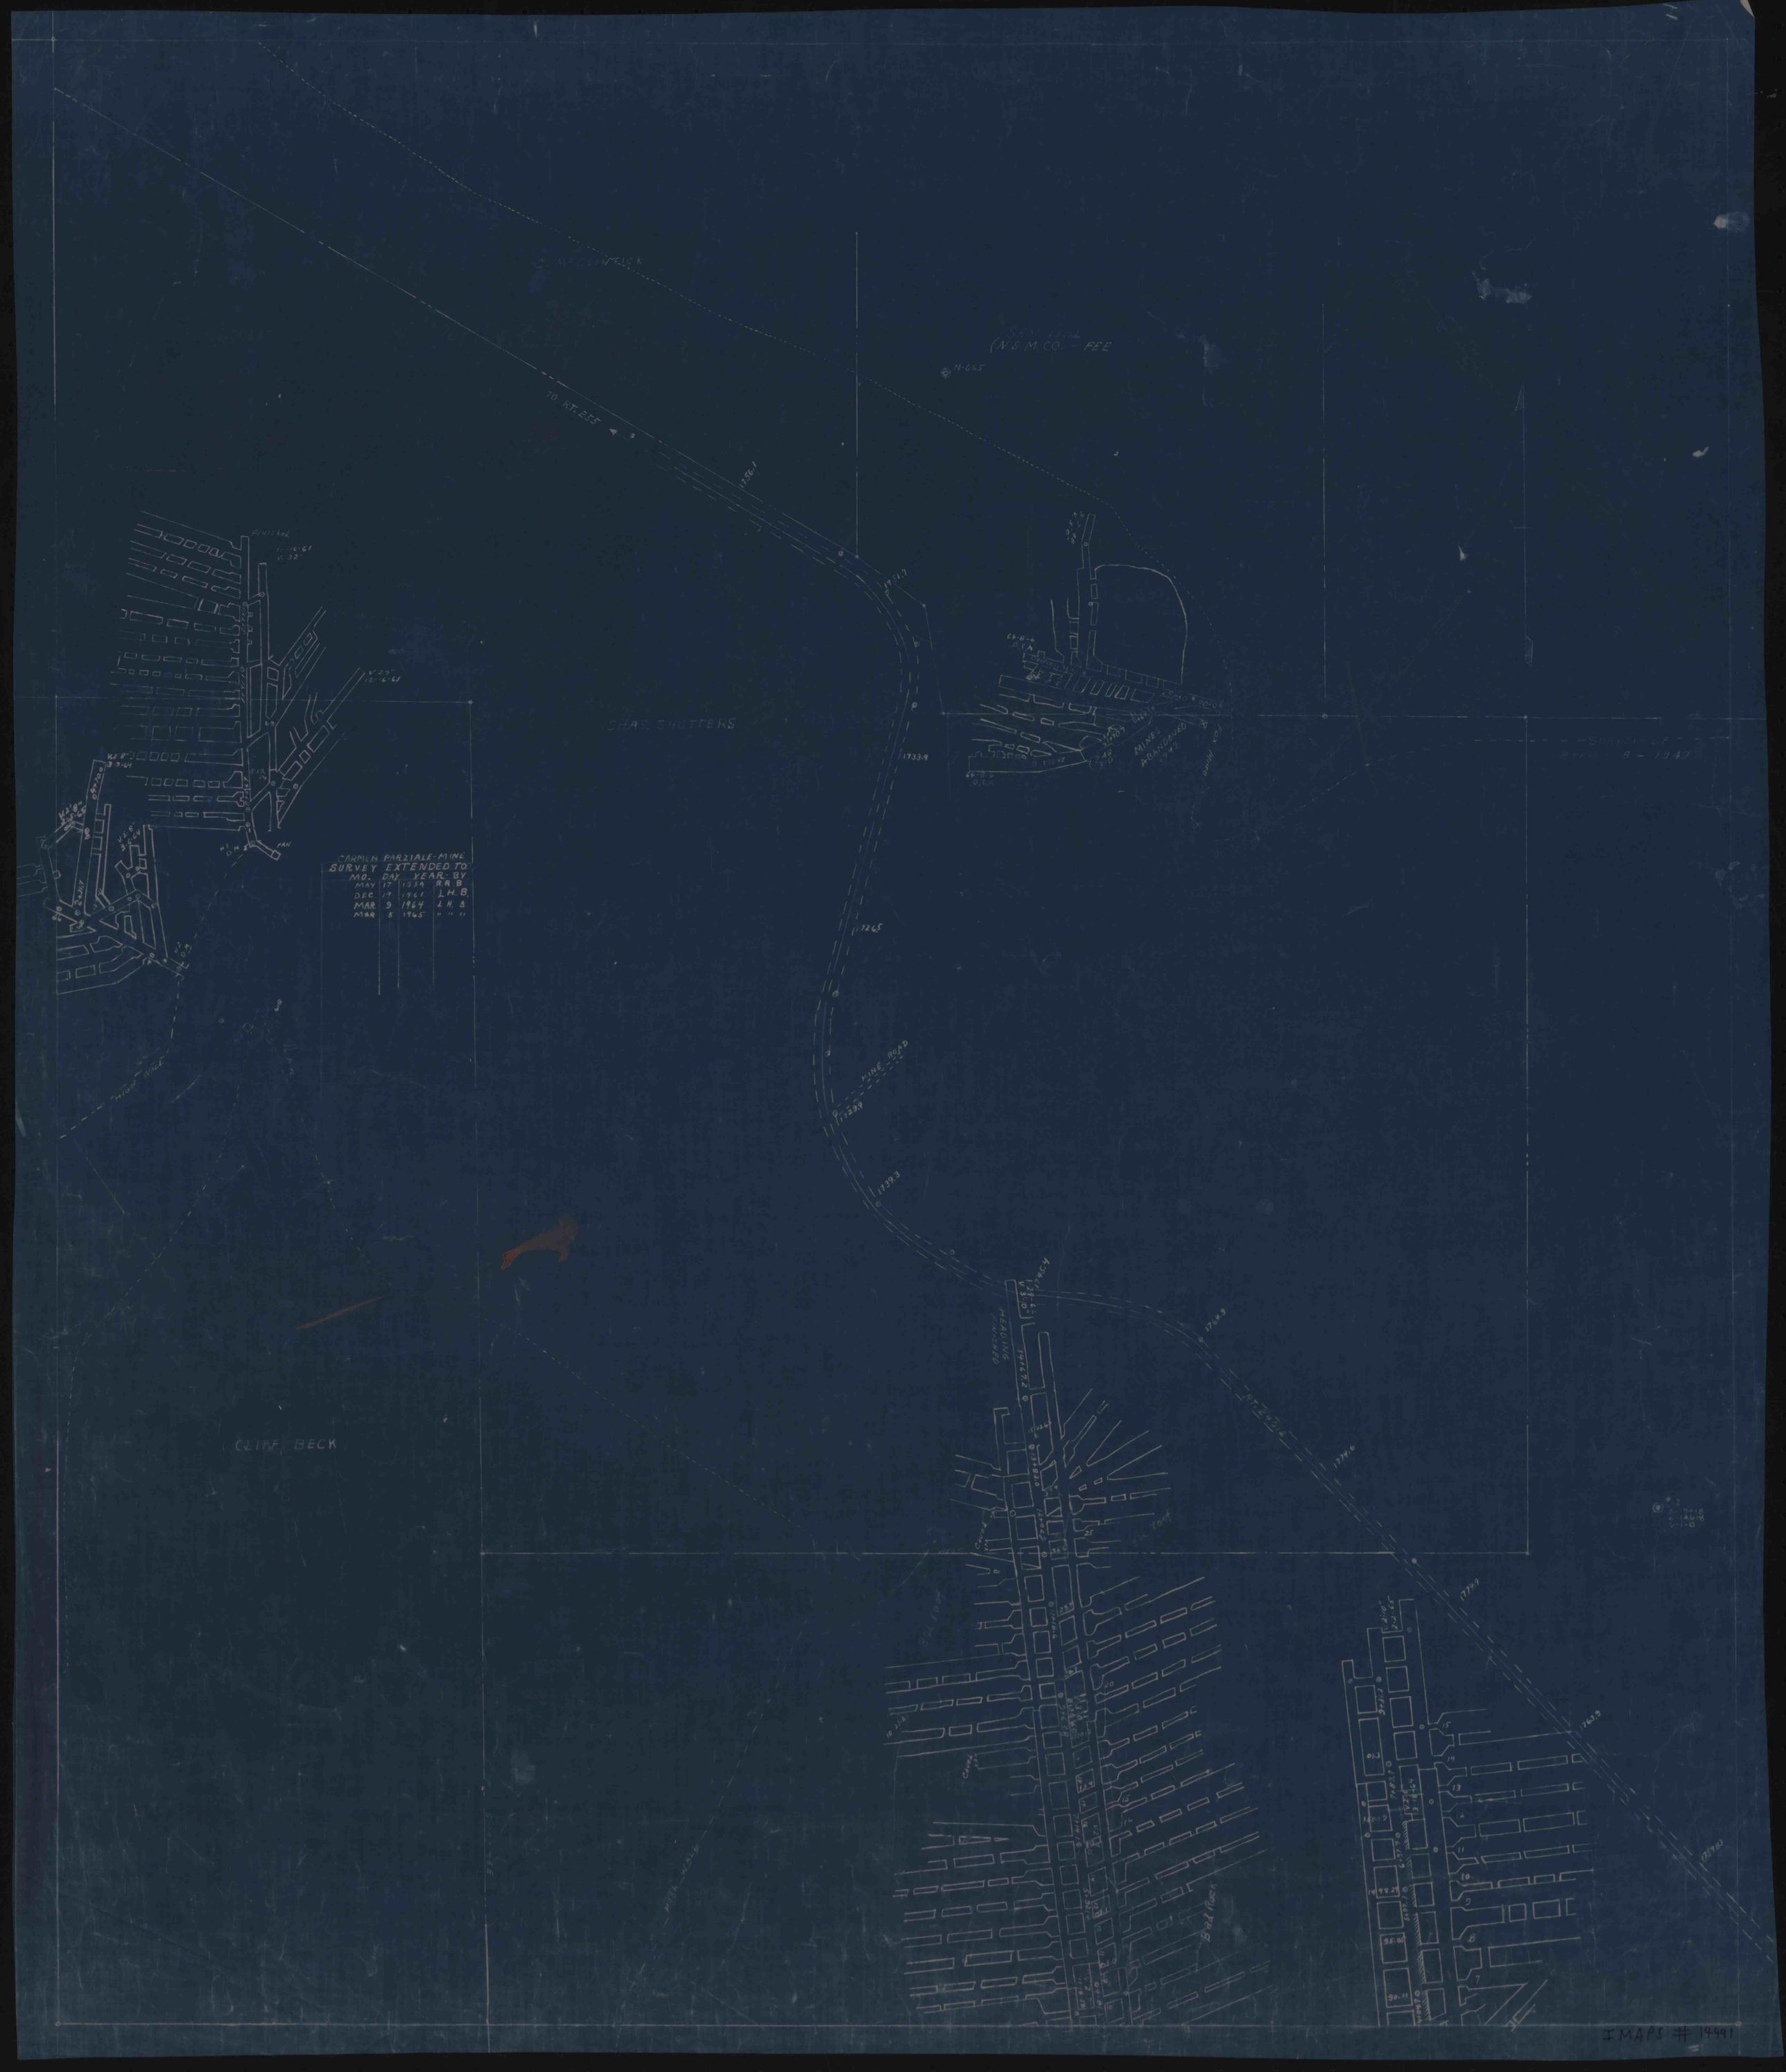
C. McCLINTOCK
(N.S.M.CO. - FEE
N-665
70 RT. 255
CHAS. SHUTTERS
MINE ABANDONED
MINE ROAD
HIGH WALL
CLIFF BECK
Bird Rock
CARMEN PARZIALE-MINE
SURVEY EXTENDED TO
MO. DAY YEAR BY
MAY 17 1959 R.R.B.
DEC. 19 1964 L.H.B.
MAR. 9 1964 L.H.B.
MAR 3 1965 " " "
I MAPS # 14991