
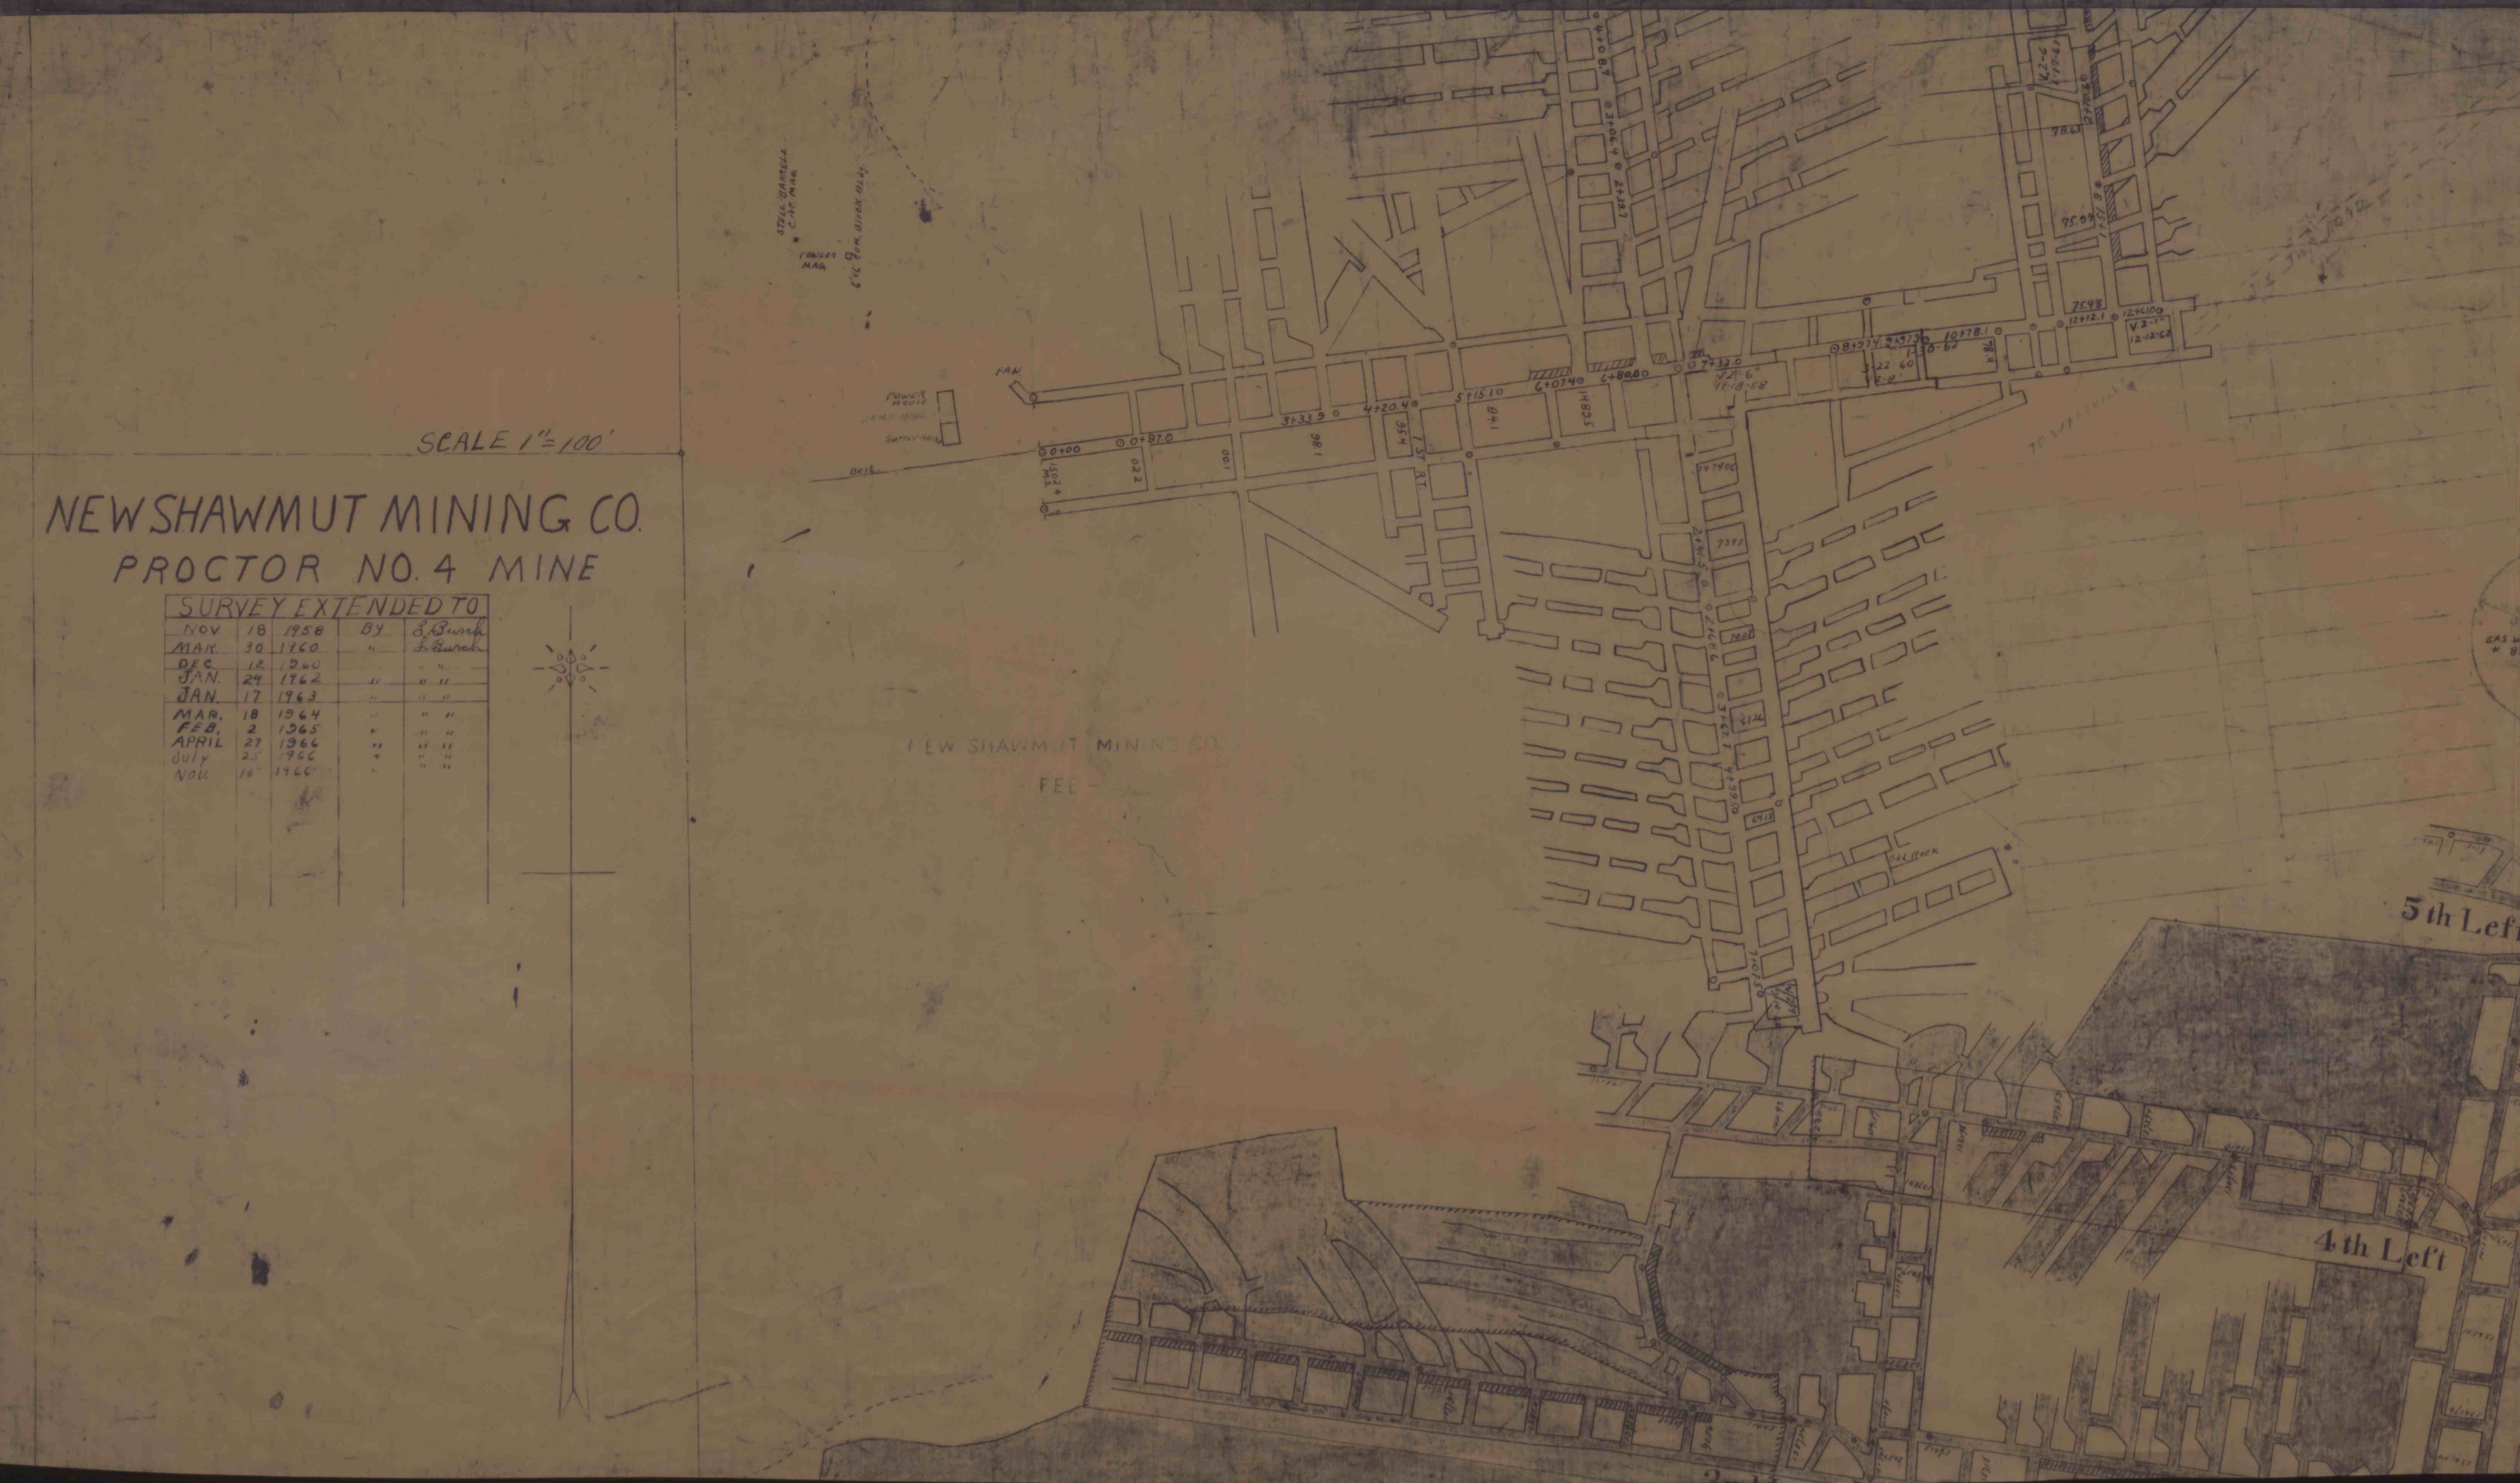


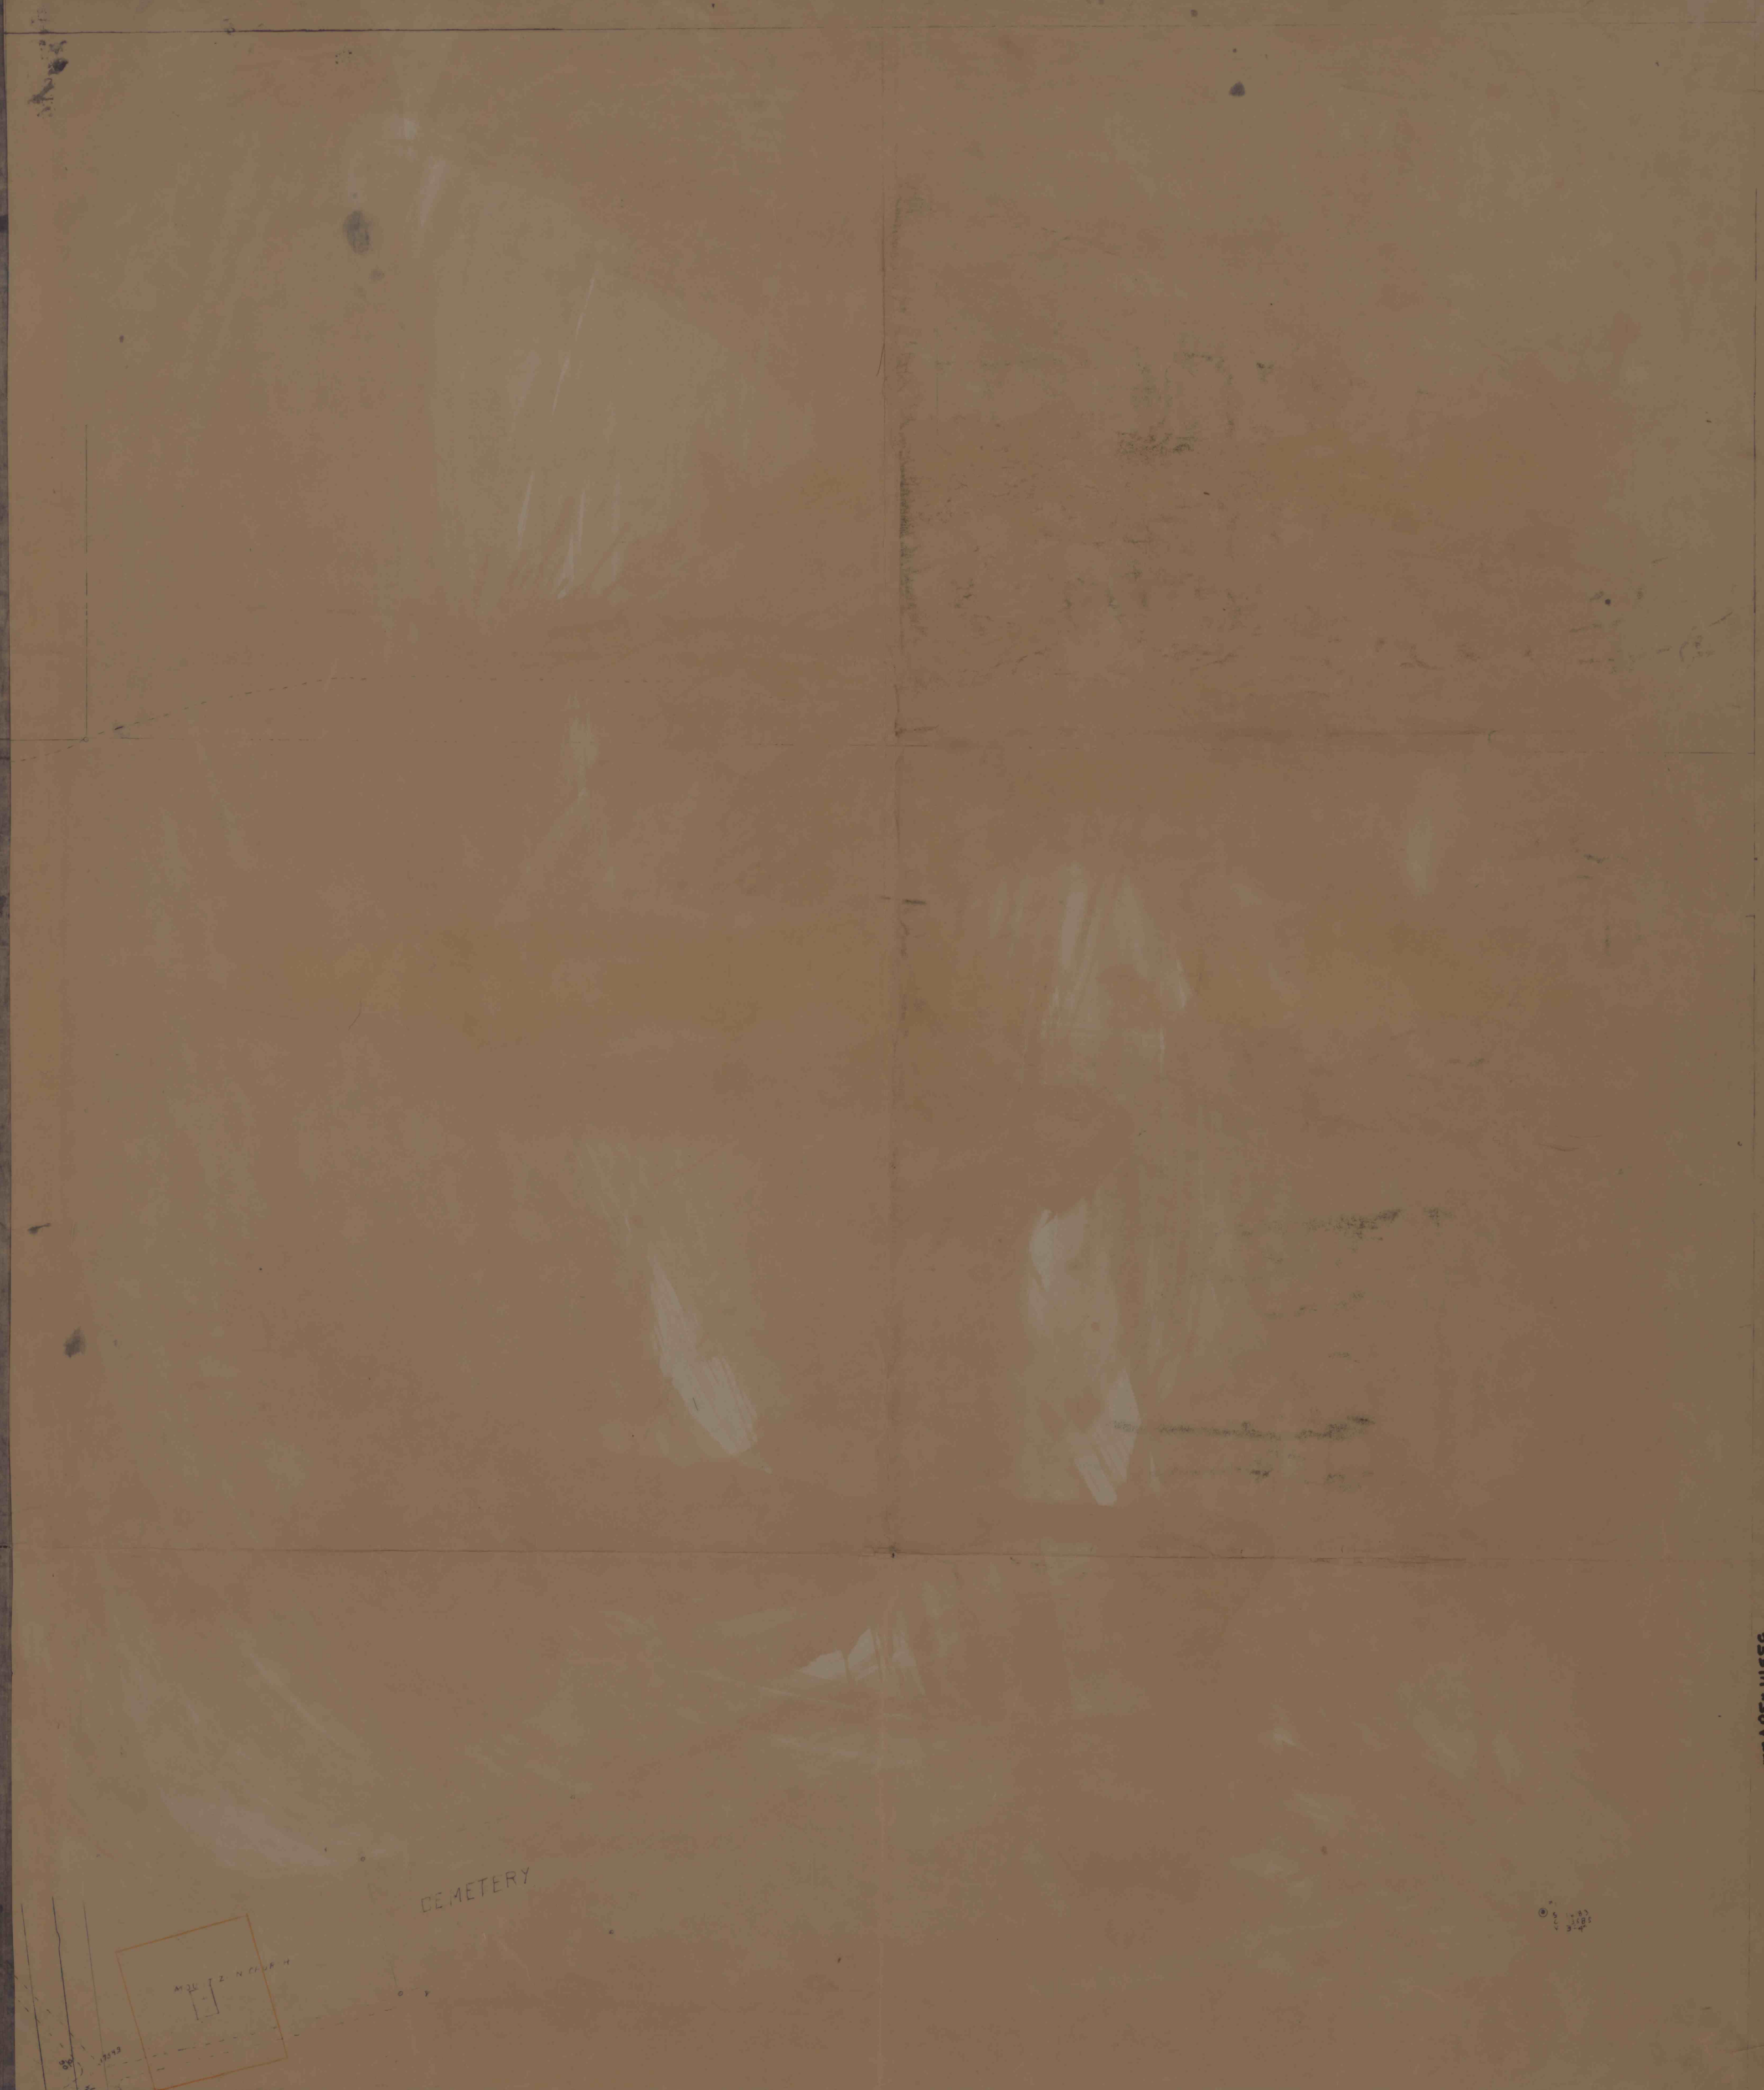

MAP 1415