


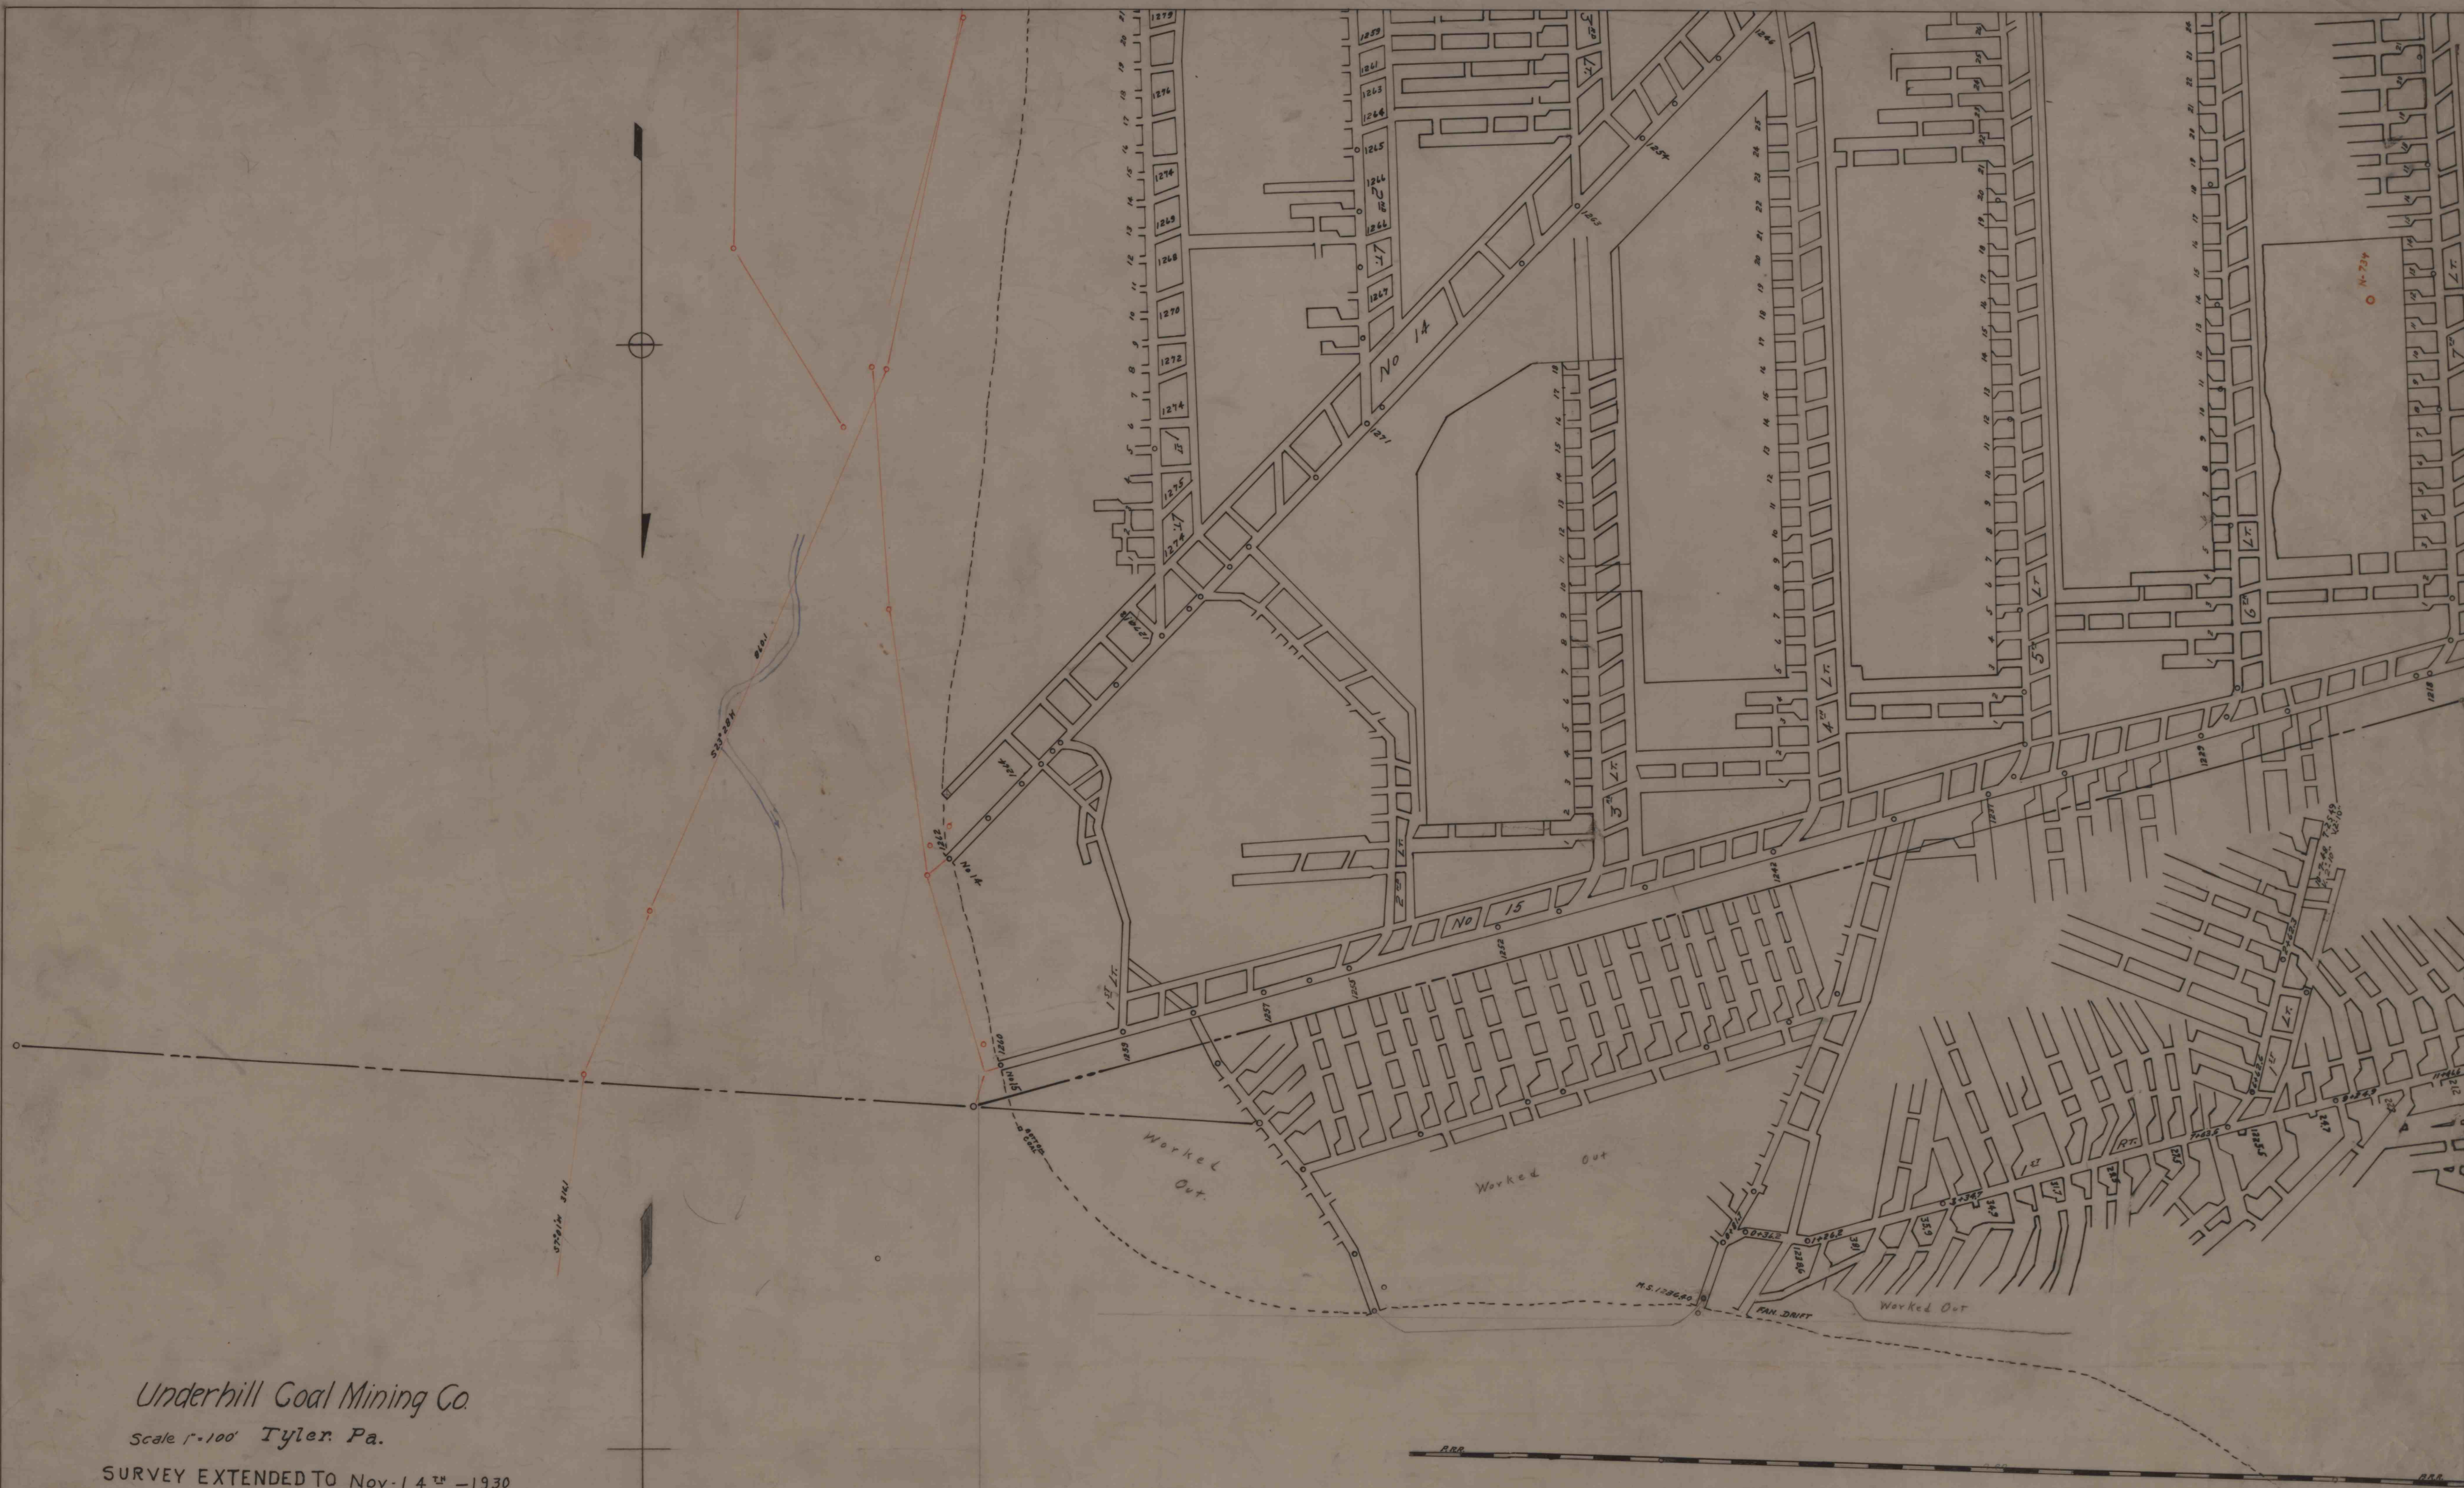

Underhill Coal Mining Co.

Scale 1"=100' Tyler, Pa.

SURVEY EXTENDED TO Nov. 14th - 1930

October 25-1941 - H. H. J. R.R.
 Nov. 26-1947 -
 Oct. 15-1948 - R.R.B.
 Aug. 1-1949 -
 Sept. 1-1950 -
 FEB. 14-1952 -
 FEB. 24-1953 -
 FEB. 12-1954 -
 MAR. 28-1955 -
 DEC. 19-1955 -
 DEC. 9-1957 - J. H. Burch
 JAN. 16-1959 - J. H. Burch
 JAN. 31-1961 - J. H. Burch
 FEB. 12-1962 - J. H. Burch
 MAR. 5-1963 - J. H. Burch
 MAR. 18-1964 - J. H. Burch
 JAN. 14-1965 - J. H. Burch
 Sept. 22-1965 -
 JUNE 29-1966 -
 SEPT. 15-1966 -
 DEC. 30-1966 -