


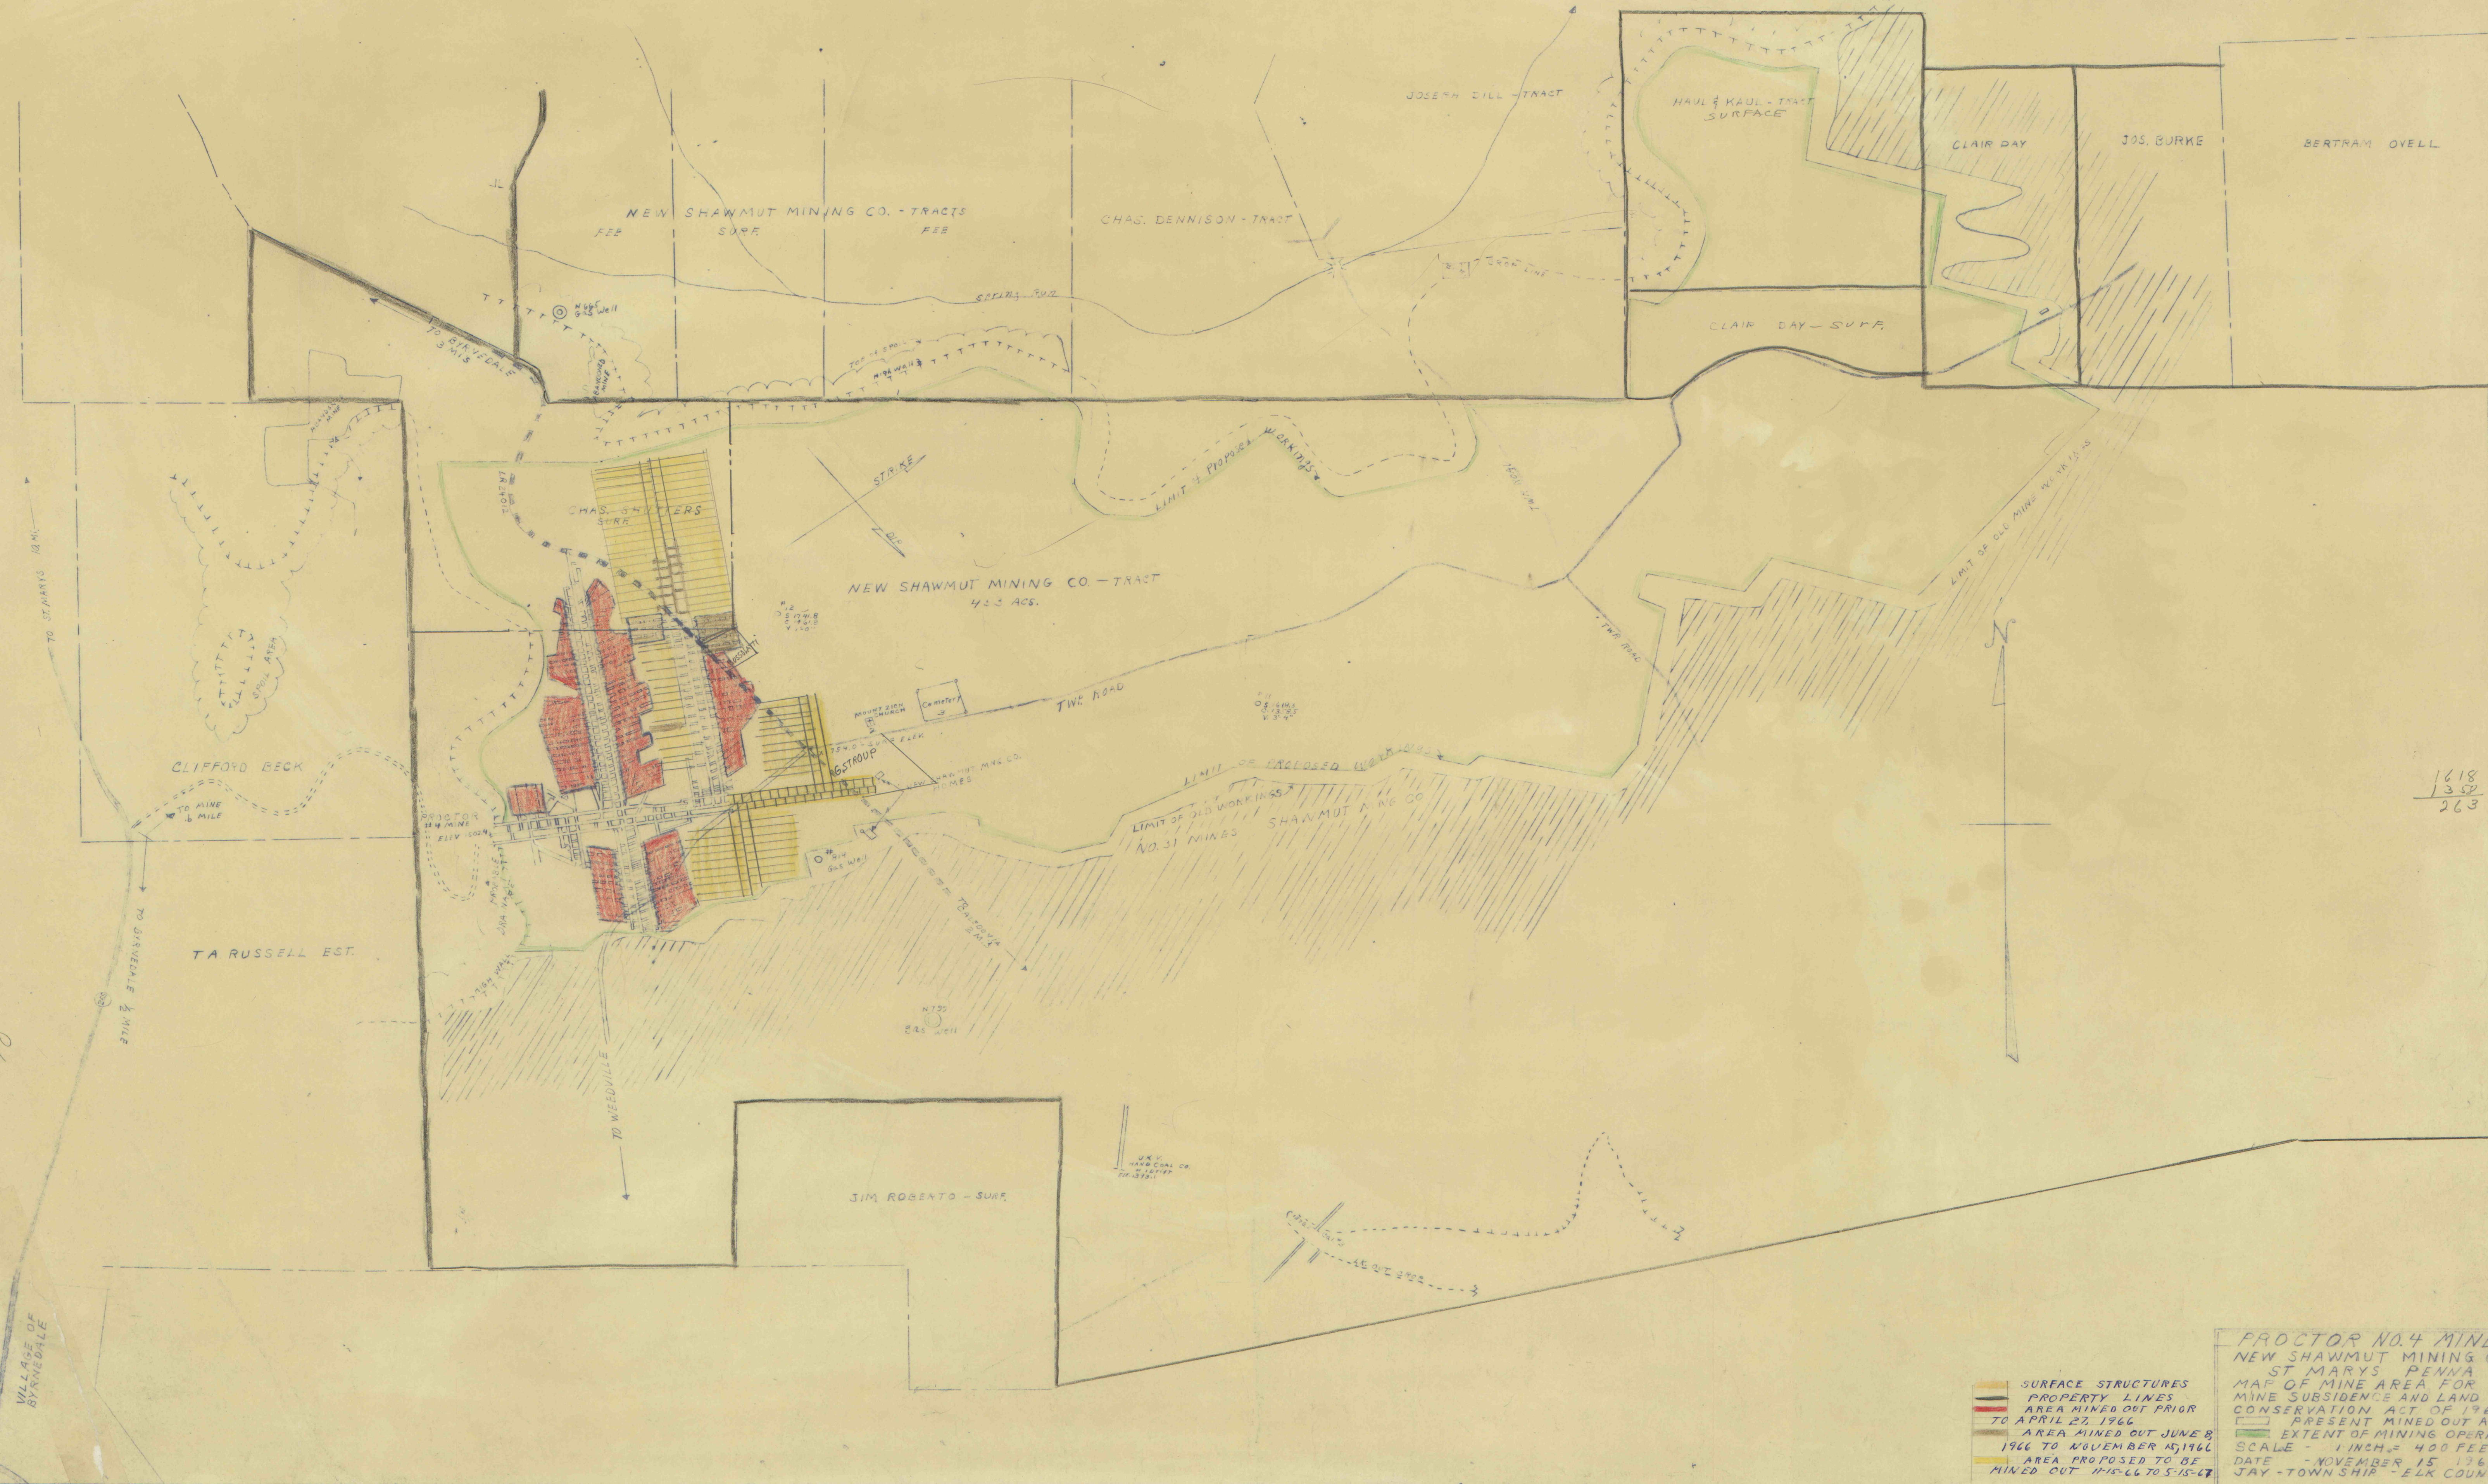

SURFACE STRUCTURES
PROPERTY LINES
AREA MINED OUT PRIOR
TO APRIL 27, 1966
AREA MINED OUT JUNE 8,
1966 TO NOVEMBER 15, 1966
AREA PROPOSED TO BE
MINED OUT 11-15-66 TO 5-15-67

PROCTOR NO. 4 MINE
NEW SHAWMUT MINING CO
ST. MARYS, PENNA
MAP OF MINE AREA FOR
MINE SUBSIDENCE AND LAND
CONSERVATION ACT OF 1966
 PRESENT MINED OUT AREA
 EXTENT OF MINING OPERATION
SCALE - 1 INCH = 400 FEET
DATE - NOVEMBER 15 1966
JAY - TOWNSHIP - ELK COUNTY