


MOOSE RUN COAL CO.
MINE No 1.
NEAR FENFIELD,
CLEARFIELD COUNTY, PA.

J. E. FRY, M.E., OYB015, PA.

Apr 13-1927

Scale 100' = 1"
March 18-1927

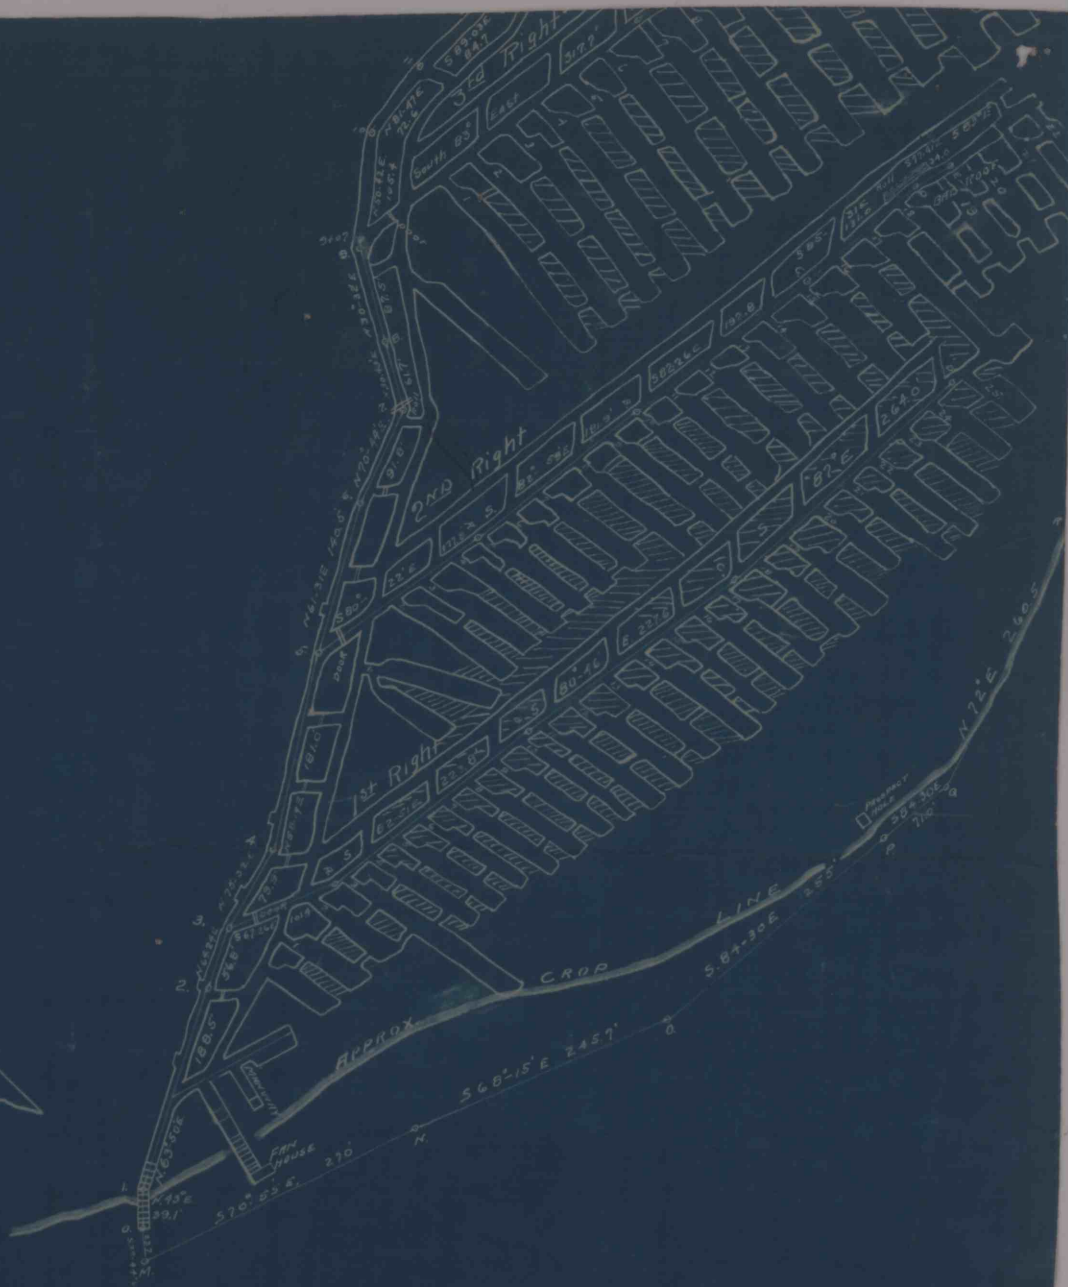

IMAPS #15016