


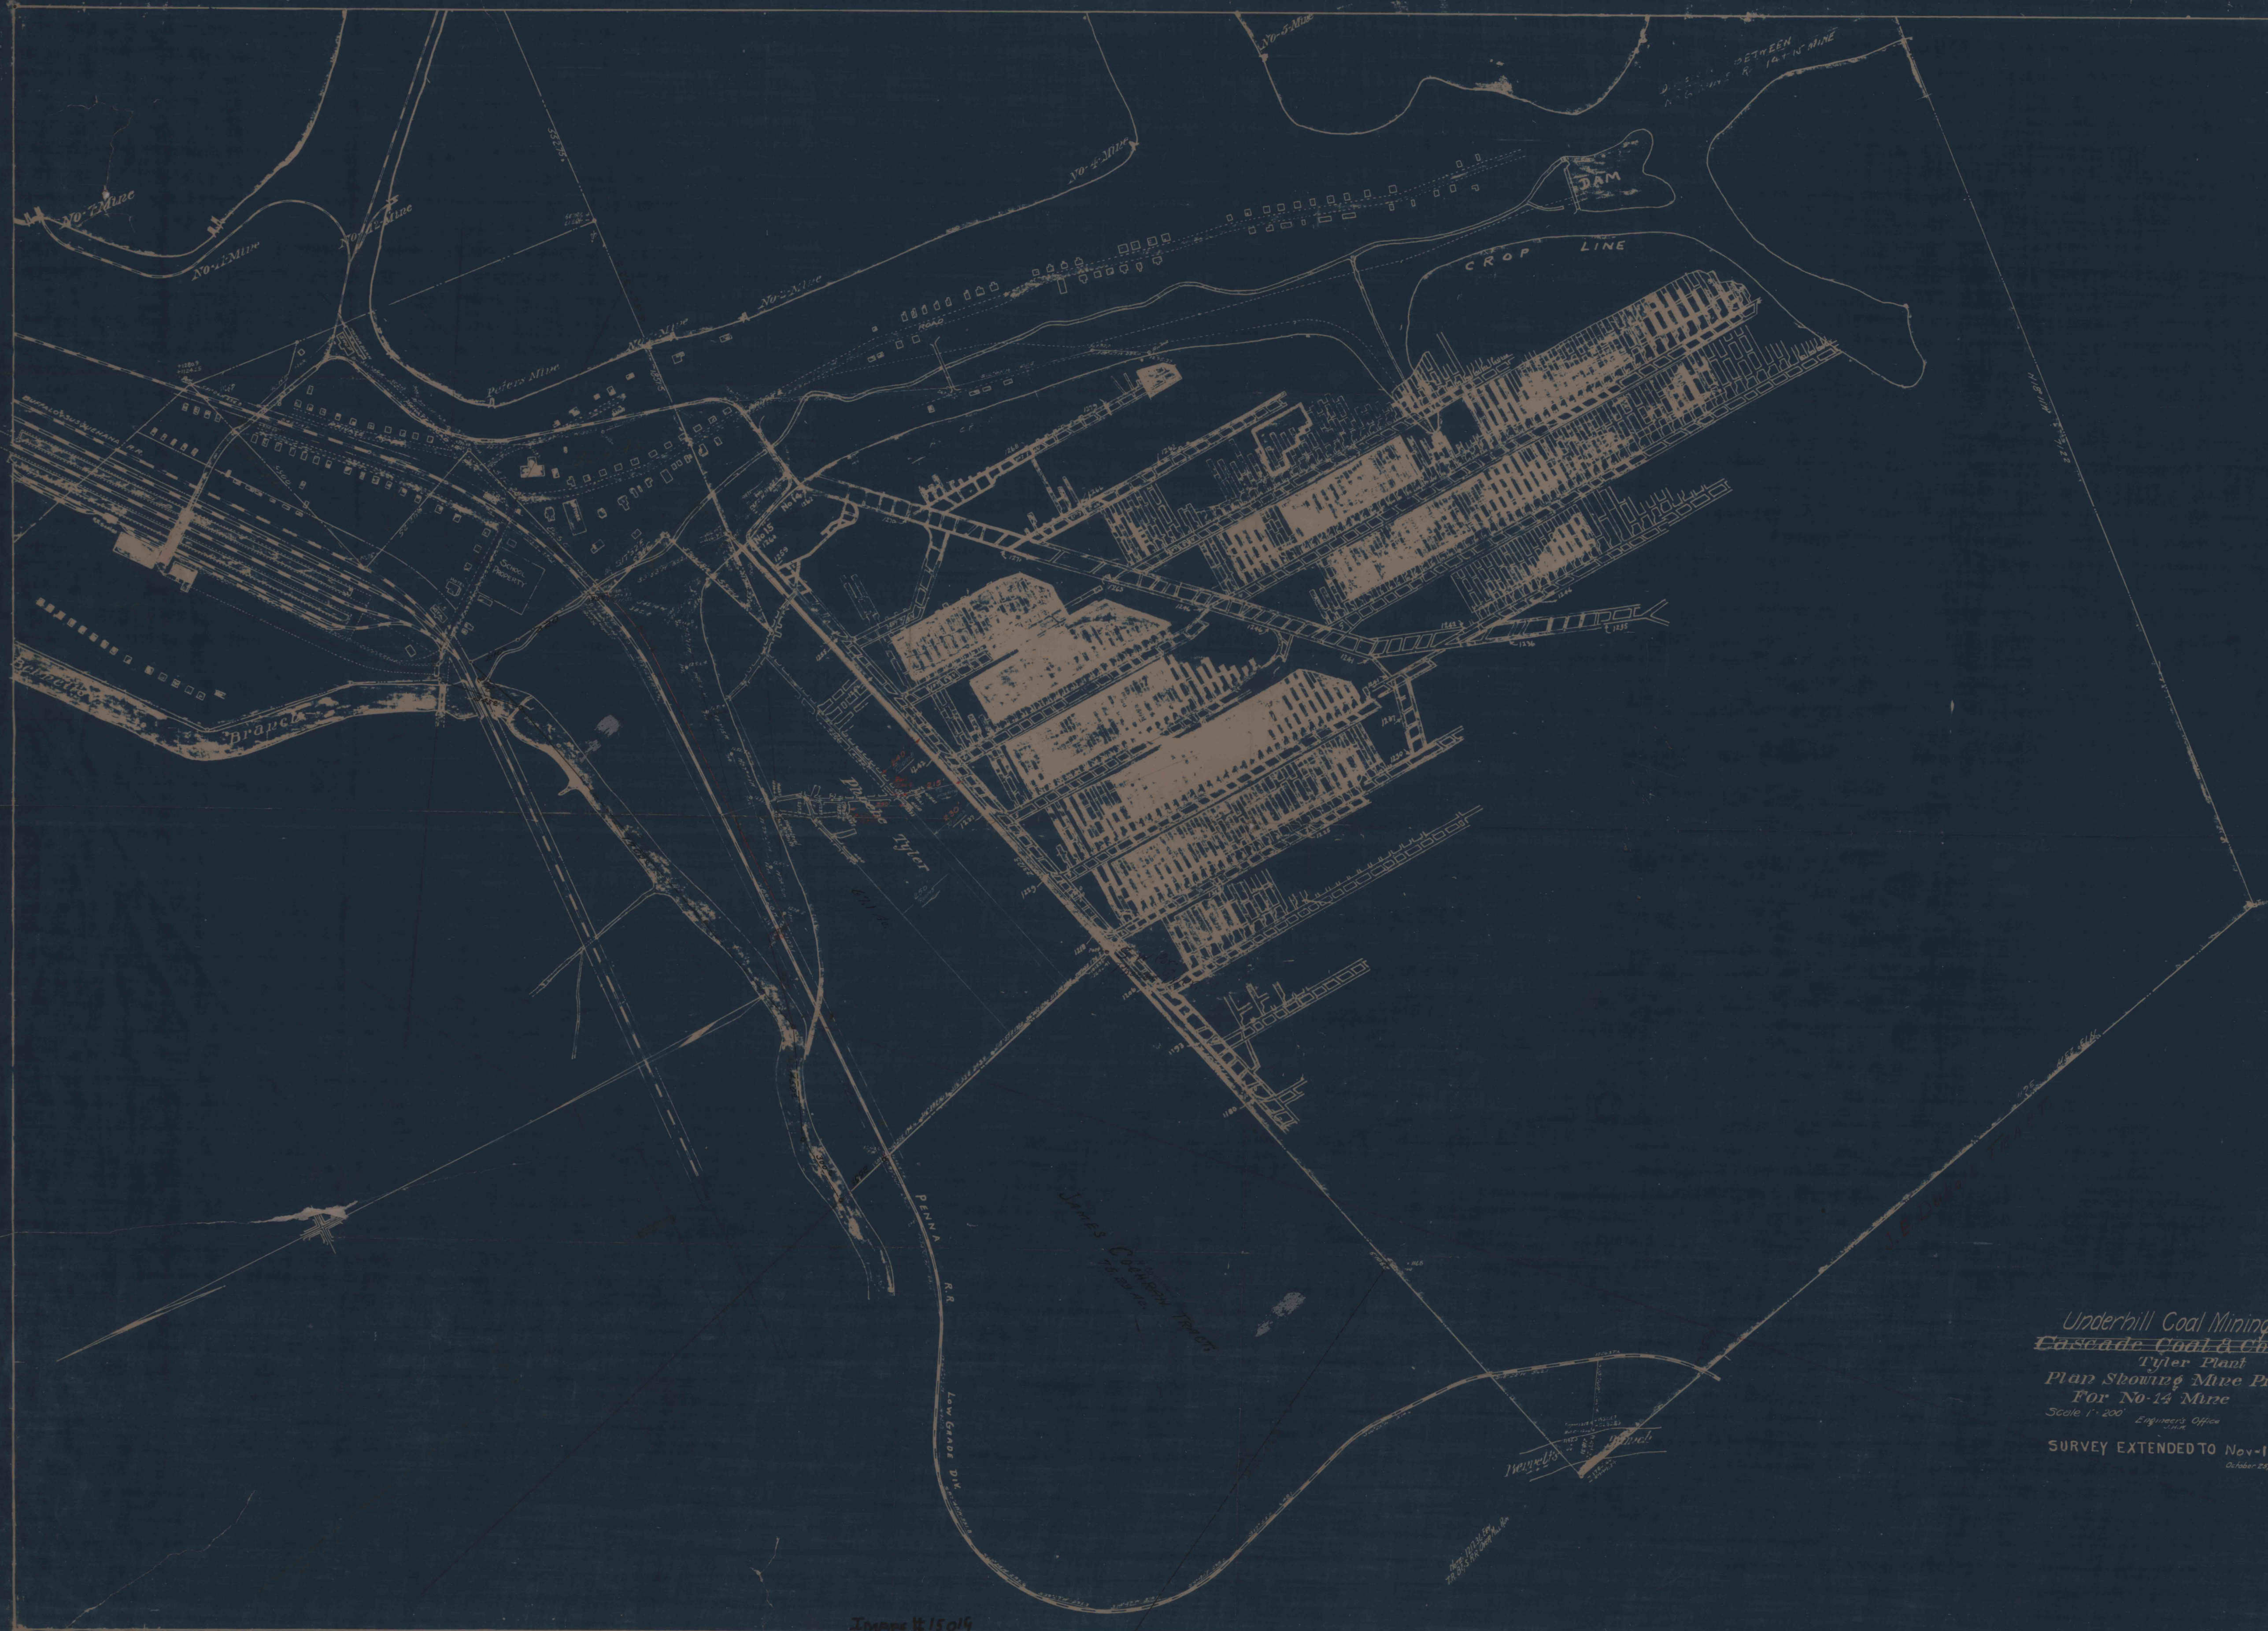

Underhill Coal Mining Co.
~~Cascade Coal & Coke Co.~~
Tyler Plant
Plan Showing Mine Projection
For No. 14 Mine
Scale 1" = 200' Engineering Office
SURVEY EXTENDED TO Nov-14th-1930
October 22, 1930. A. A. J. 1930