


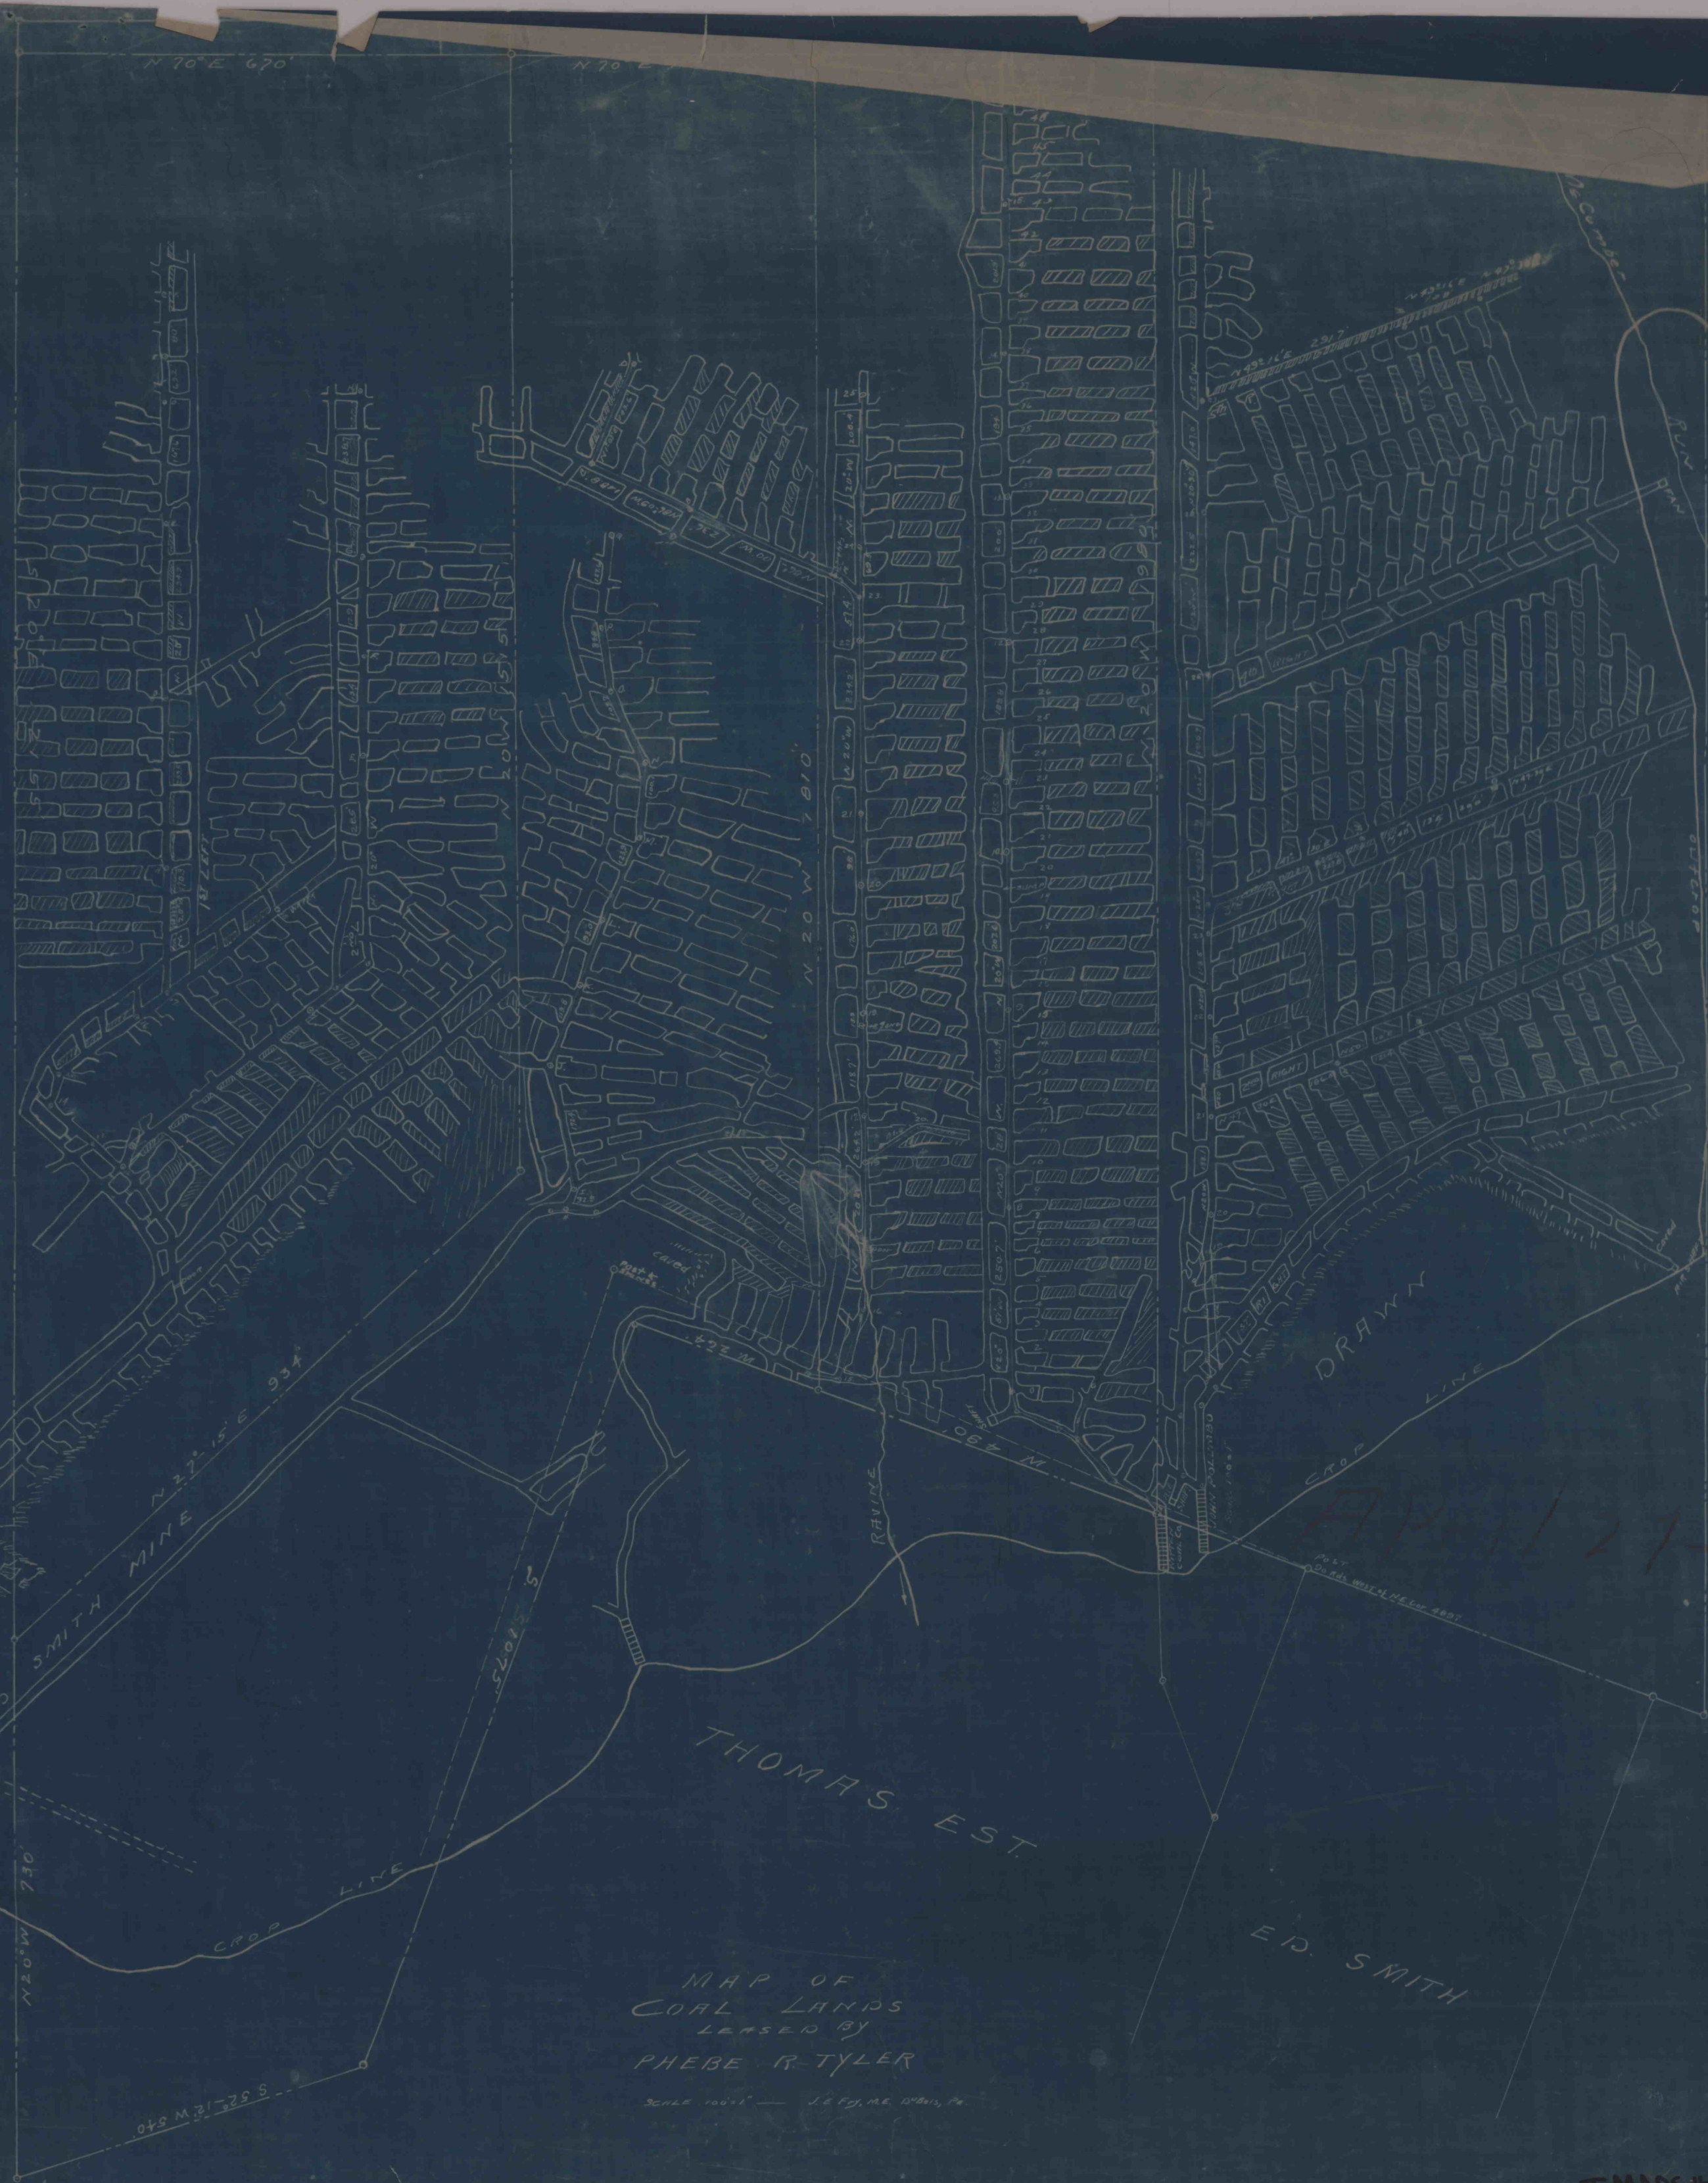

APR 21-27

MAP OF
COAL LANDS
LEASED BY
PHEBE R. TYLER

SCALE 100' = 1" — J. C. FAY, ME. 10/20/11, PA.