


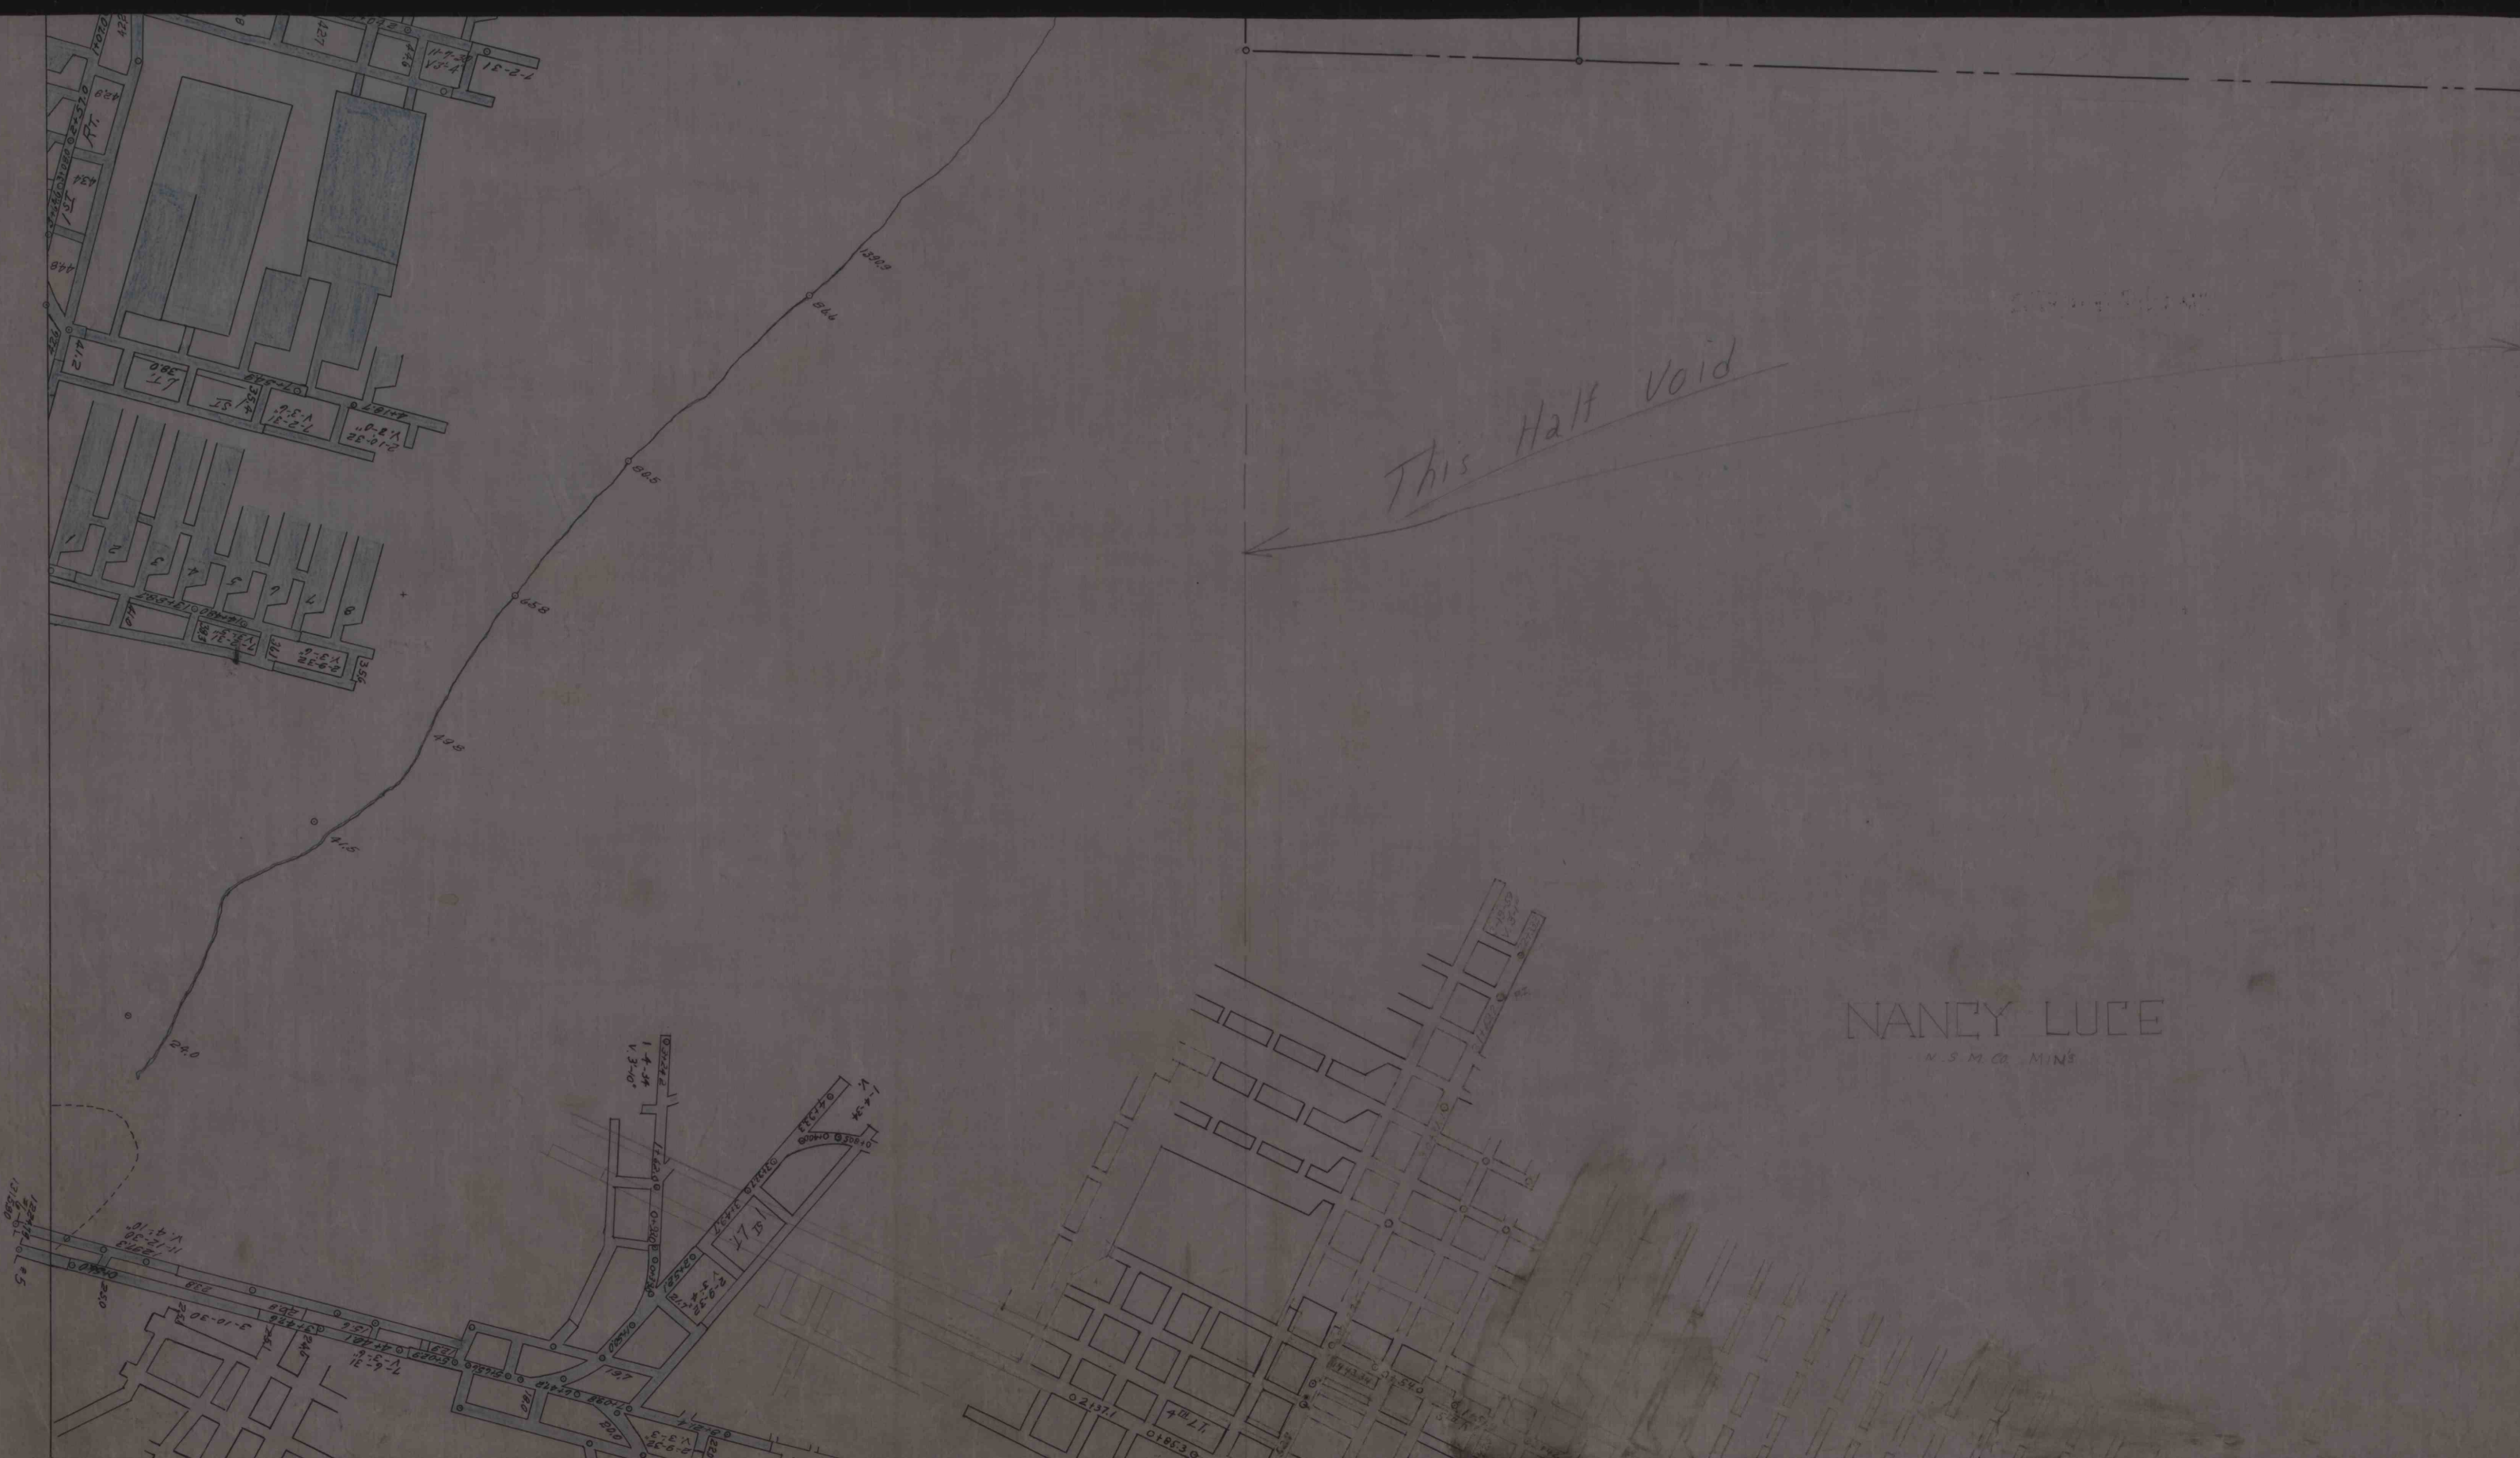

NANCY LUCE
N. S. M. CO. MINS