


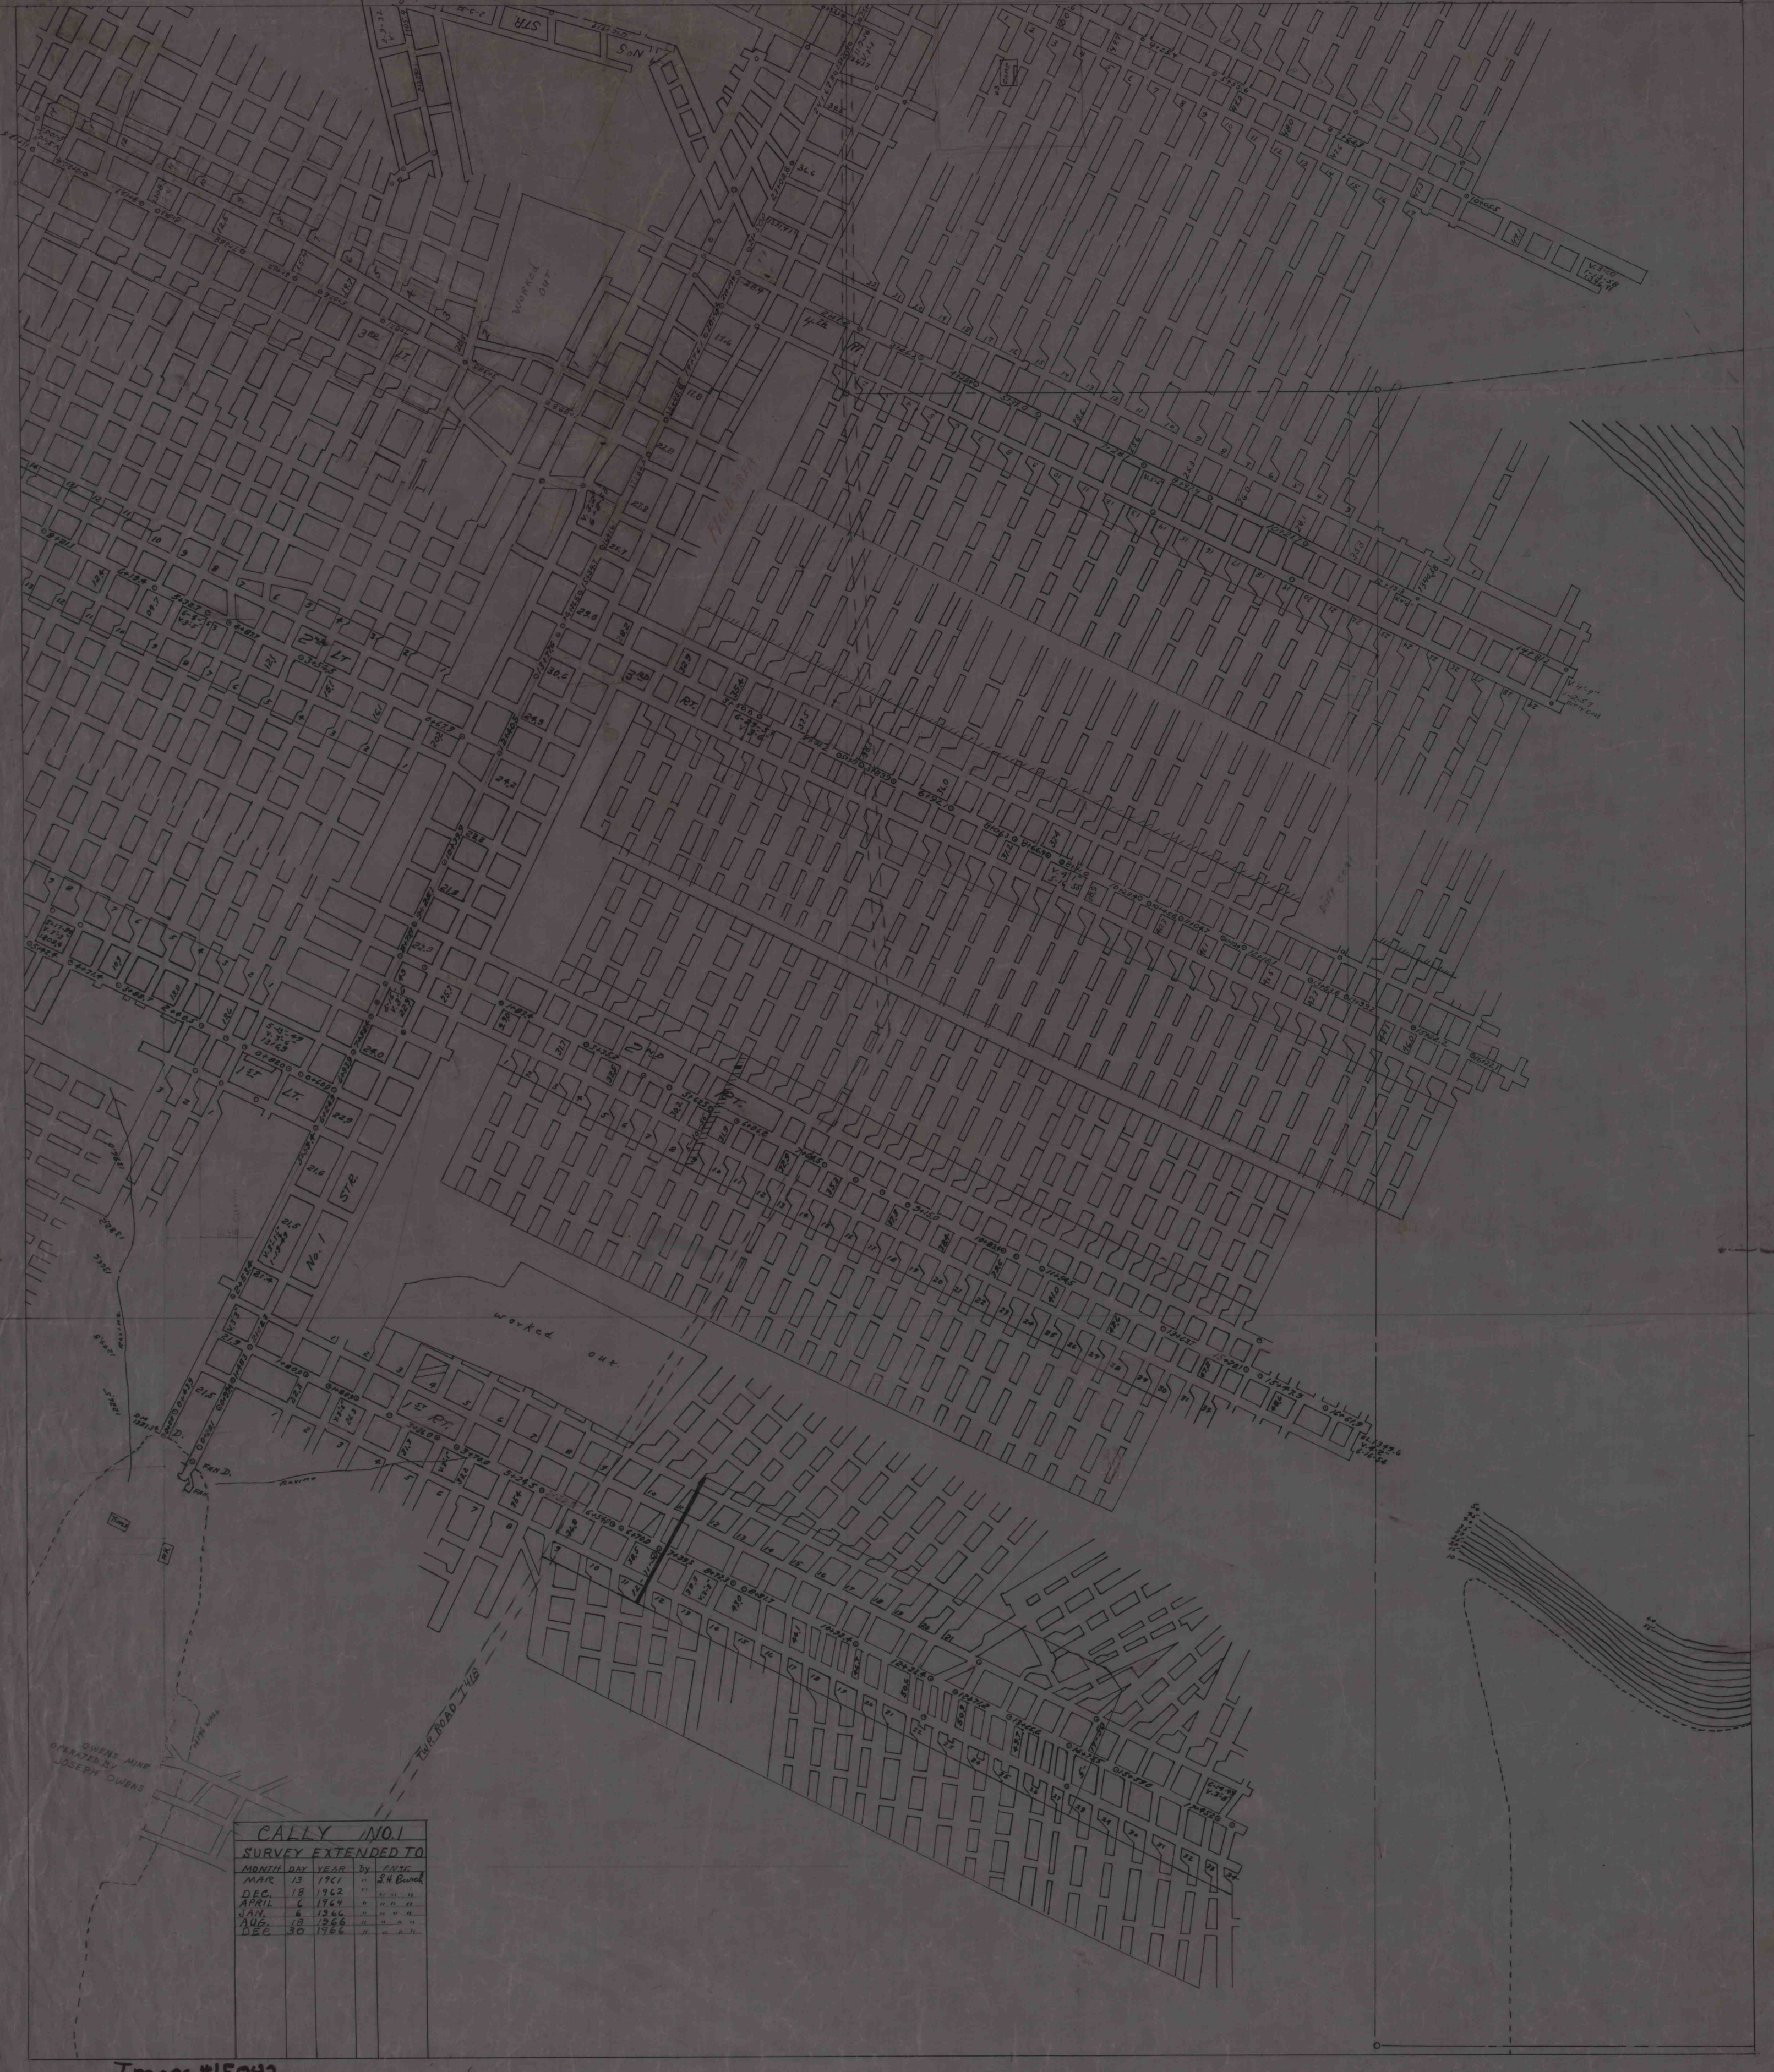

CALLY NO. 1				
SURVEY EXTENDED TO				
MONTH	DAY	YEAR	BY	NOTE
MAR.	13	1901	"	J. H. Bunch
DEC.	18	1902	"	"
APRIL	6	1904	"	"
JAN.	6	1906	"	"
AUG.	18	1906	"	"
DEC.	30	1906	"	"