


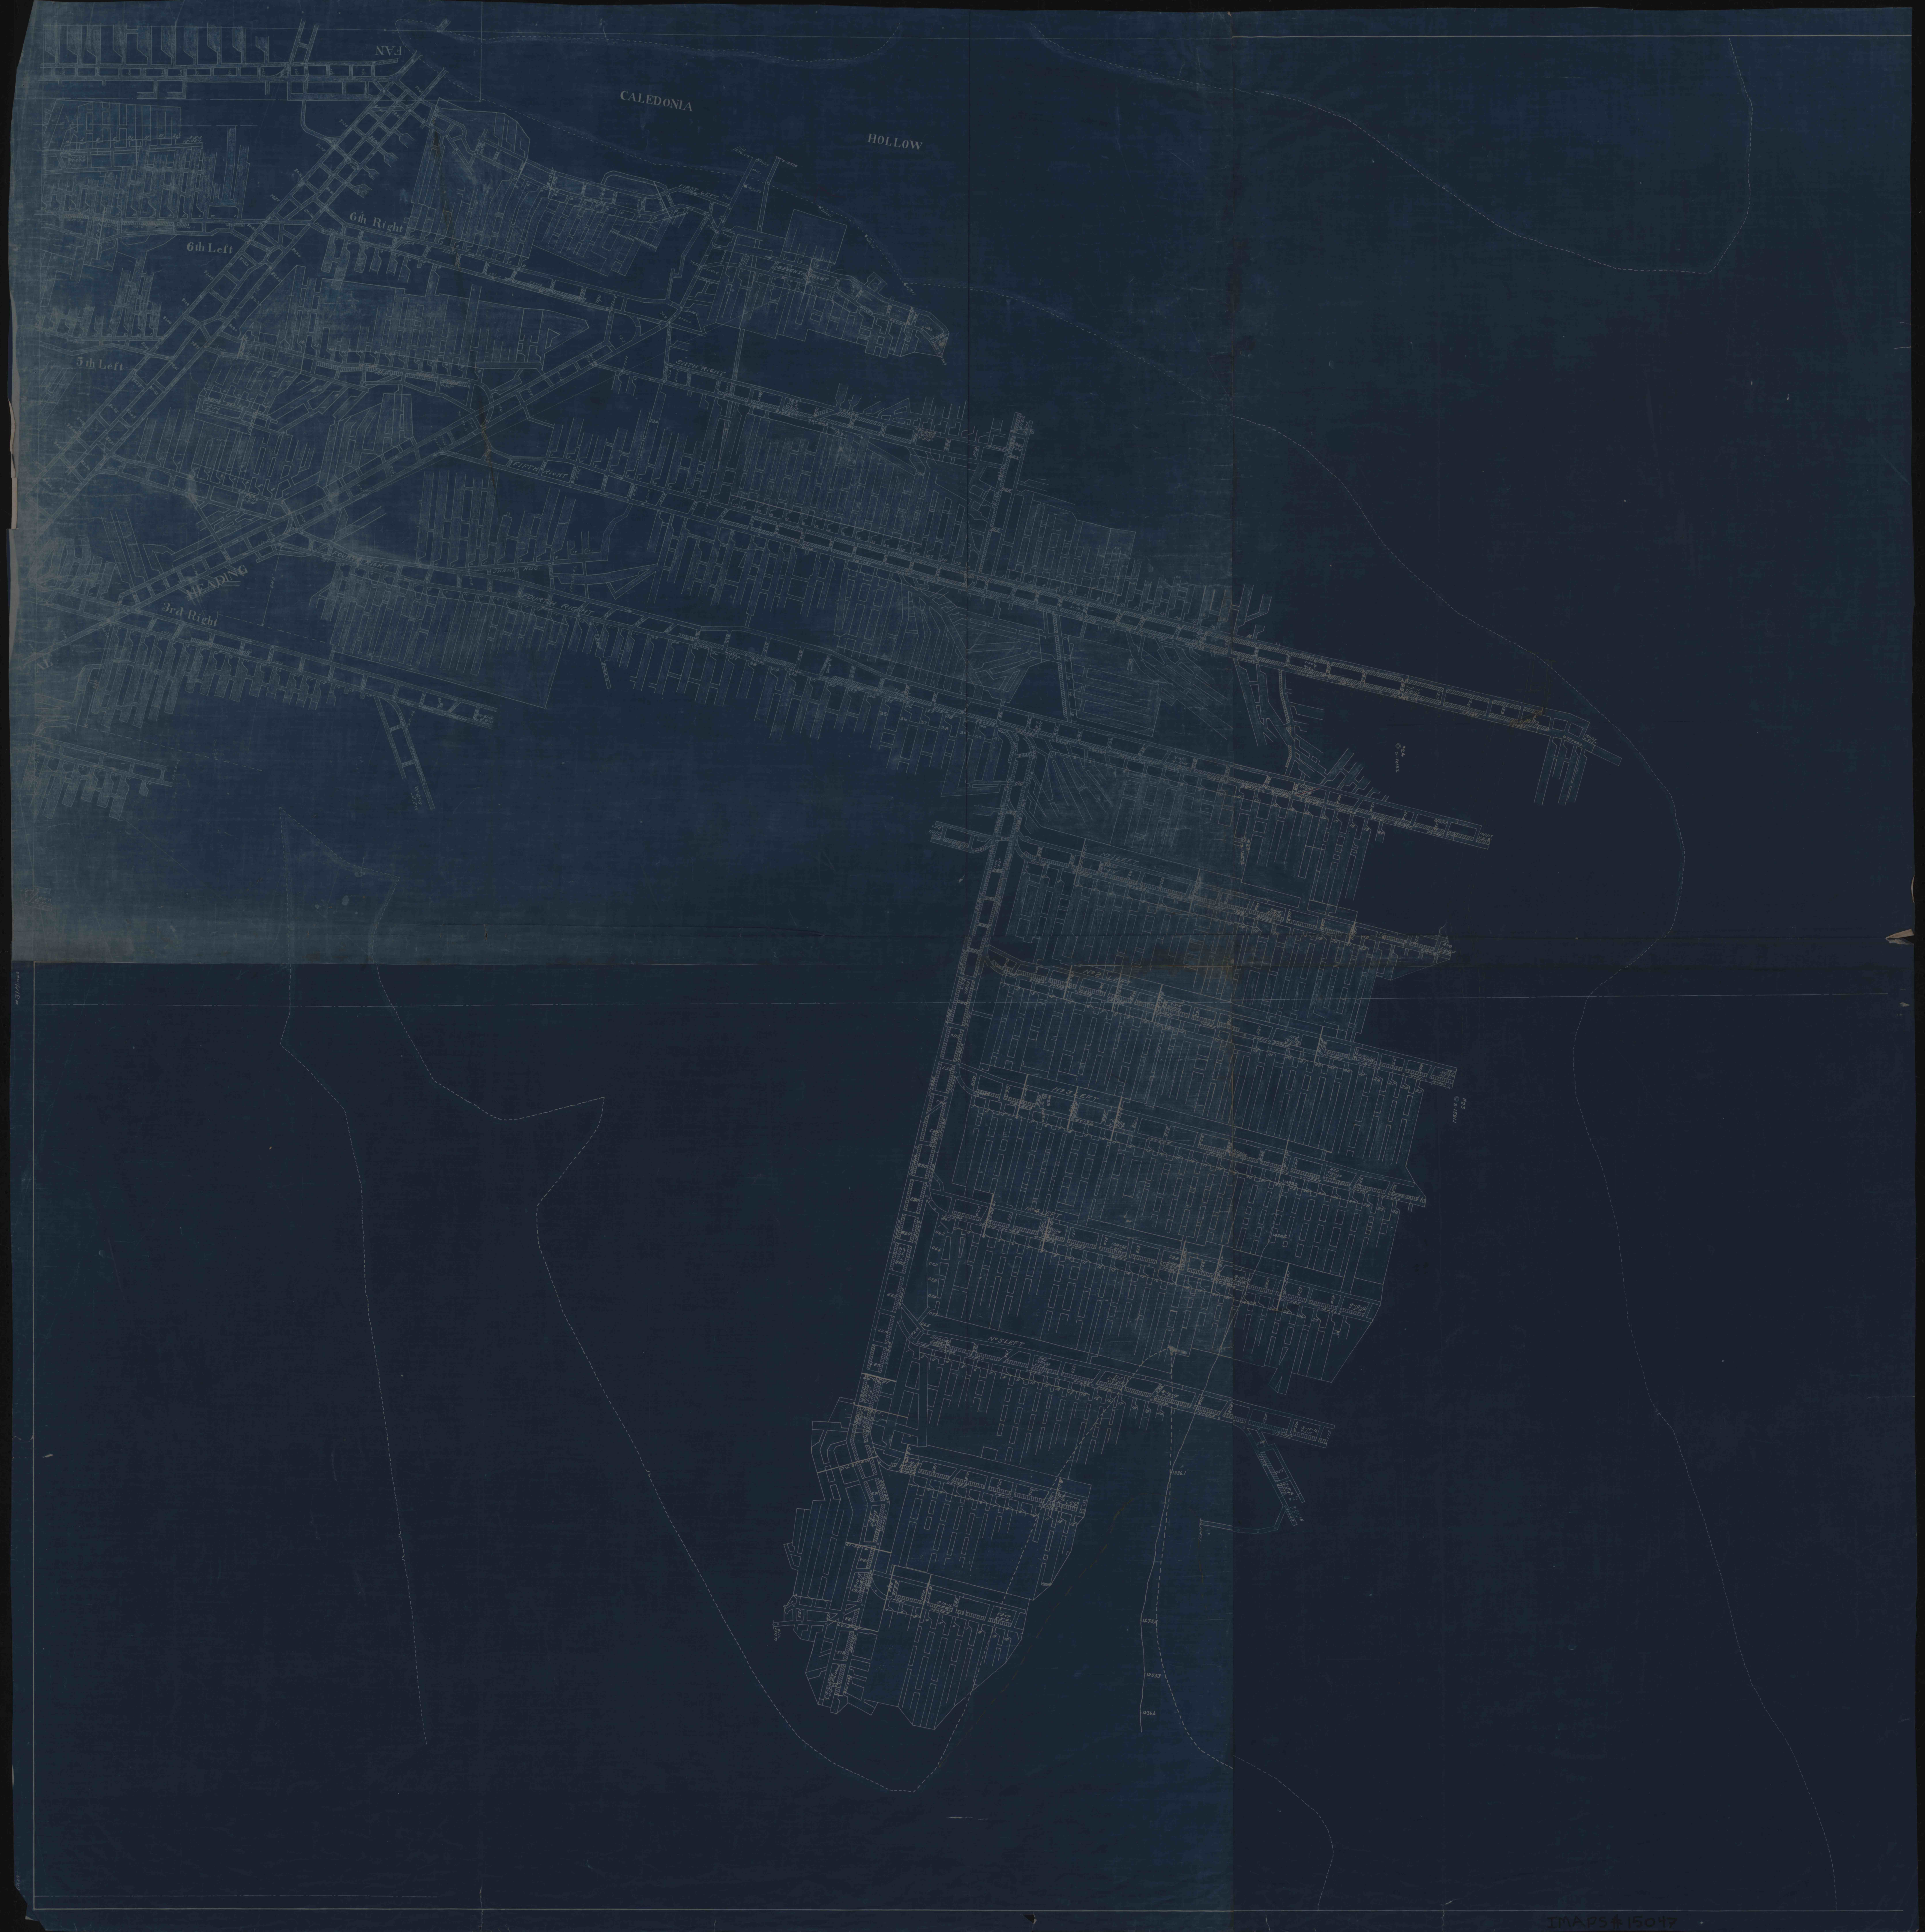

CALEDONIA

HOLLOW

6th Right

6th Left

5th Left

HEADING

3rd Right