


Joe Owens.

AUGER MINED ALONG CROP

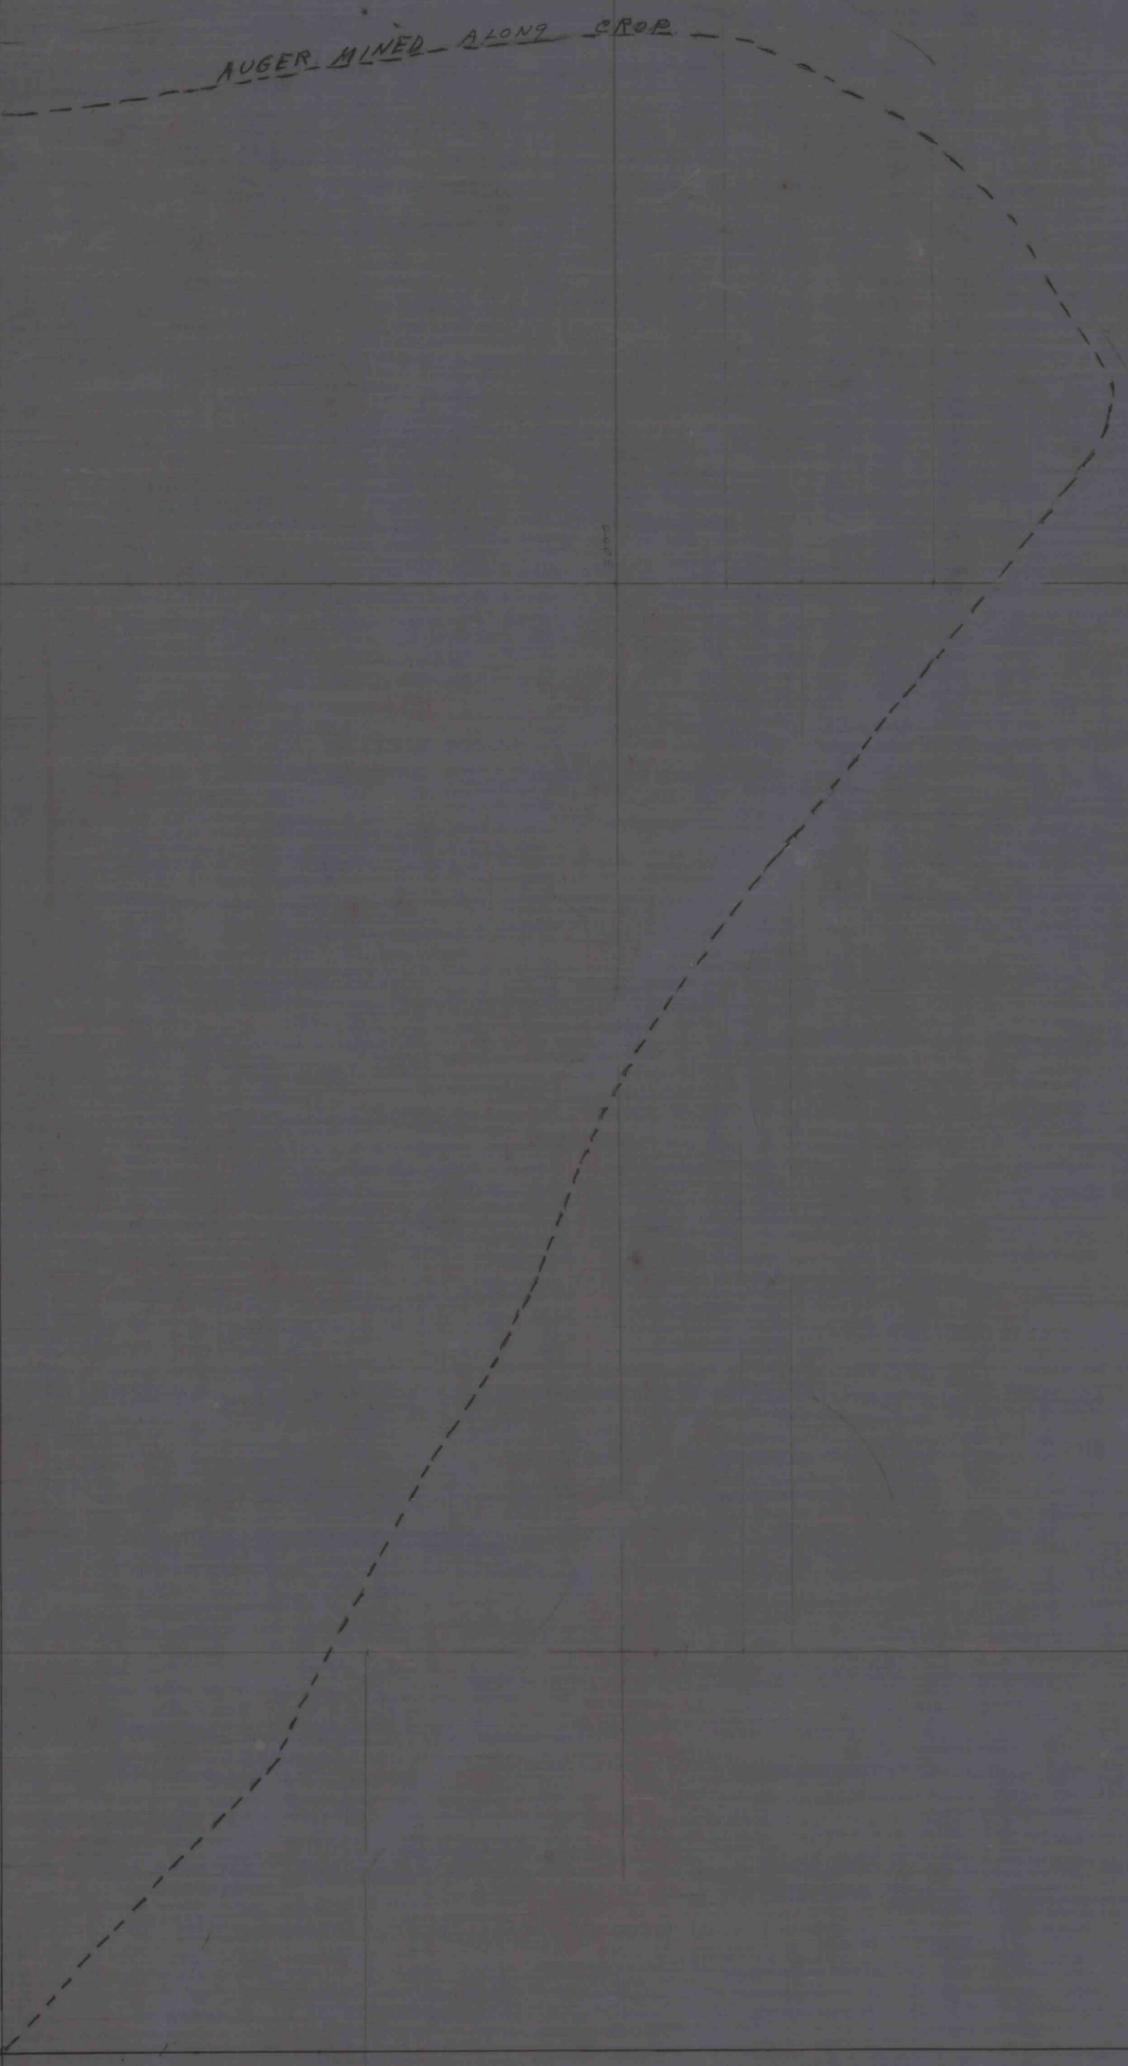

IMAPS # 15048