SCALE 1" = 100'

NEW SHAWMUT MINING CO.

PROCTOR NO. 4 MINE

SURVEY EXTENDED TO				
NOV	18	1938	BY	S.G. Crane
MAR	30	1940	"	"
DEC	24	1940	"	"
JAN	22	1942	"	"
JAN	17	1944	"	"

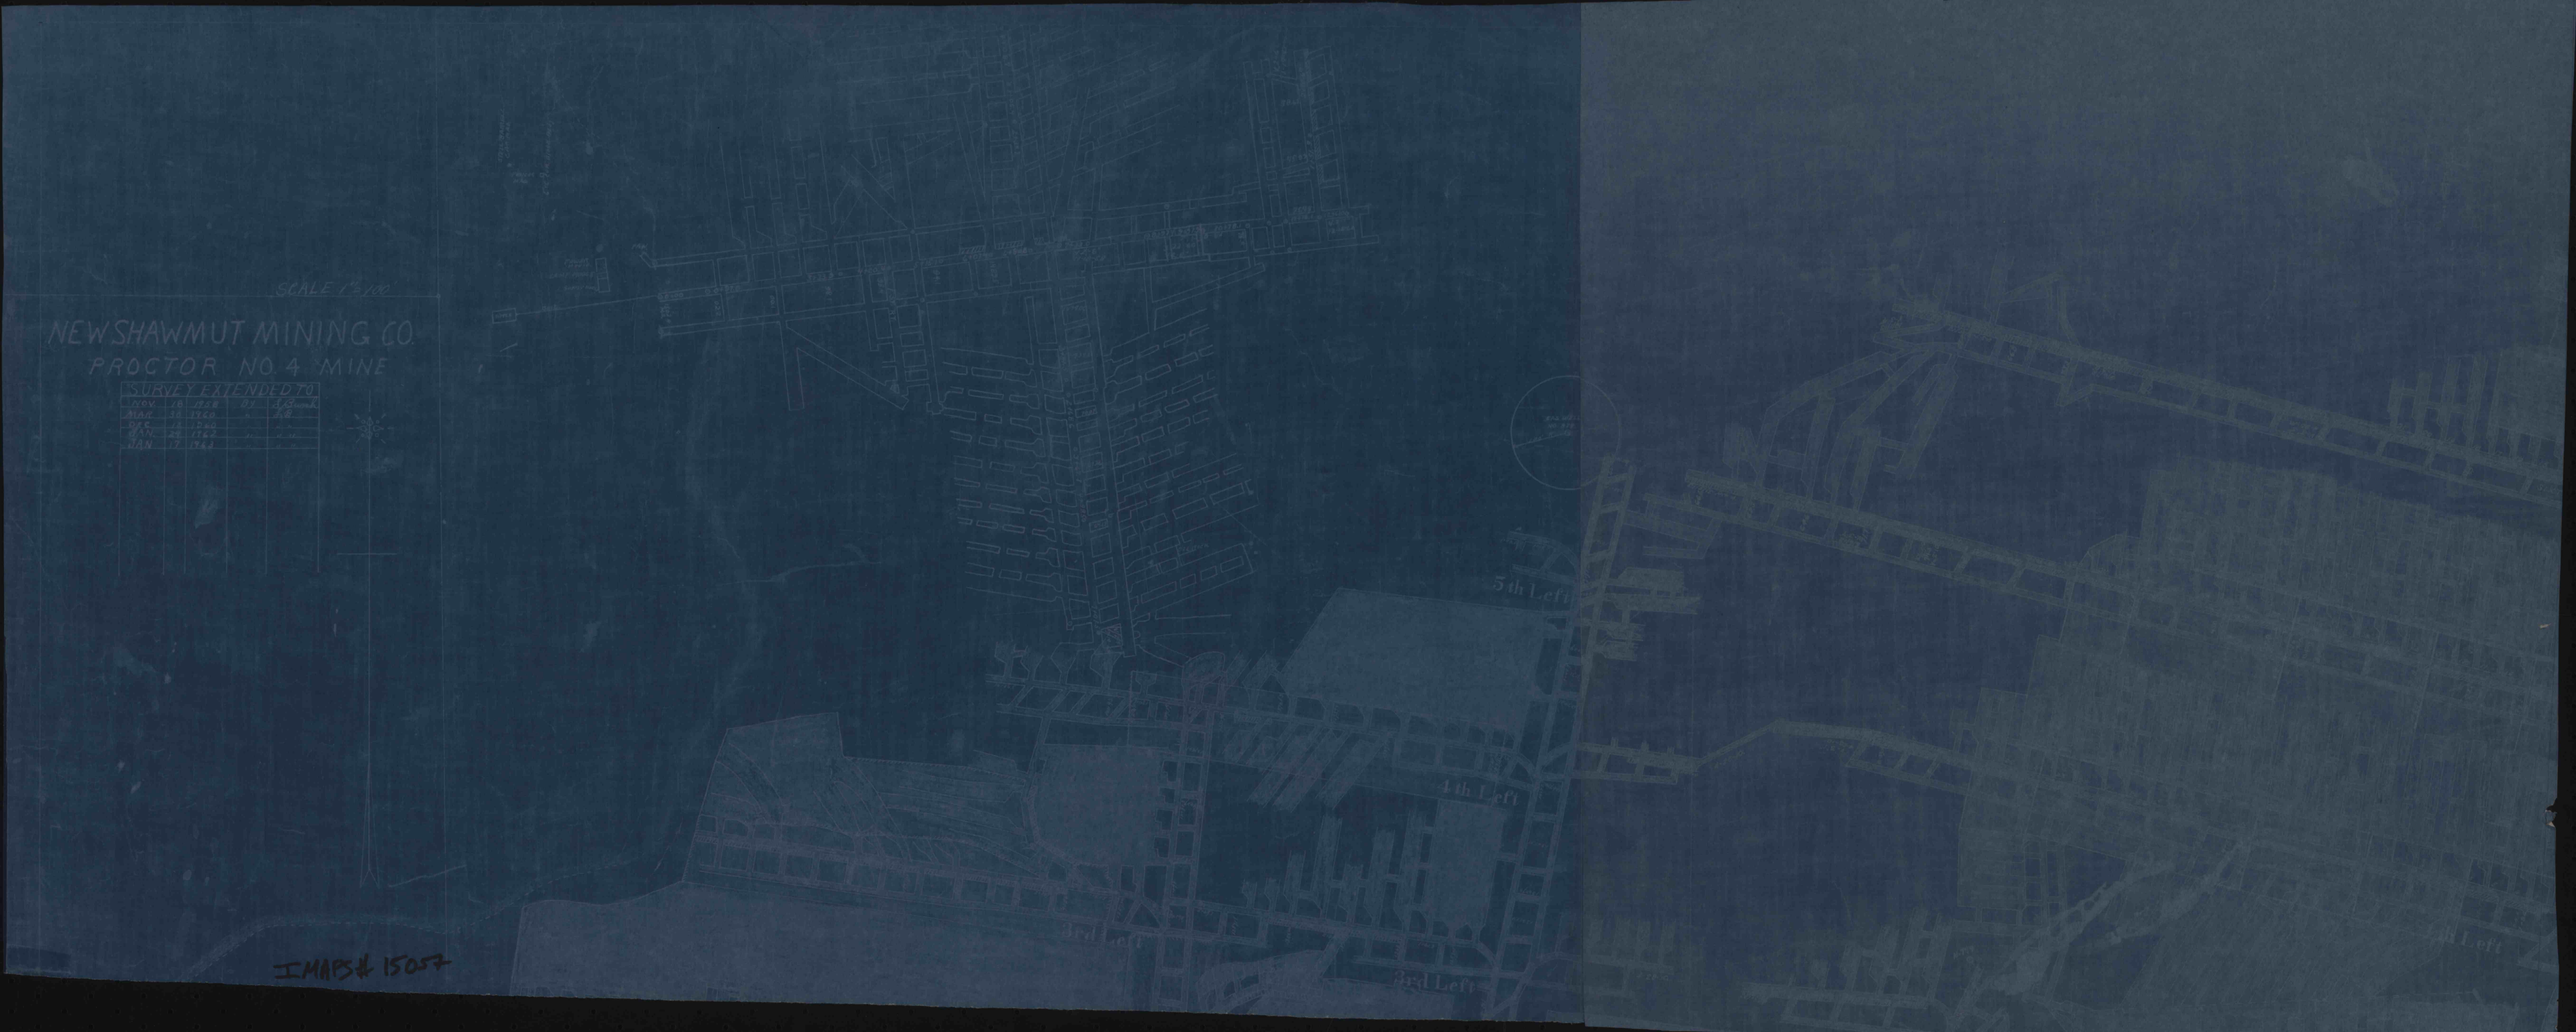

IMAB# 15057