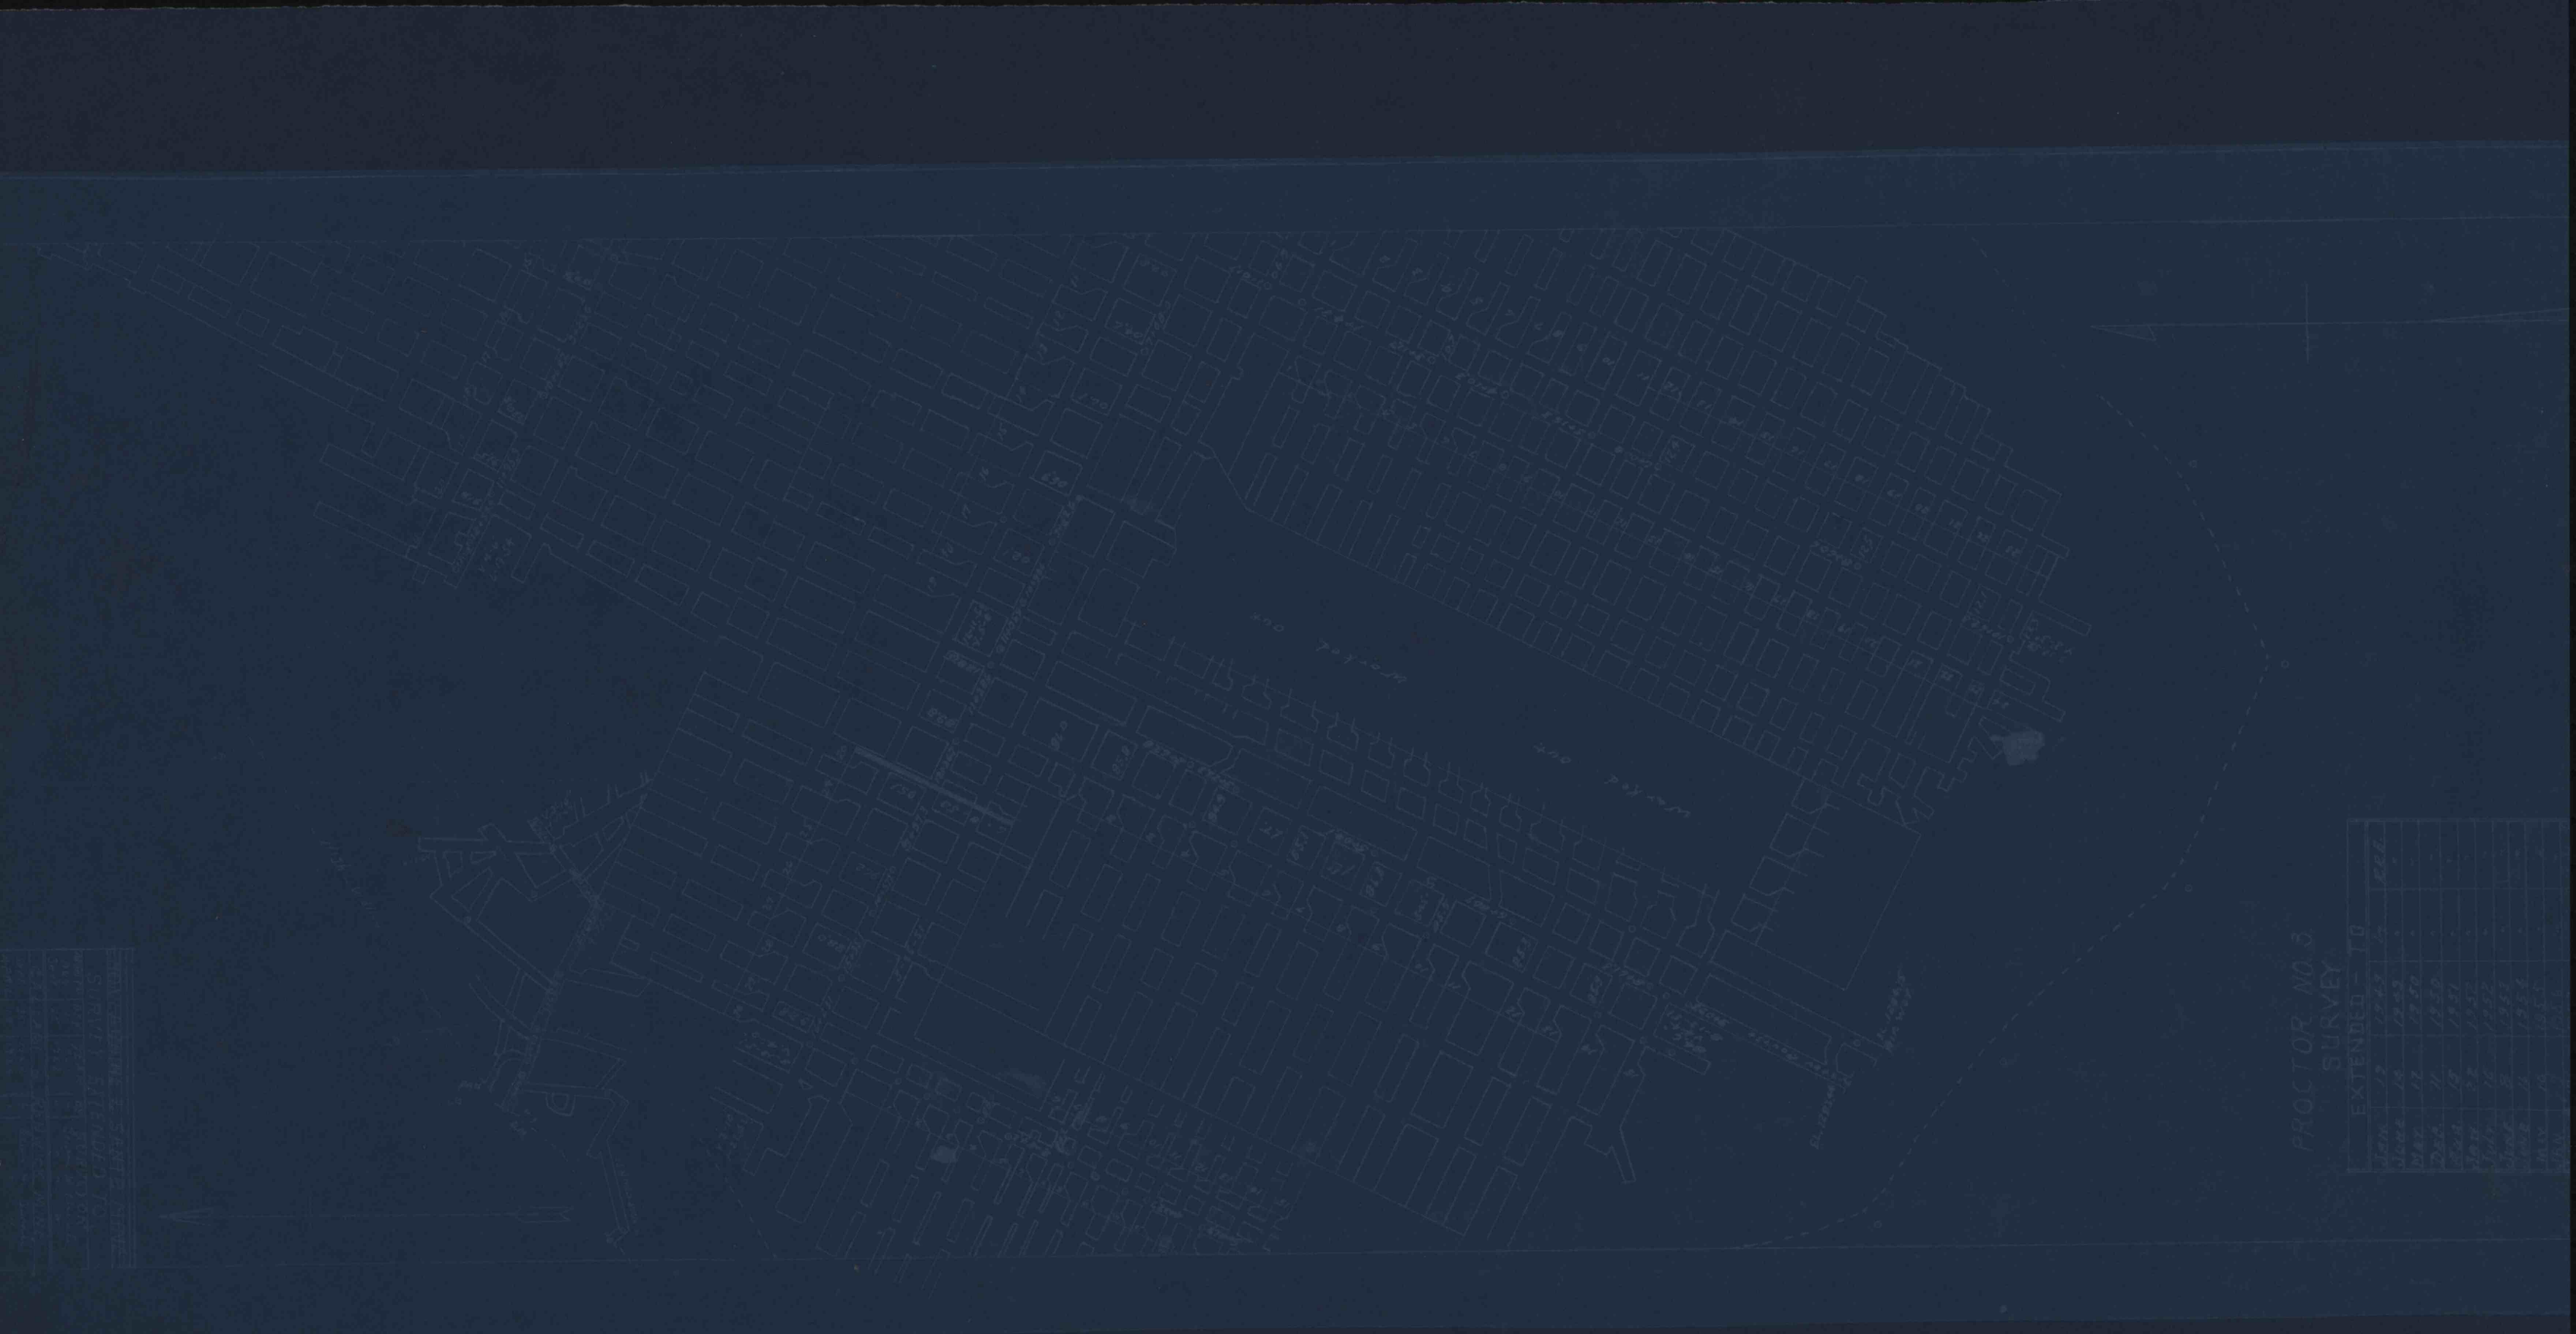
PROCTOR NO. 3
SURVEY
EXTENDED TO
1926
1926
1926