


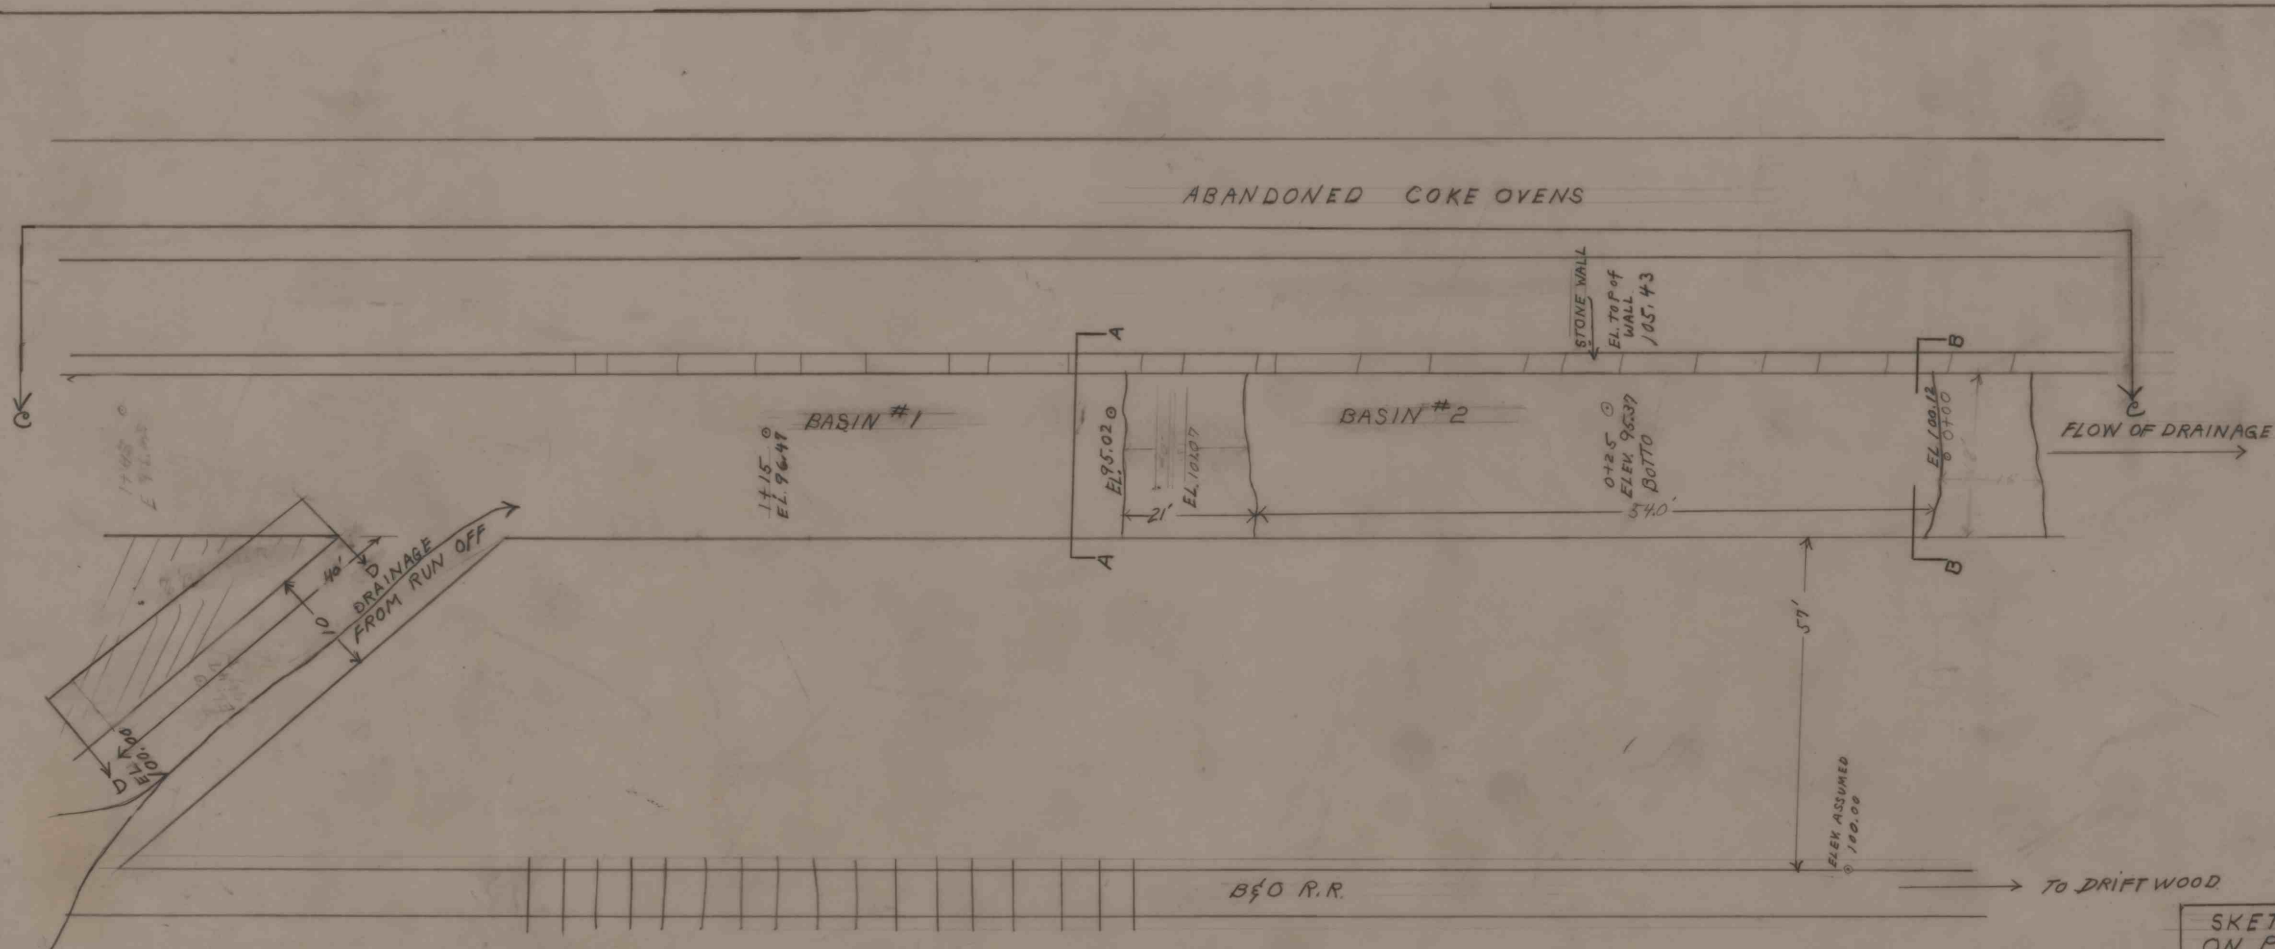

SKETCH OF CATCH BASIN
 ON PLAN PI-PR-1-2-A OF
 NEW SHAWMUT MINING CO.
 ST. MARYS, PENNA.
 DATE 8-9-65
 NOT TO SCALE
 DRAWN BY LEWIS H. BURCH
 NO. PI-PR-1-2-B. 1 18 24

IMAPS#15065