


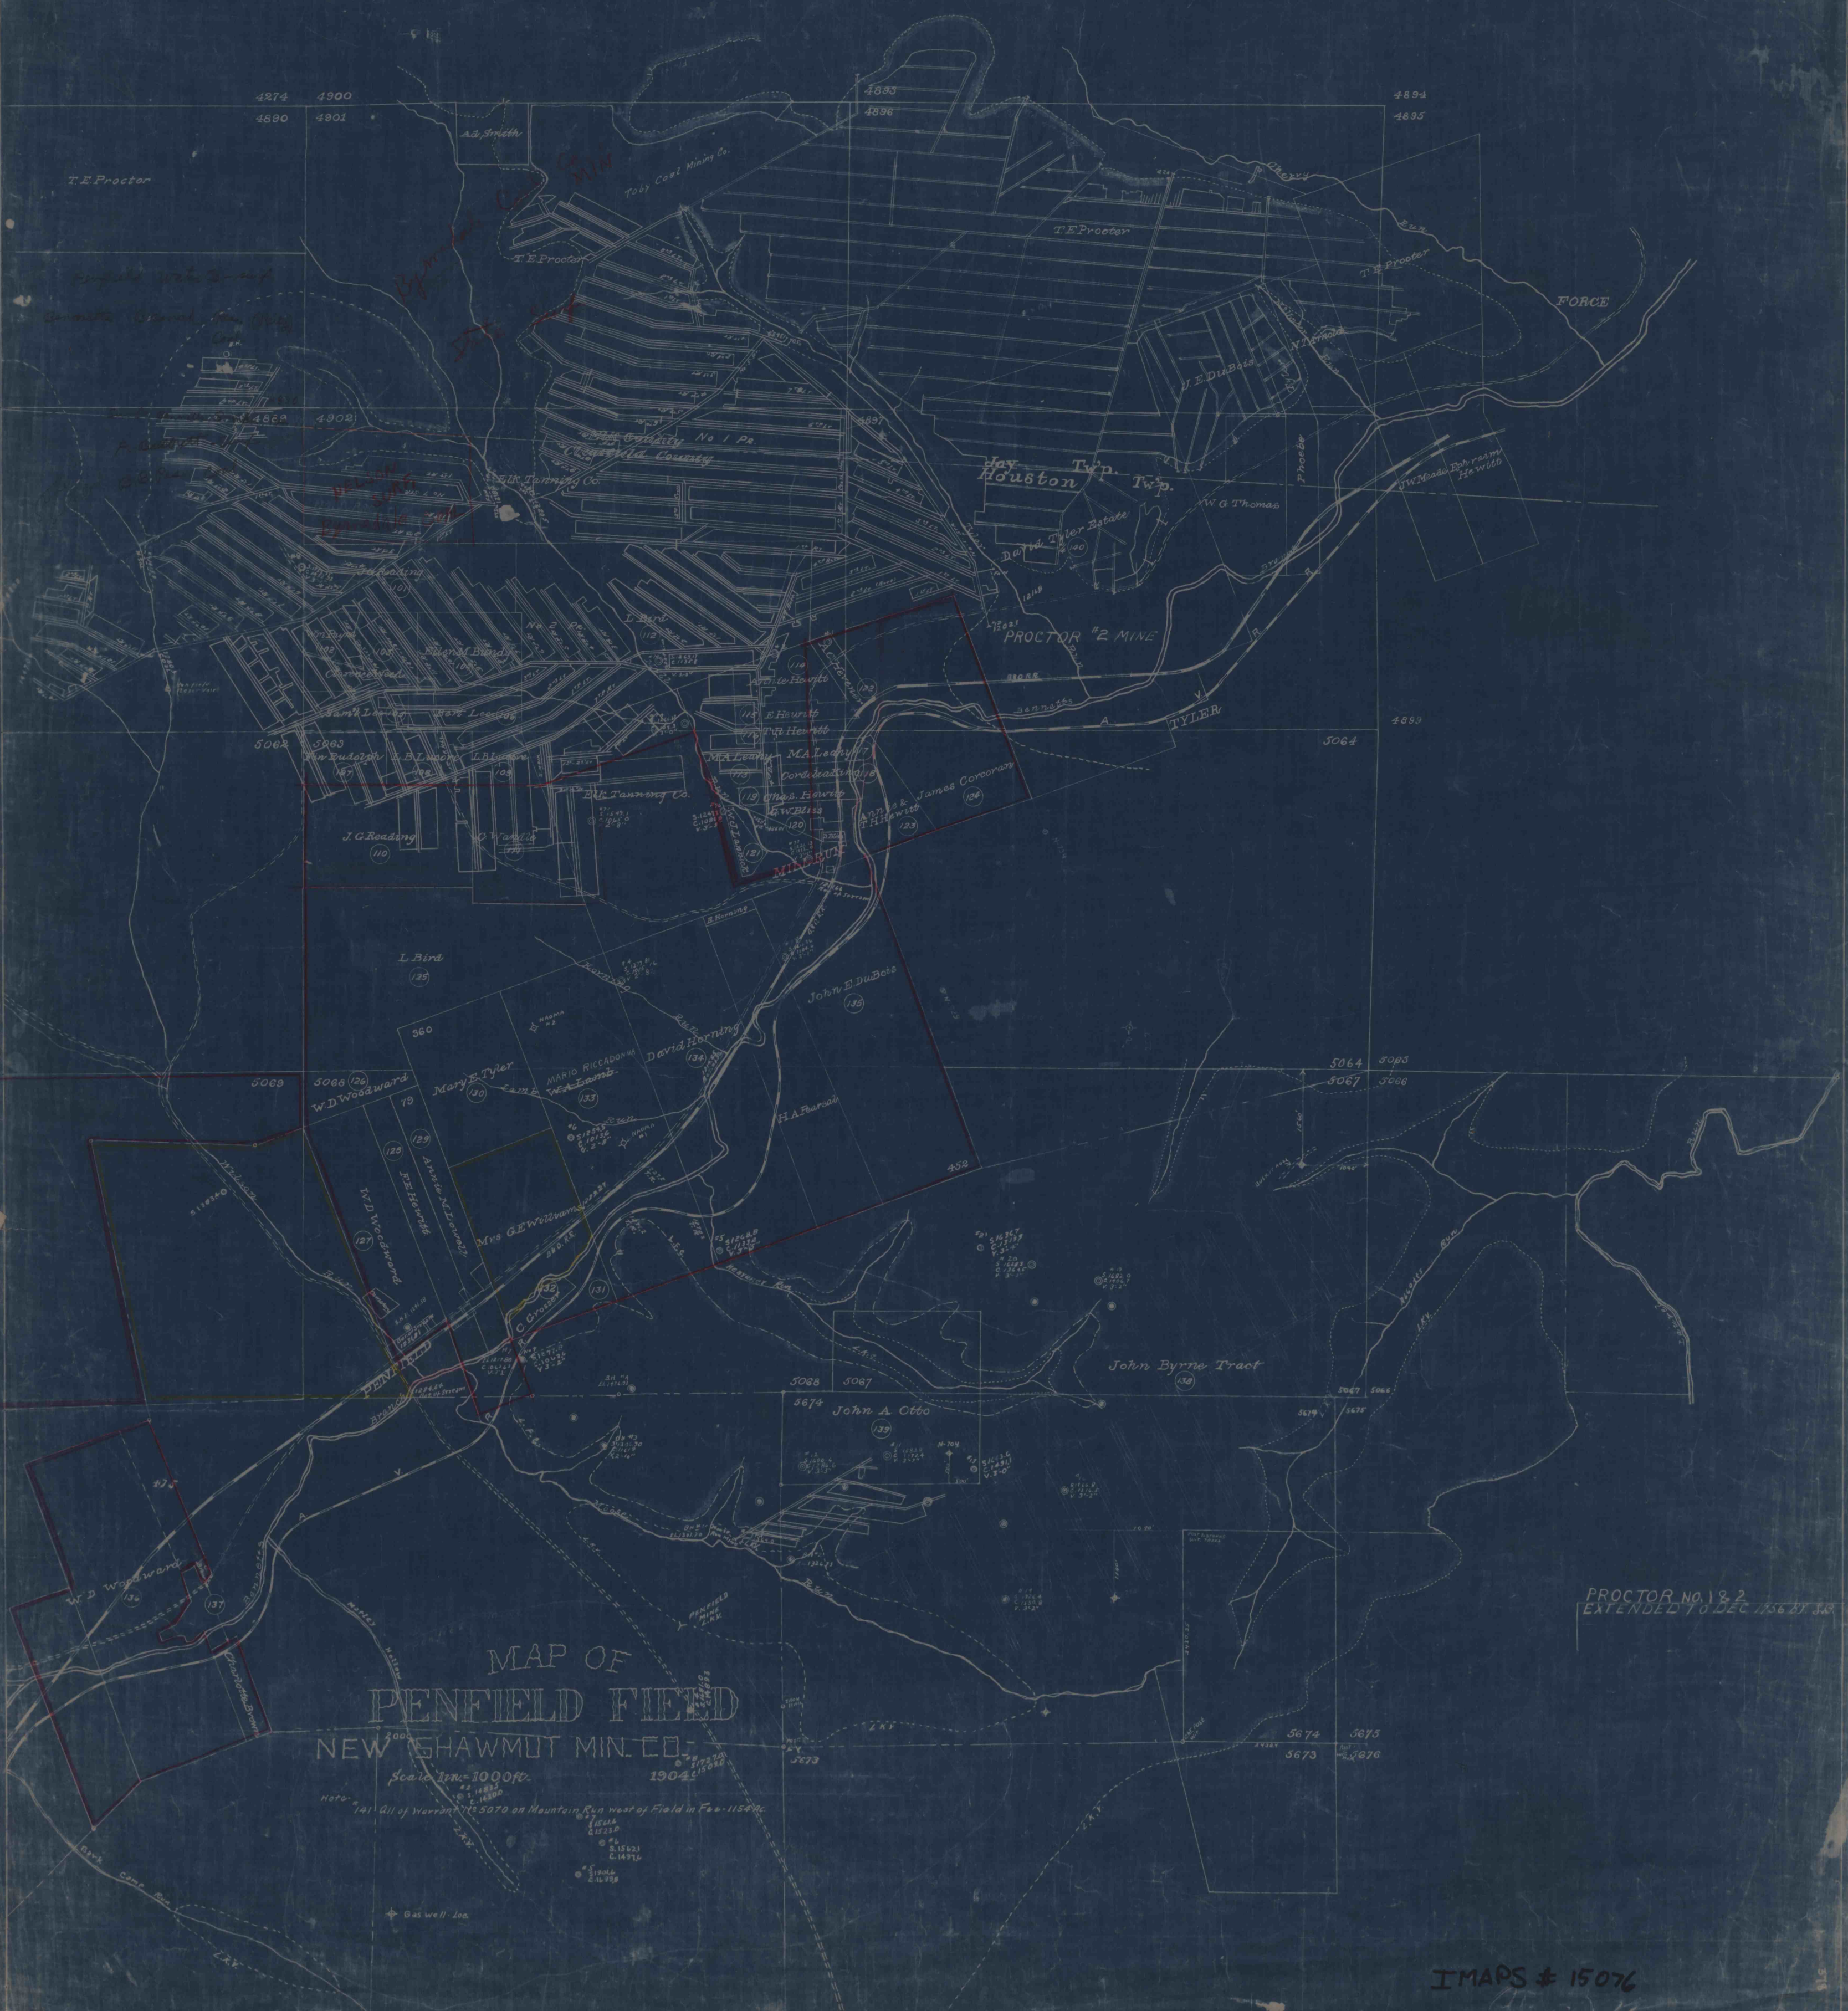

MAP OF
PENFIELD FIELD
NEW SHAWMUT MIN. CO.

Scale 1 in. = 1000 ft.

Note: "141" All of Warrant No. 5070 on Mountain Run west of Field in Feb. 1150 etc.

PROCTOR NO. 1 & 2
EXTENDED TO DEC. 1156 BY J.S.

IMAPS # 15076