


7176000
 6240000
 9360000
 3120000
 2600000
 5200000
 8600000

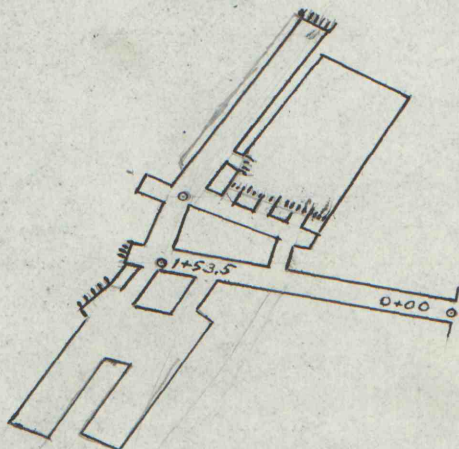

71

71

27"

IMAPS# 15077

CARMIN PARZIALE
 MINE
 COUNTY LINE.
 JAY & HUSTON.
 C. PARZIALE